T.3S. R.3W. Sec. 27 & 34, W.M.

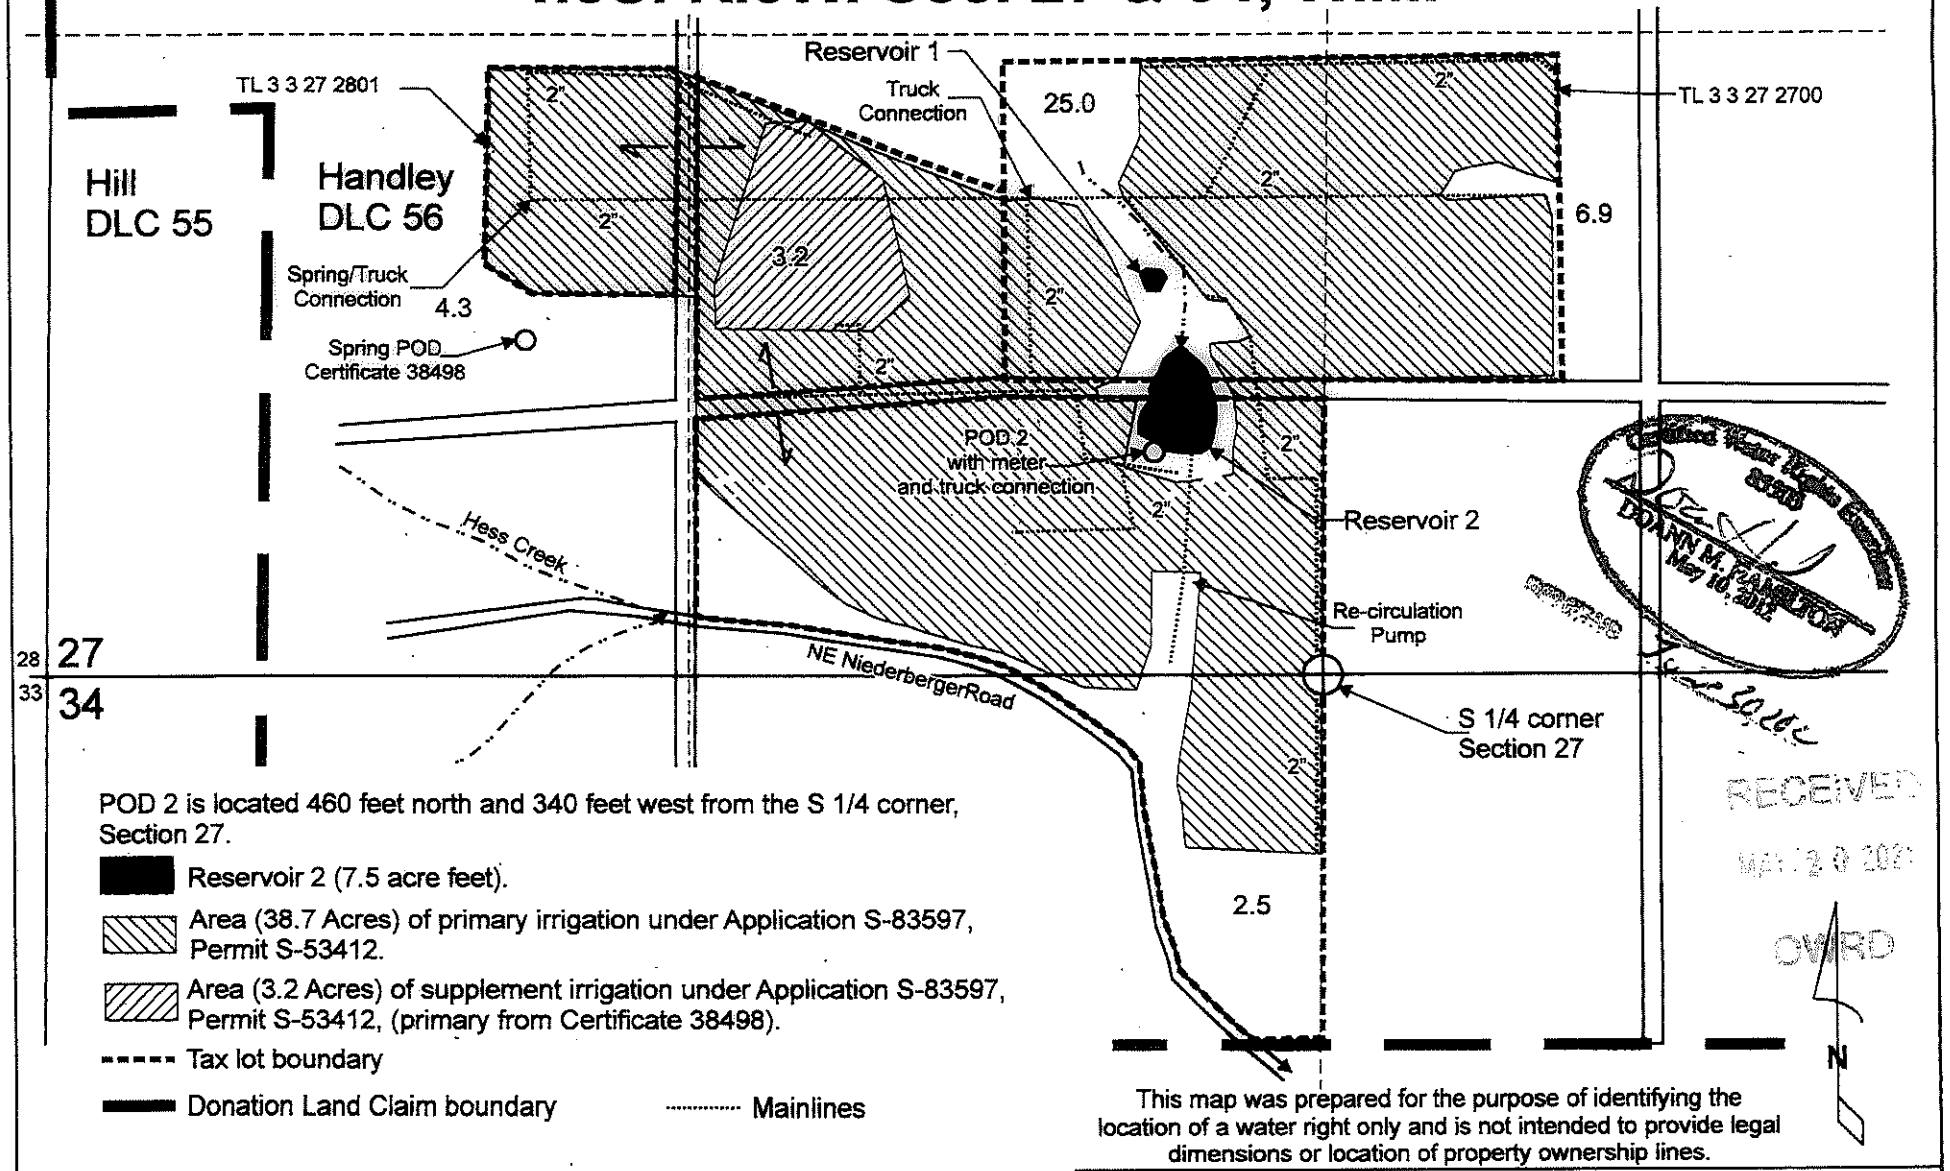

POD 2 is located 460 feet north and 340 feet west from the S 1/4 corner, Section 27.

- Reservoir 2 (7.5 acre feet).
- Area (38.7 Acres) of primary irrigation under Application S-83597, Permit S-53412.
- Area (3.2 Acres) of supplement irrigation under Application S-83597, Permit S-53412, (primary from Certificate 38498).
- Tax lot boundary
- Donation Land Claim boundary
- Mainlines

This map was prepared for the purpose of identifying the location of a water right only and is not intended to provide legal dimensions or location of property ownership lines.

Scale: 1" = 400'

0 400 800 Feet

Pacific Hydro-Geology Inc.

Claim of Beneficial Use Map
Application S-83597, Permit S-53412

Archery Summit Winery
T.3S. R.3W. Sec. 27 & 34, W.M.

05/2021

RECEIVED
MAY 20 2021
OWRD