


Three Sisters Irrigation District

Township 13 South, Range 12 East, W.M.

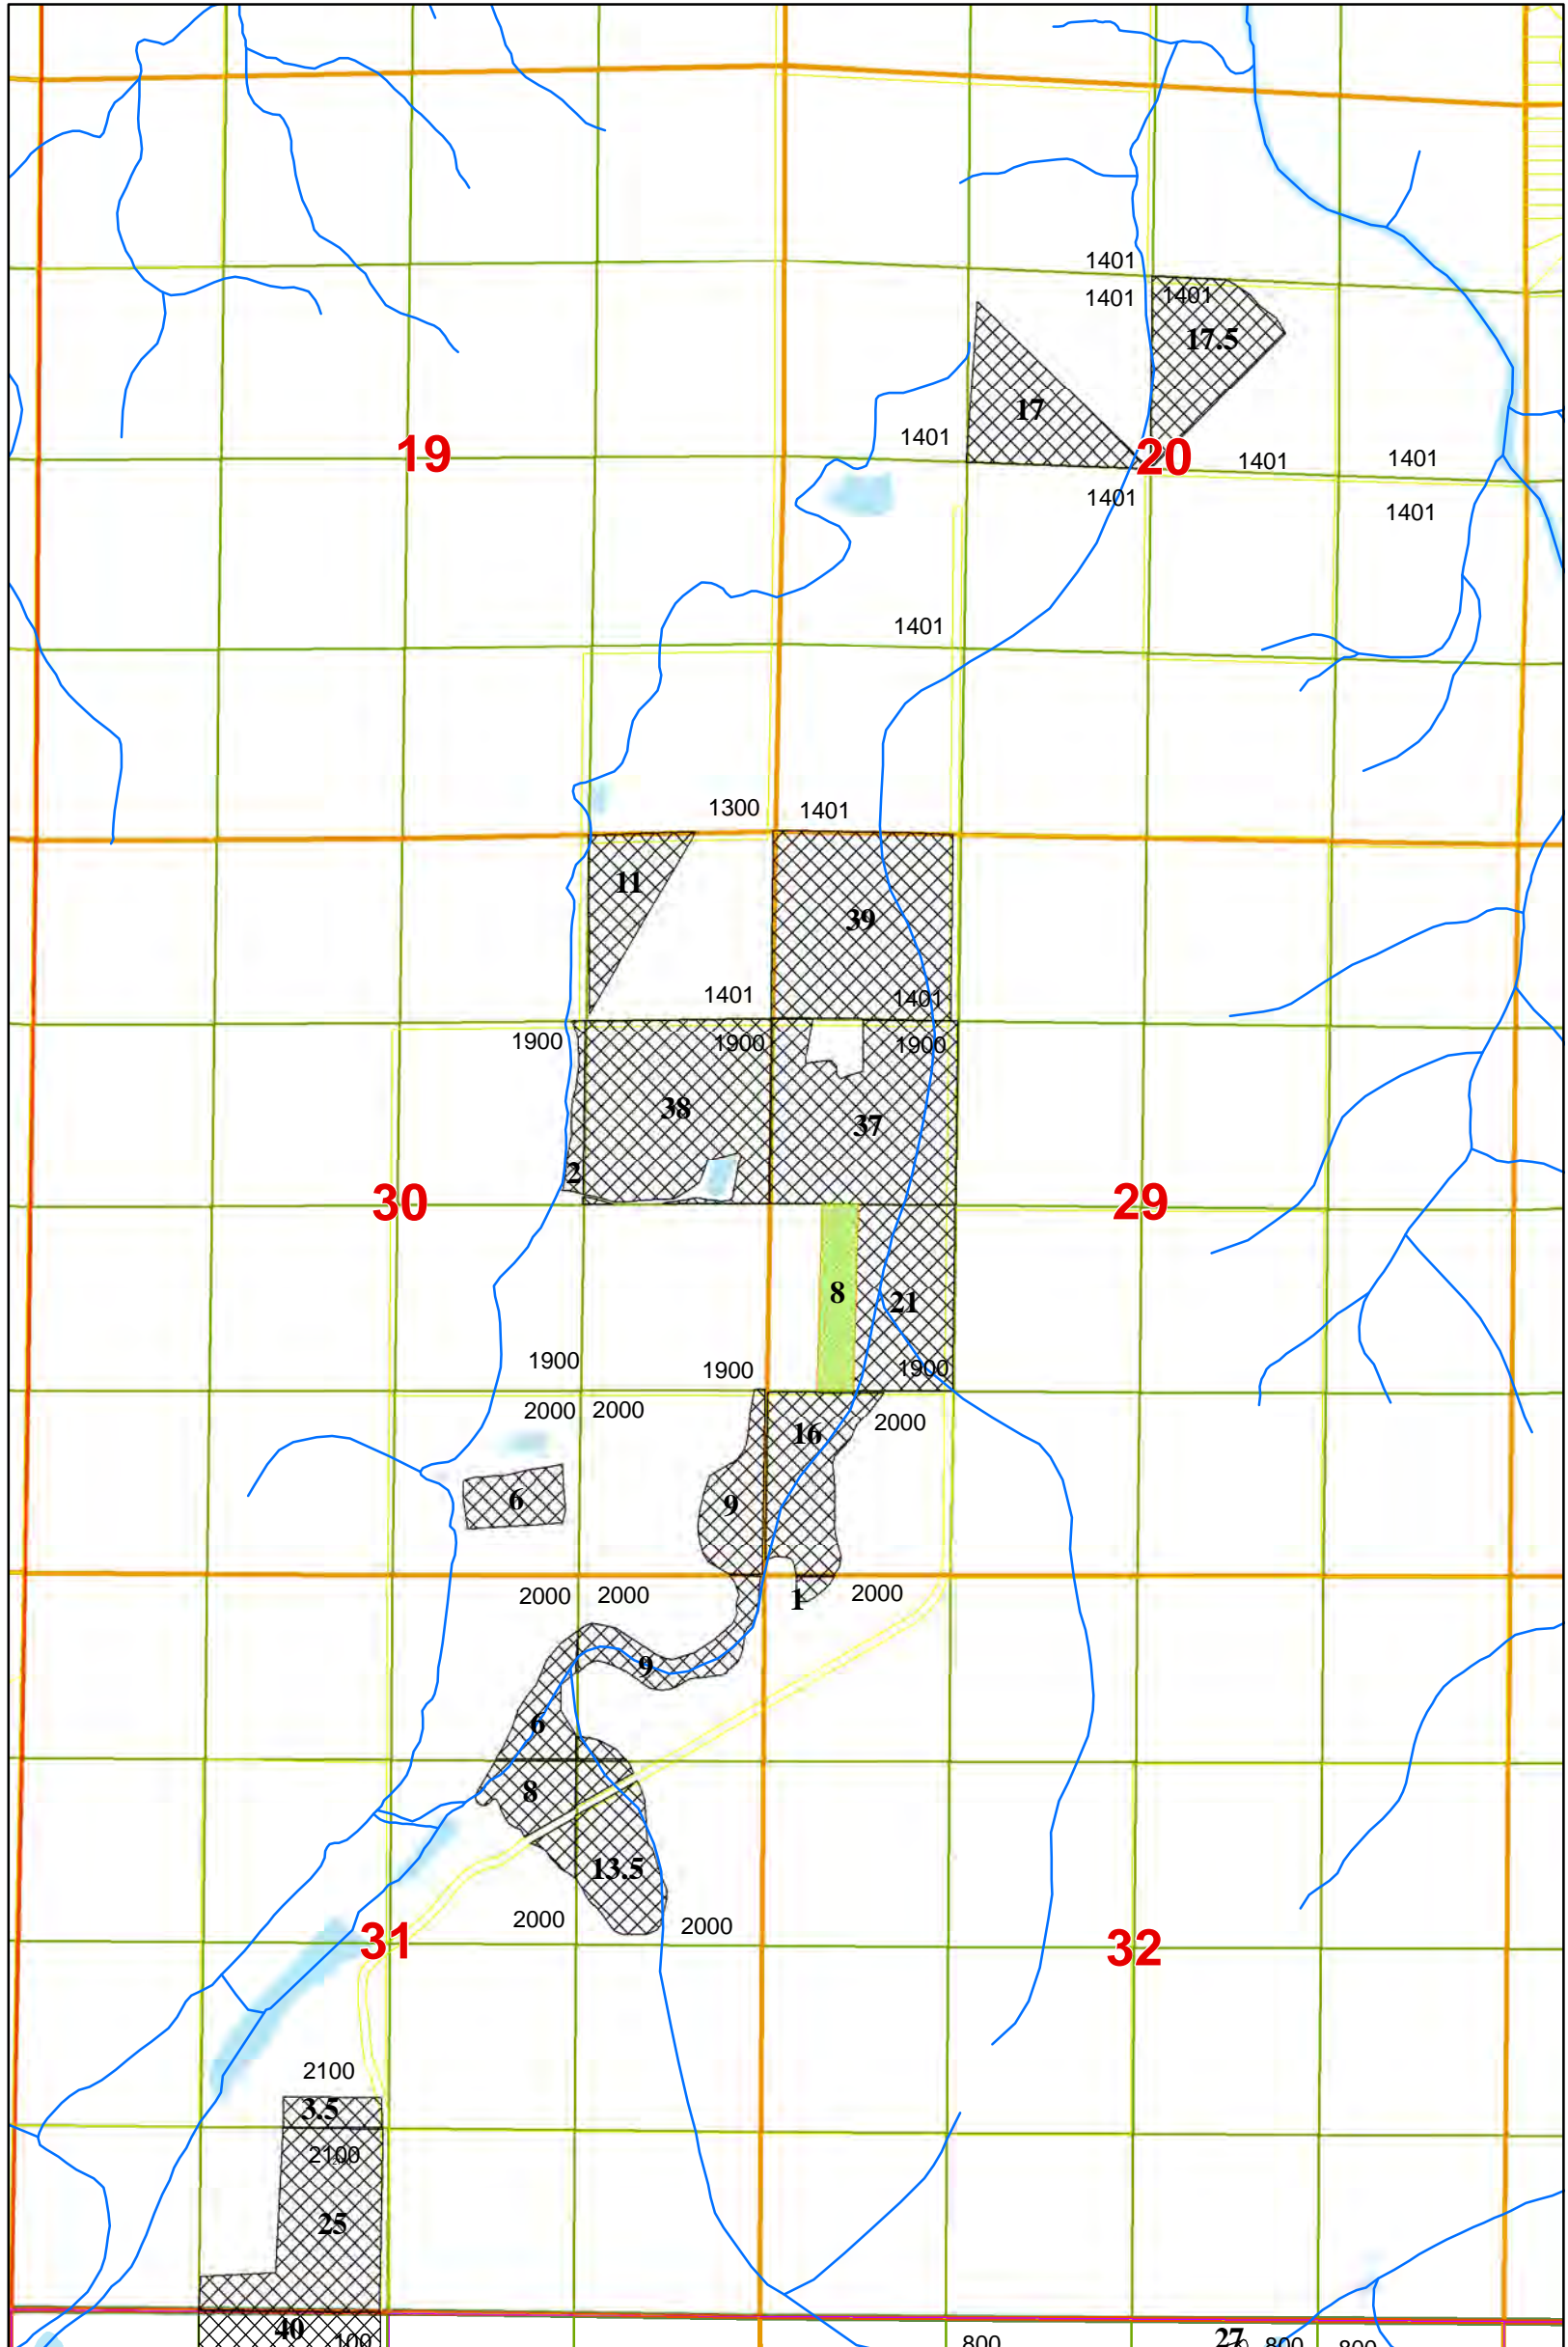

1 inch = 1,320 feet



This map is for the purpose of identifying the location of the water right. It is not intended to provide legal dimensions of locations of property ownership lines.

Supplemental Irrigation
Final Proof Map for Permit G-11375

mg_TSID_2019
supplemental rights:
 S 29312, G 11378
 G 11378

Well 1: 10 FEET SOUTH & 620 FEET WEST FROM THE E /14 CORNER OF SECTION 14, BEING WITHIN T15S R10E SEC 14, NESE, W.M.


Well 2: 40 FEET SOUTH & 1400 FEET WEST FROM THE E /14 CORNER OF SECTION 14 BEING WITHIN T15S R10E SEC 14, NWSE, W .M.

Three Sisters Irrigation District

Township 14 South, Range 11 East, W.M.



1 inch = 1,320 feet

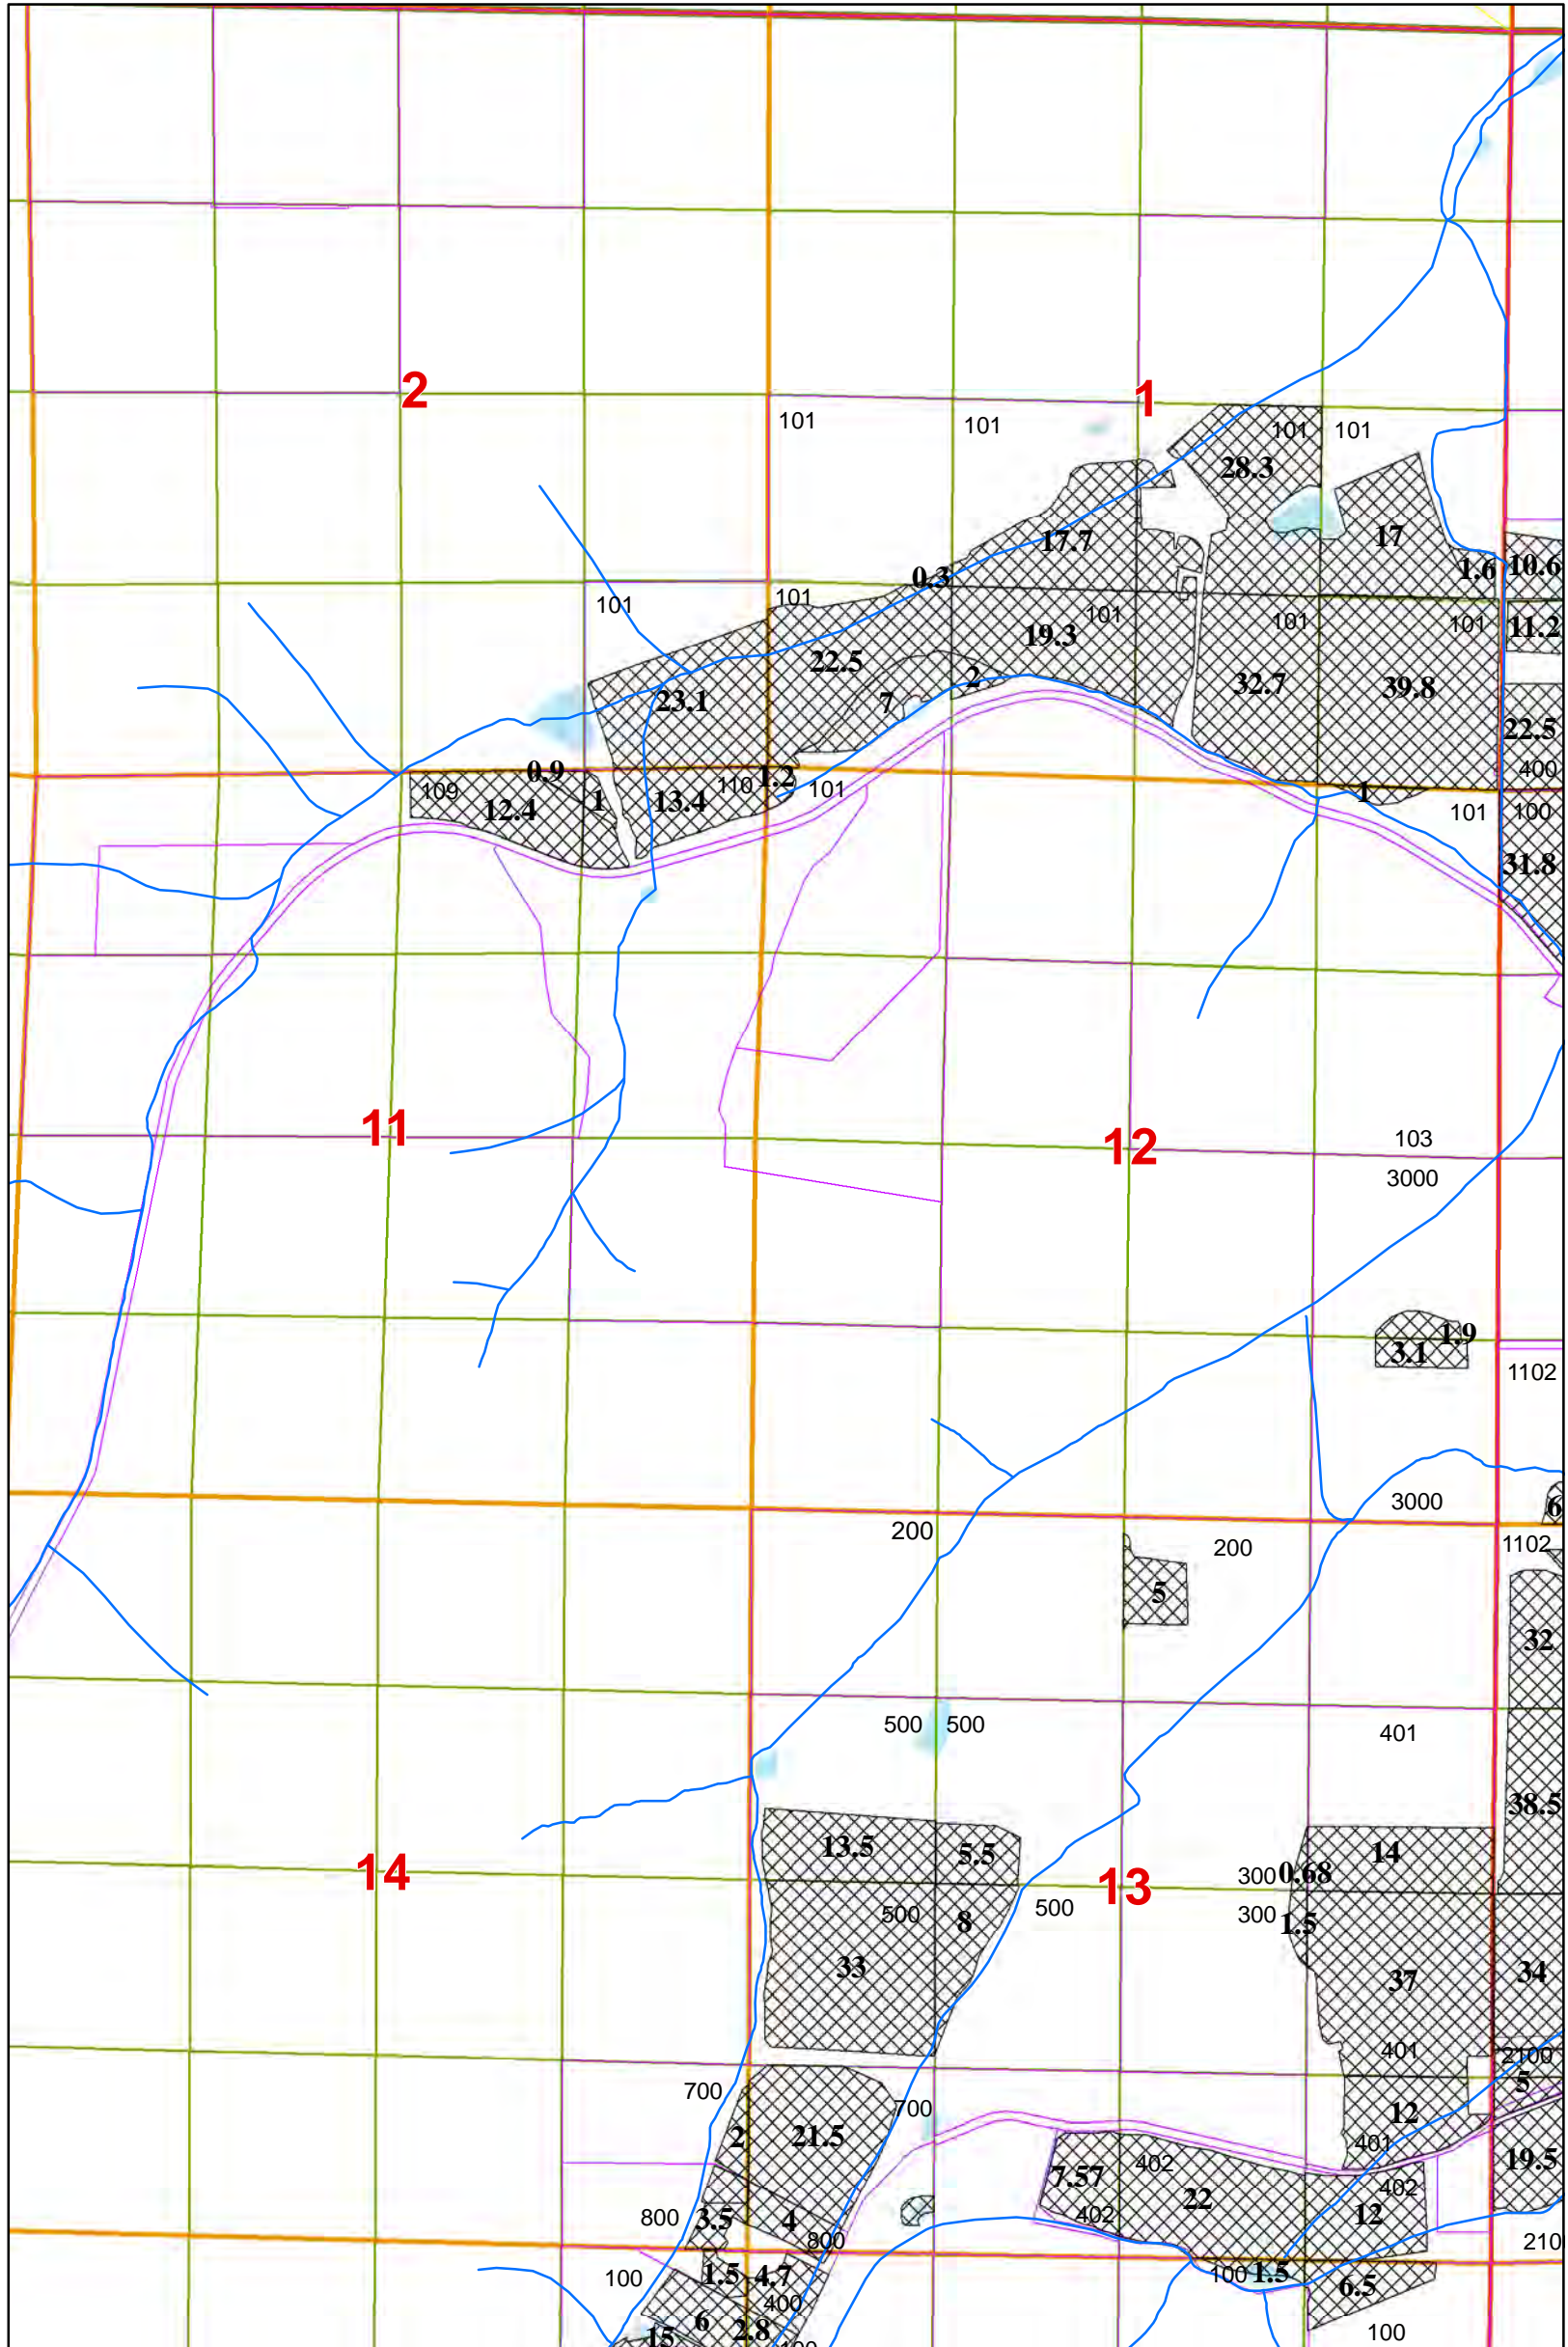

This map is for the purpose of identifying the location of the water right.
It is not intended to provide legal dimensions of locations of property ownership lines

Supplemental Irrigation
Final Proof Map for Permit G-11378

Well 1: 10 FEET SOUTH & 620 FEET WEST FROM THE E /14 CORNER OF SECTION 14, BEING WITHIN T15S R10E SEC 14, NESE, W.M.

Well 2: 40 FEET SOUTH & 1400 FEET WEST FROM THE E /14 CORNER OF SECTION 14 BEING WITHIN T15S R10E SEC 14, NWSE, W.M.


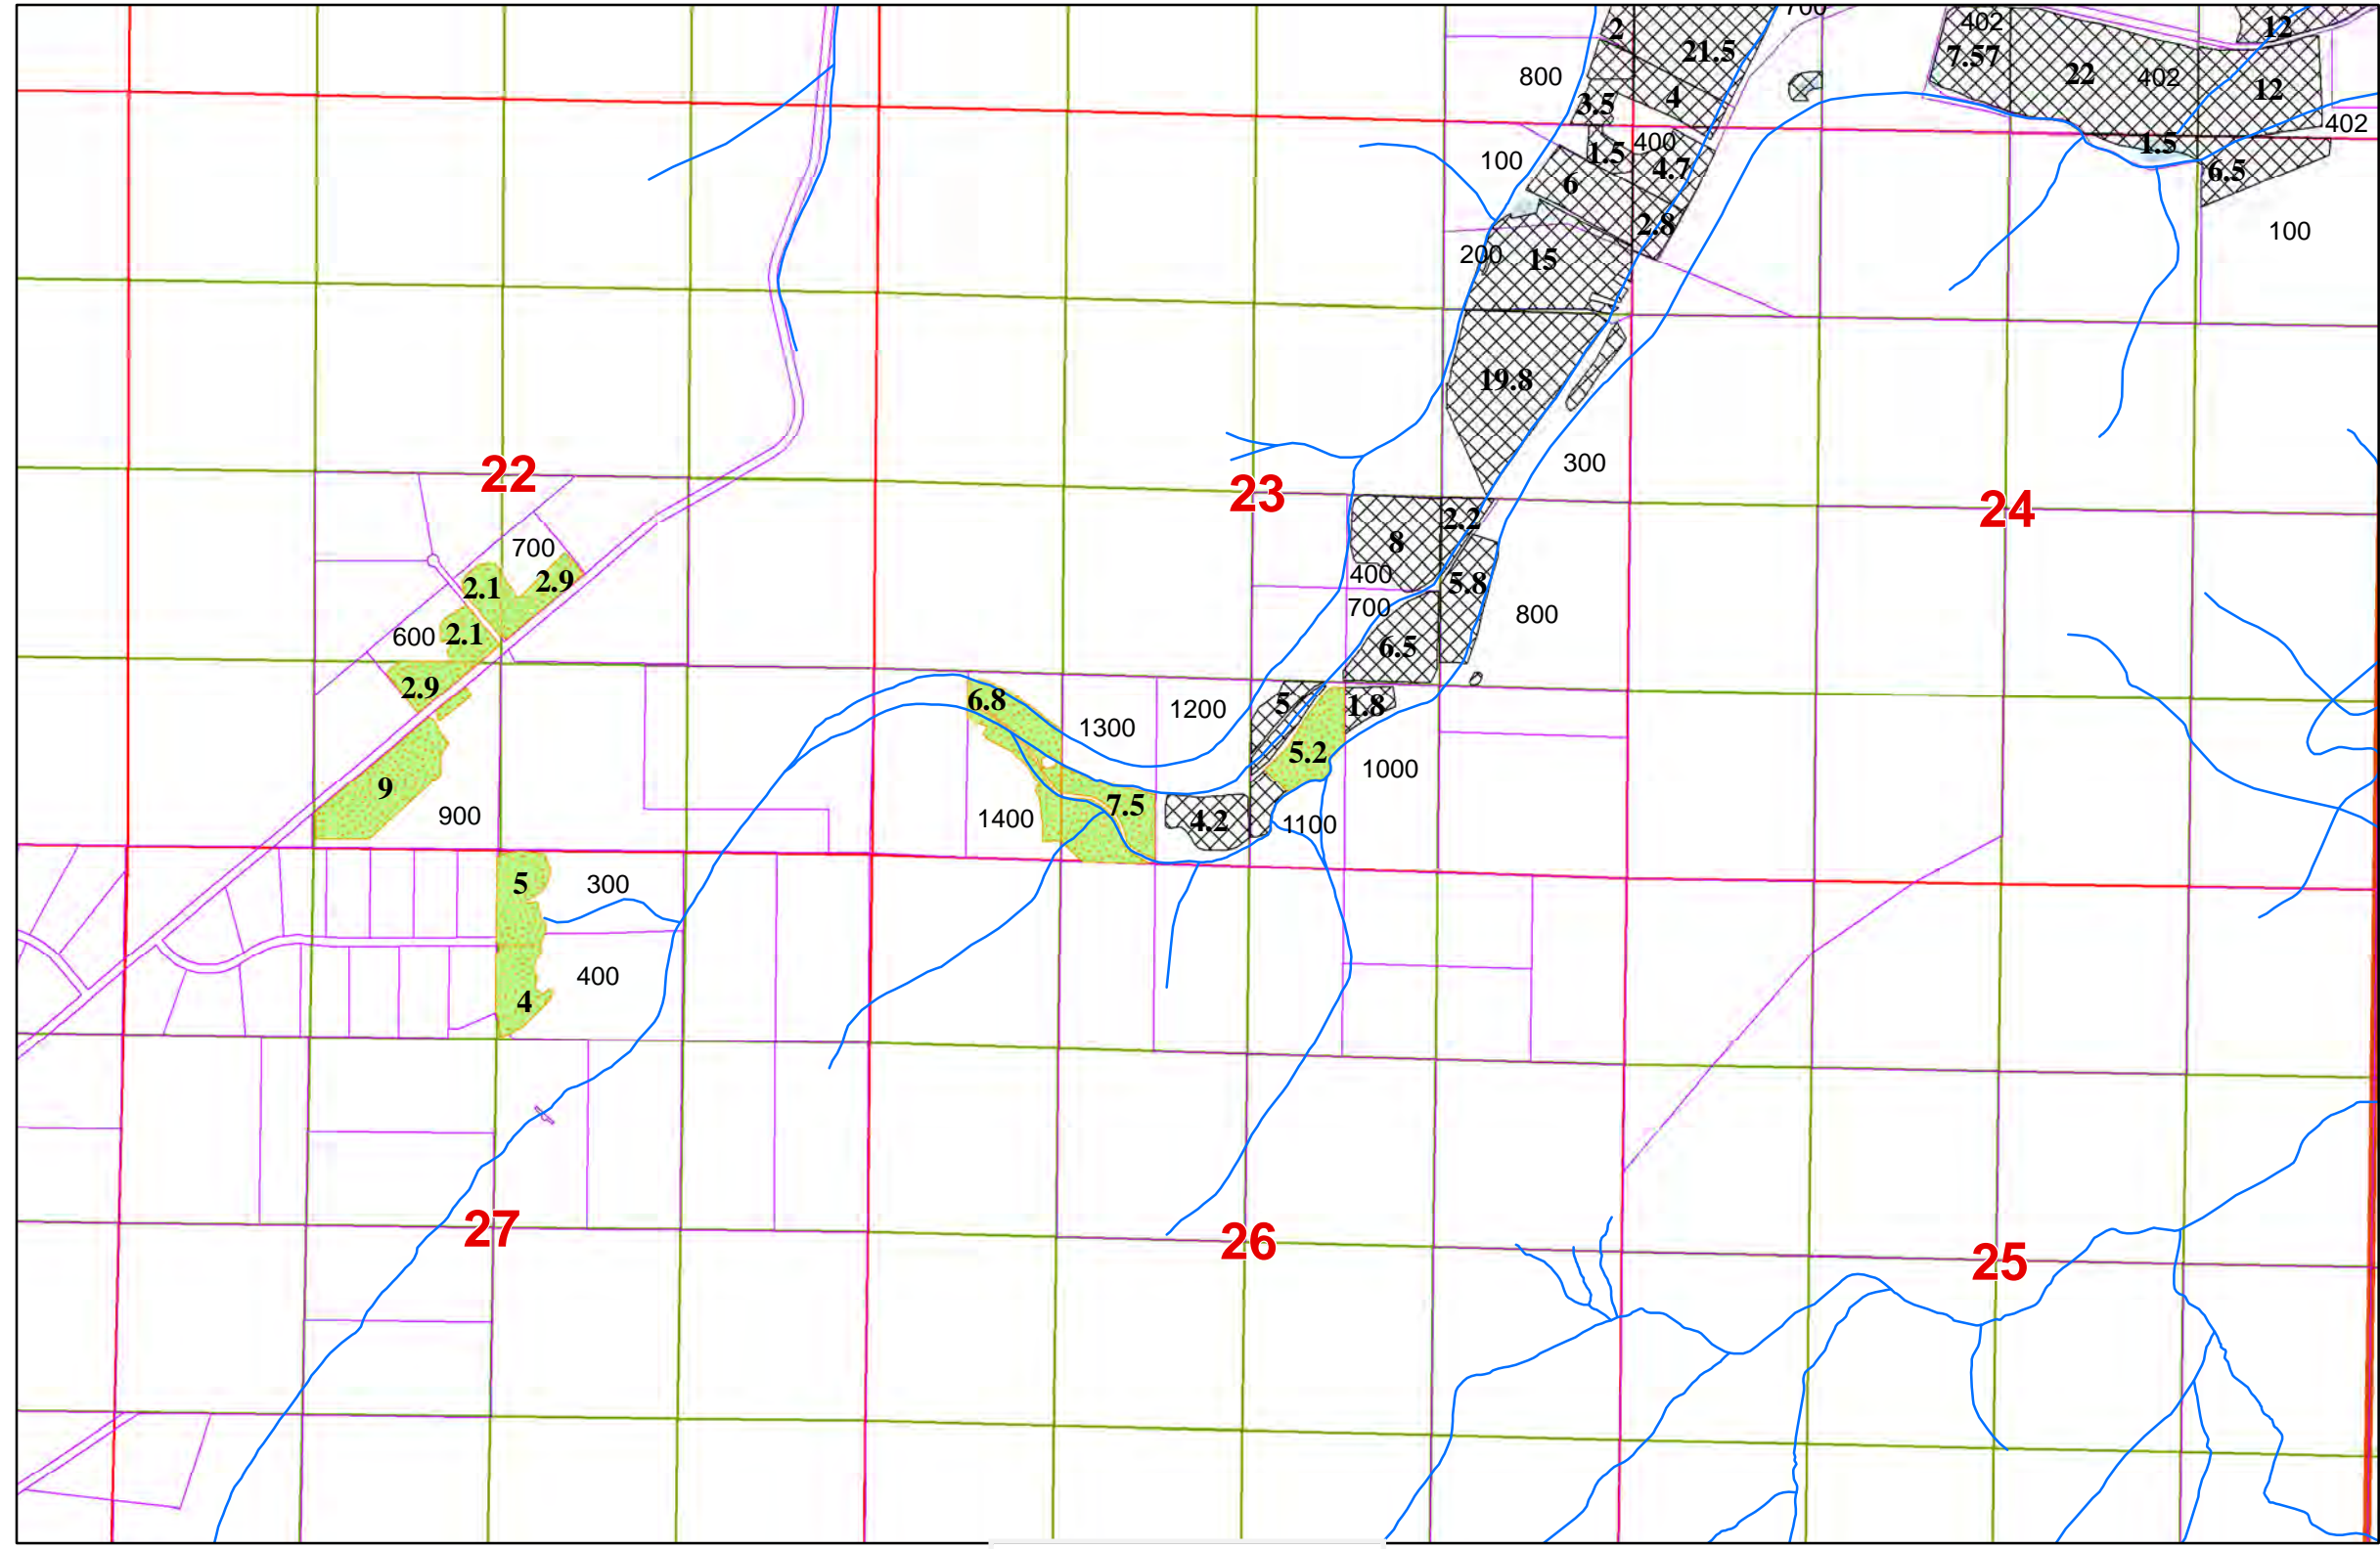
mg_TSID_2019

supplemental rights:

S 29312, G 11378



Three Sisters Irrigation District Township 14 South, Range 11 East, W.M.

1 inch = 1,320 feet

This map is for the purpose of identifying the location of the water right.
It is not intended to provide legal dimensions of locations of property ownership lines.

Supplemental Irrigation
Final Proof Map for Permit G-11378


supplemental rights:
 S 29312, G 11378
 G 11378

Well 1: 10 FEET SOUTH & 620 FEET WEST FROM THE E /14 CORNER OF SECTION 14, BEING WITHIN T15S R10E SEC 14, NESE, W.M.

Well 2: 40 FEET SOUTH & 1400 FEET WEST FROM THE E /14 CORNER OF SECTION 14 BEING WITHIN T15S R10E SEC 14, NWSE, W .M.

Three Sisters Irrigation District Township 14 South, Ranges 10 and 11 East, W.M.

1 inch = 1,320 feet

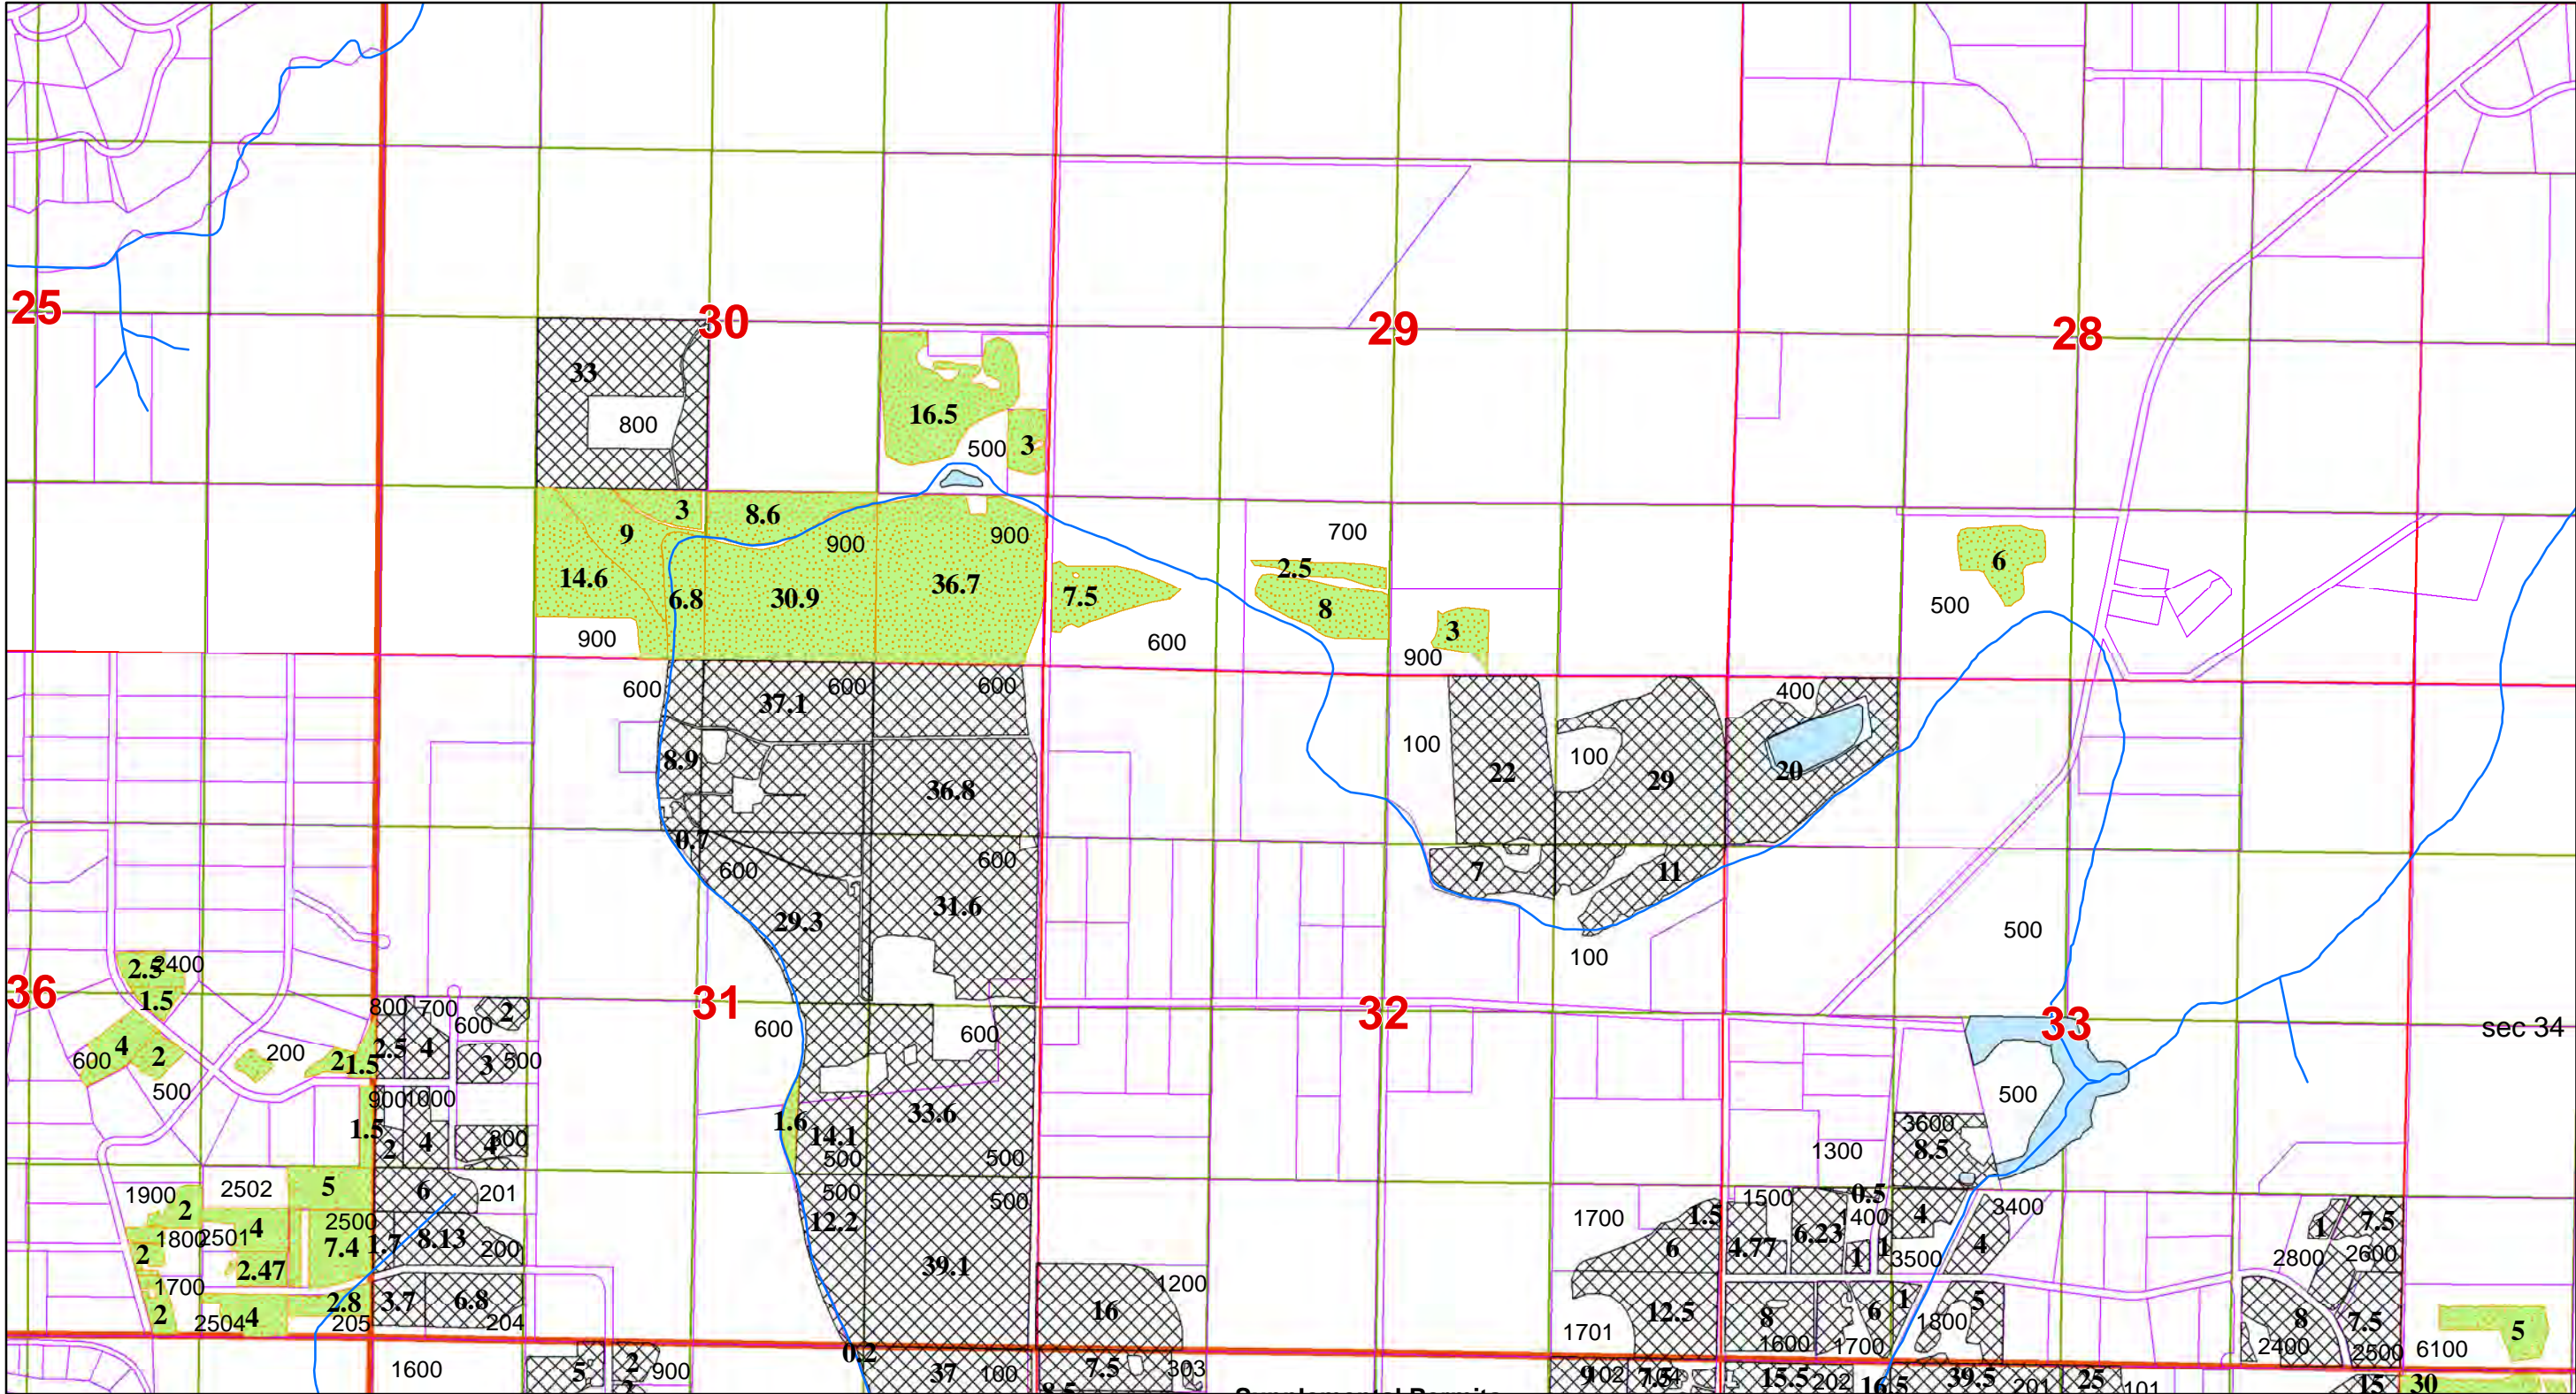

This map is for the purpose of identifying the location of the water right.
It is not intended to provide legal dimensions of locations of property ownership lines.

Supplemental Irrigation
Final Proof Map for Permit G-11378

supplemental rights:

- S 29312, G 11378
- G 11378
- Ponds

Well 1: 10 FEET SOUTH & 620 FEET WEST FROM THE E /14 CORNER OF SECTION 14,
BEING WITHIN T15S R10E SEC 14, NESE, W.M.


Well 2: 40 FEET SOUTH & 1400 FEET WEST FROM THE E /14 CORNER OF SECTION 14,
BEING WITHIN T15S R10E SEC 14, NWSE, W.M.

Three Sisters Irrigation District

Township 14 South, Range 12 East, W.M.



1 inch = 1,320 feet

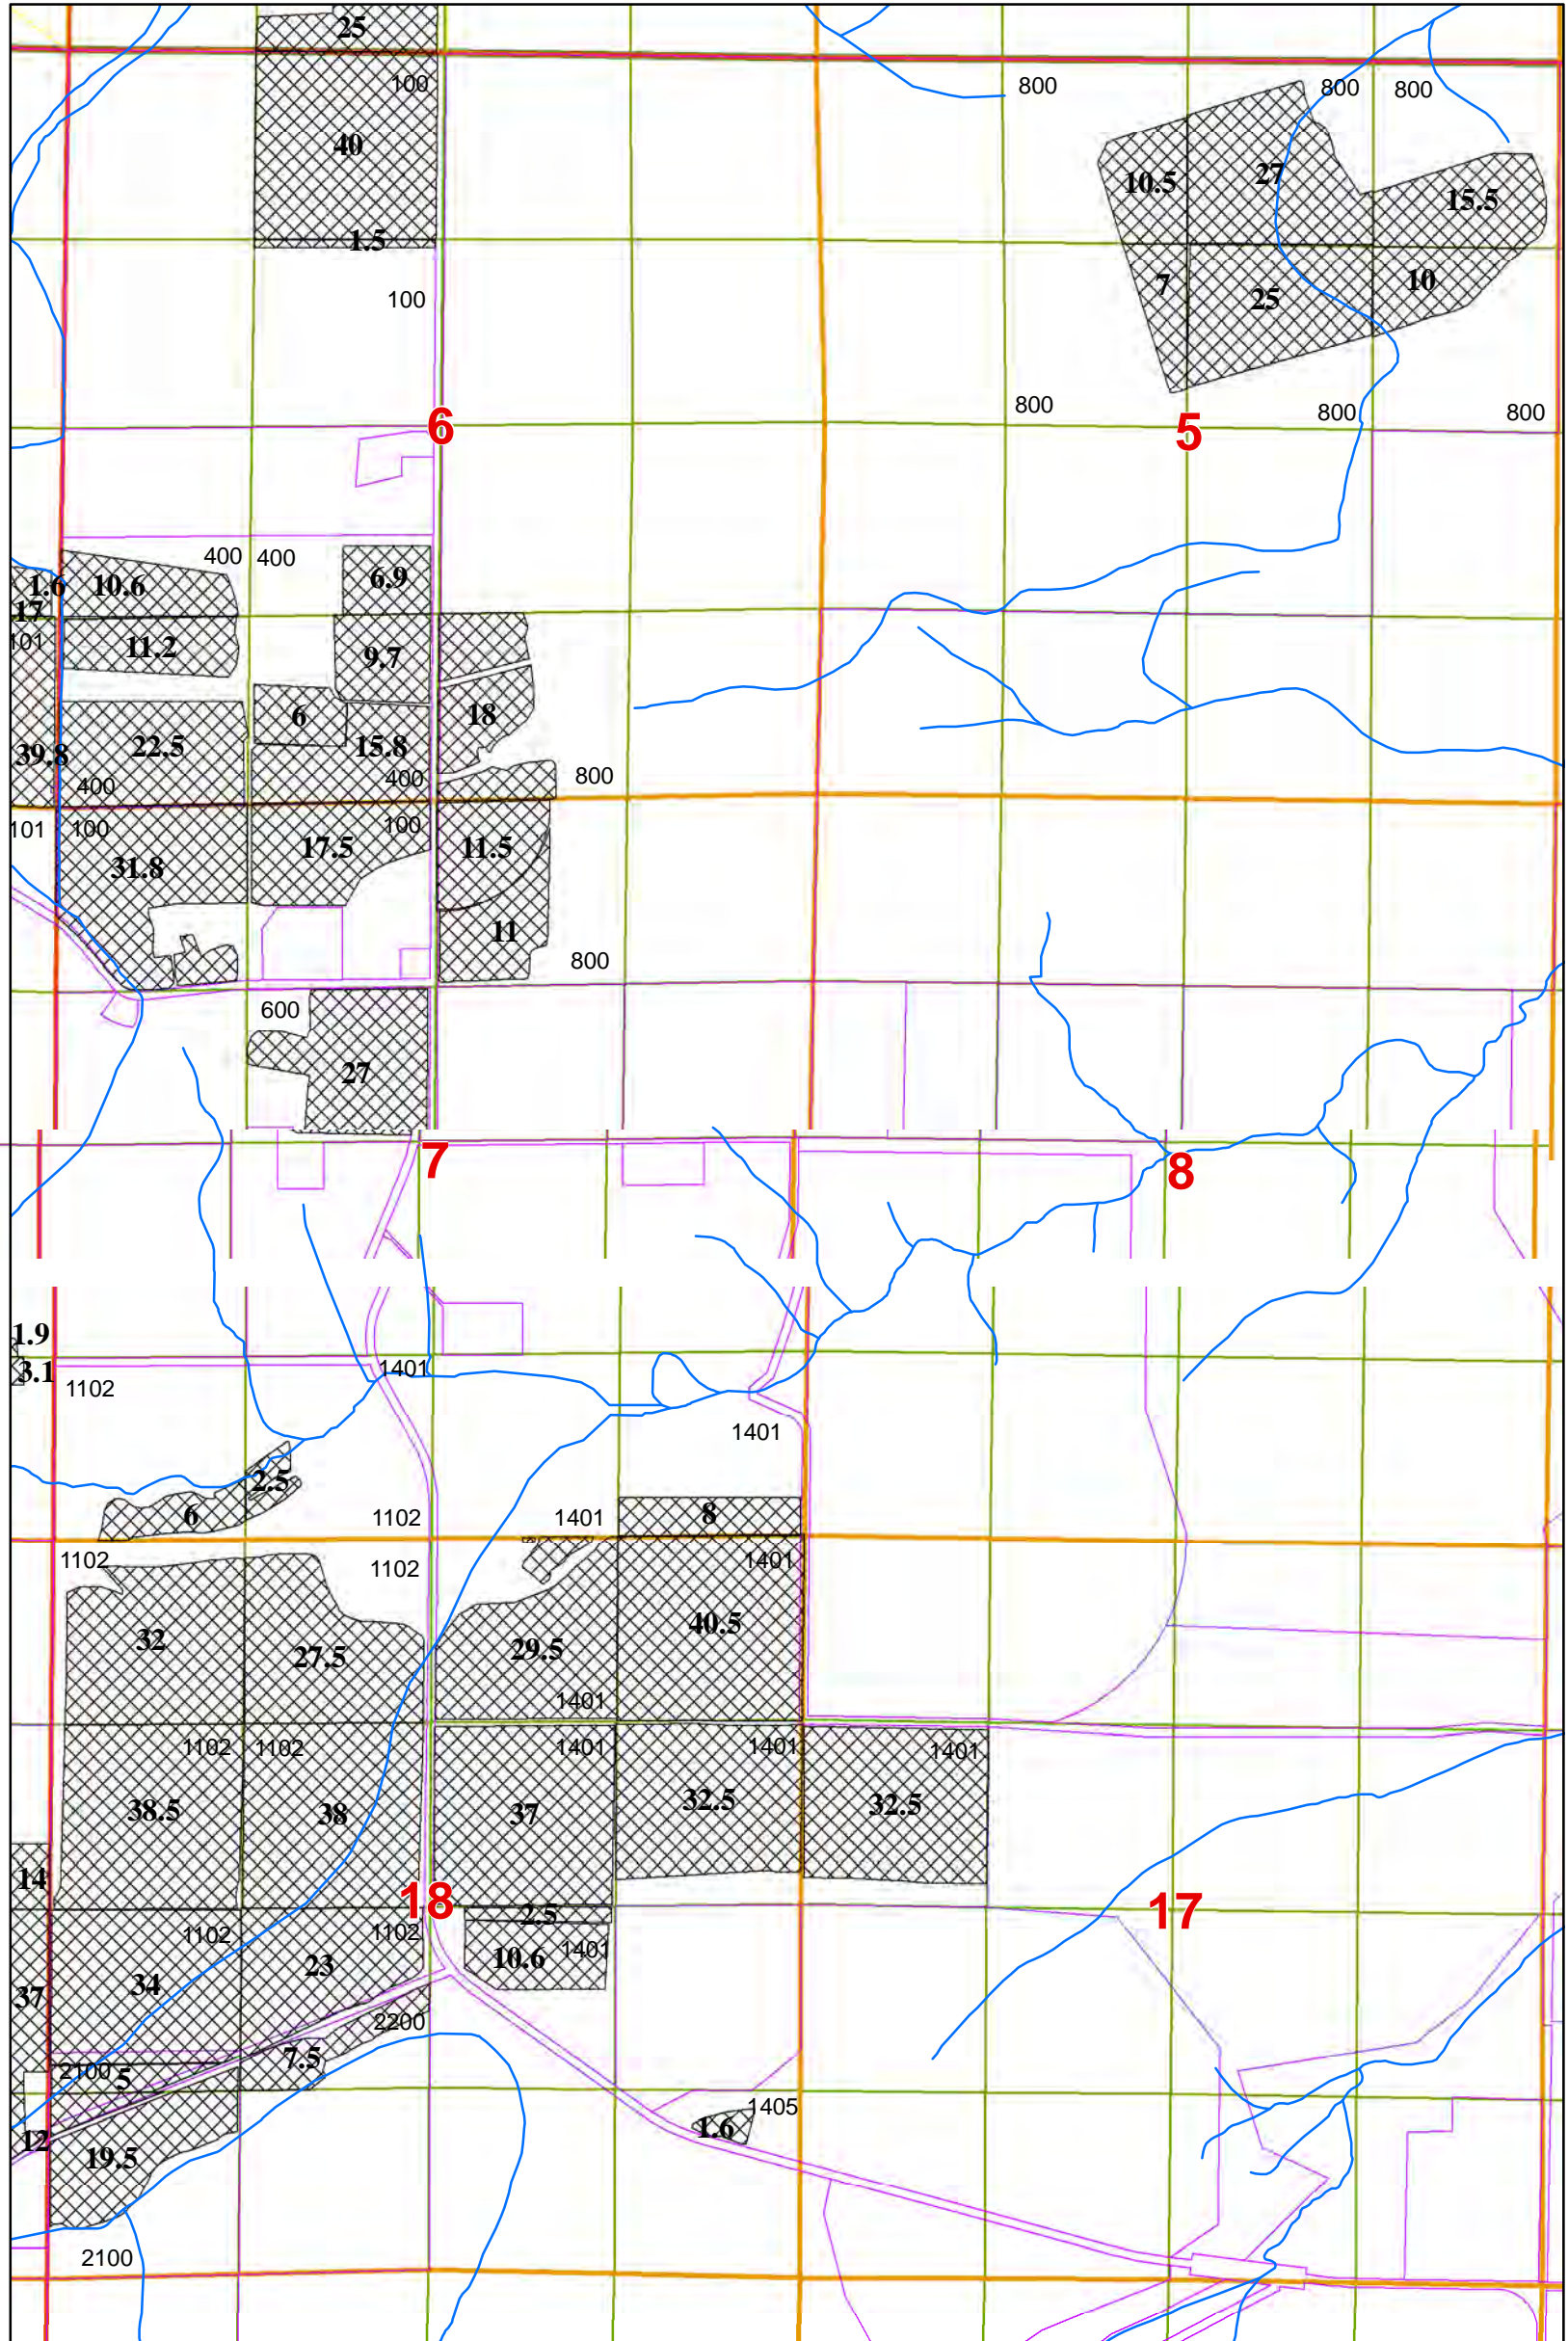

This map is for the purpose of identifying the location of the water right.
It is not intended to provide legal dimensions of locations of property ownership lines.

Supplemental Irrigation Final Proof Map for Permit G-11378

mg_TSID_2019
supplemental rights:


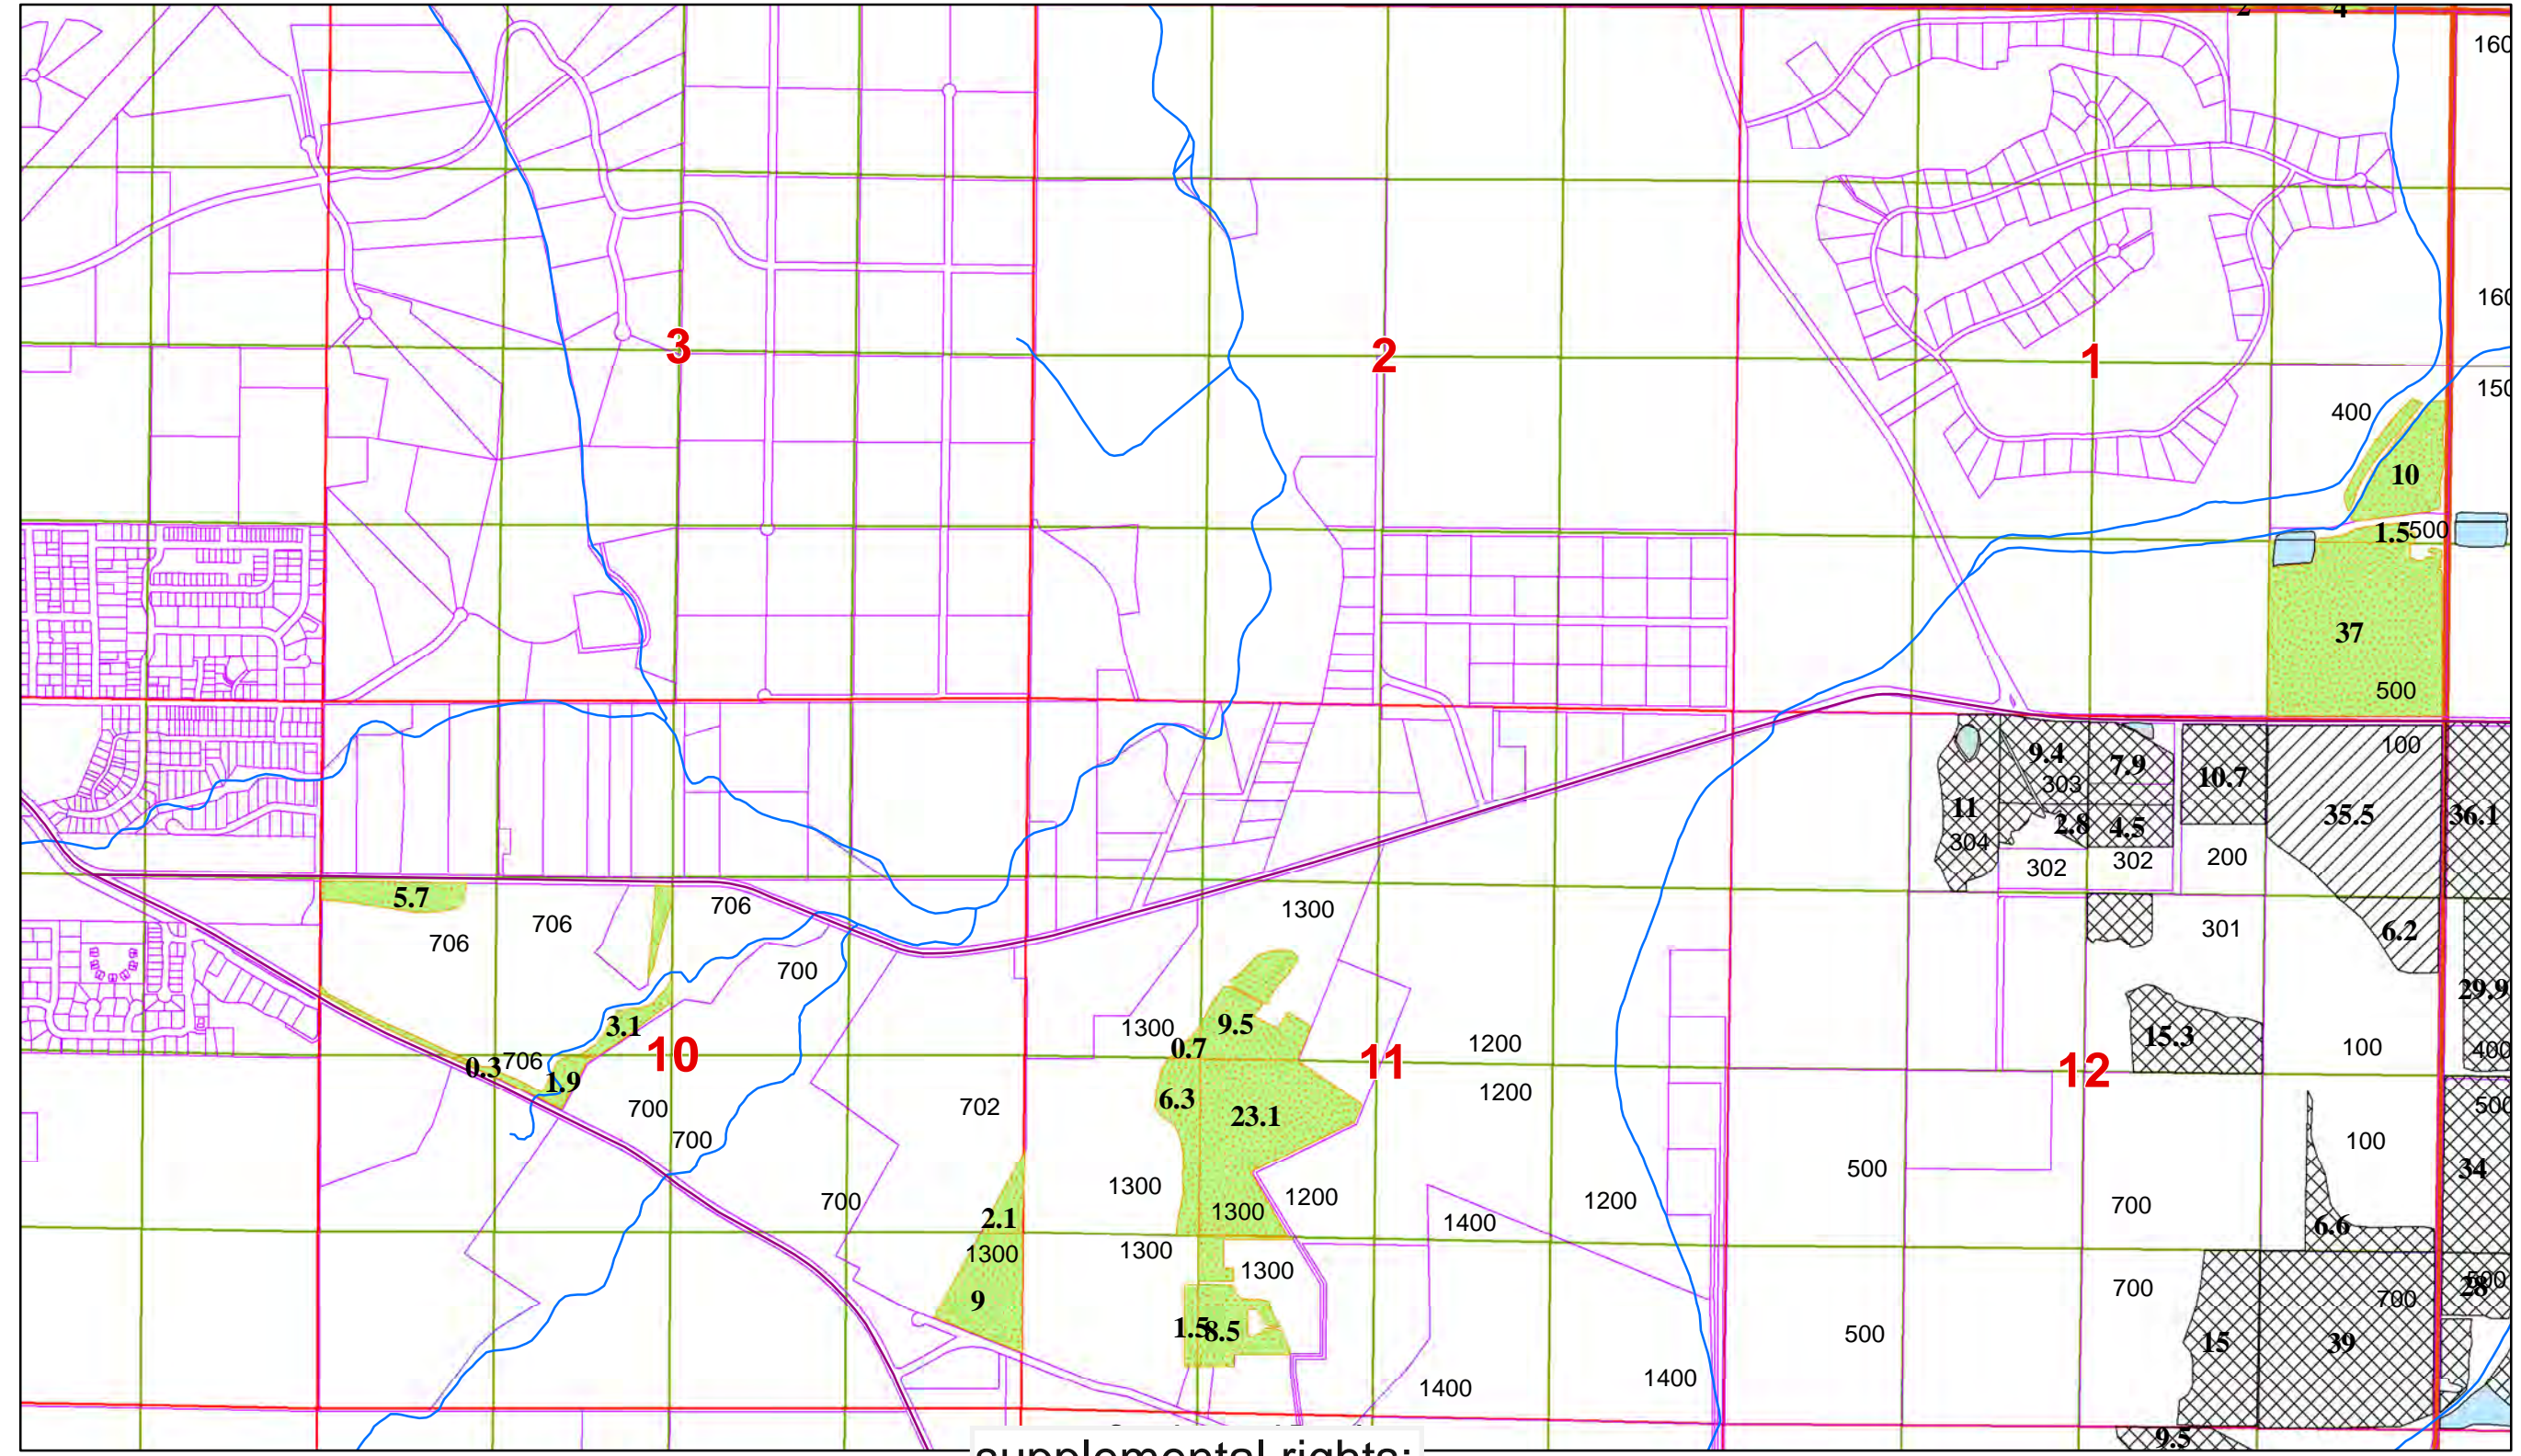
Well 1: 10 FEET SOUTH & 620 FEET WEST FROM THE E /14 CORNER OF SECTION 14,
BEING WITHIN T15S R10E SEC 14, NESE, W.M.

S 29312, G 11378

Well 2: 40 FEET SOUTH & 1400 FEET WEST FROM THE E /14 CORNER OF SECTION 14
BEING WITHIN T15S R10E SEC 14, NWSE, W.M.

Three Sisters Irrigation District Township 15 South, Range 10 East, W.M.





1 inch = 1,320 feet

supplemental rights:

This map is for the purpose of identifying the location of the water right.
It is not intended to provide legal dimensions of locations of property ownership lines.

Supplemental Irrigation
Final Proof Map for Permit G-11378


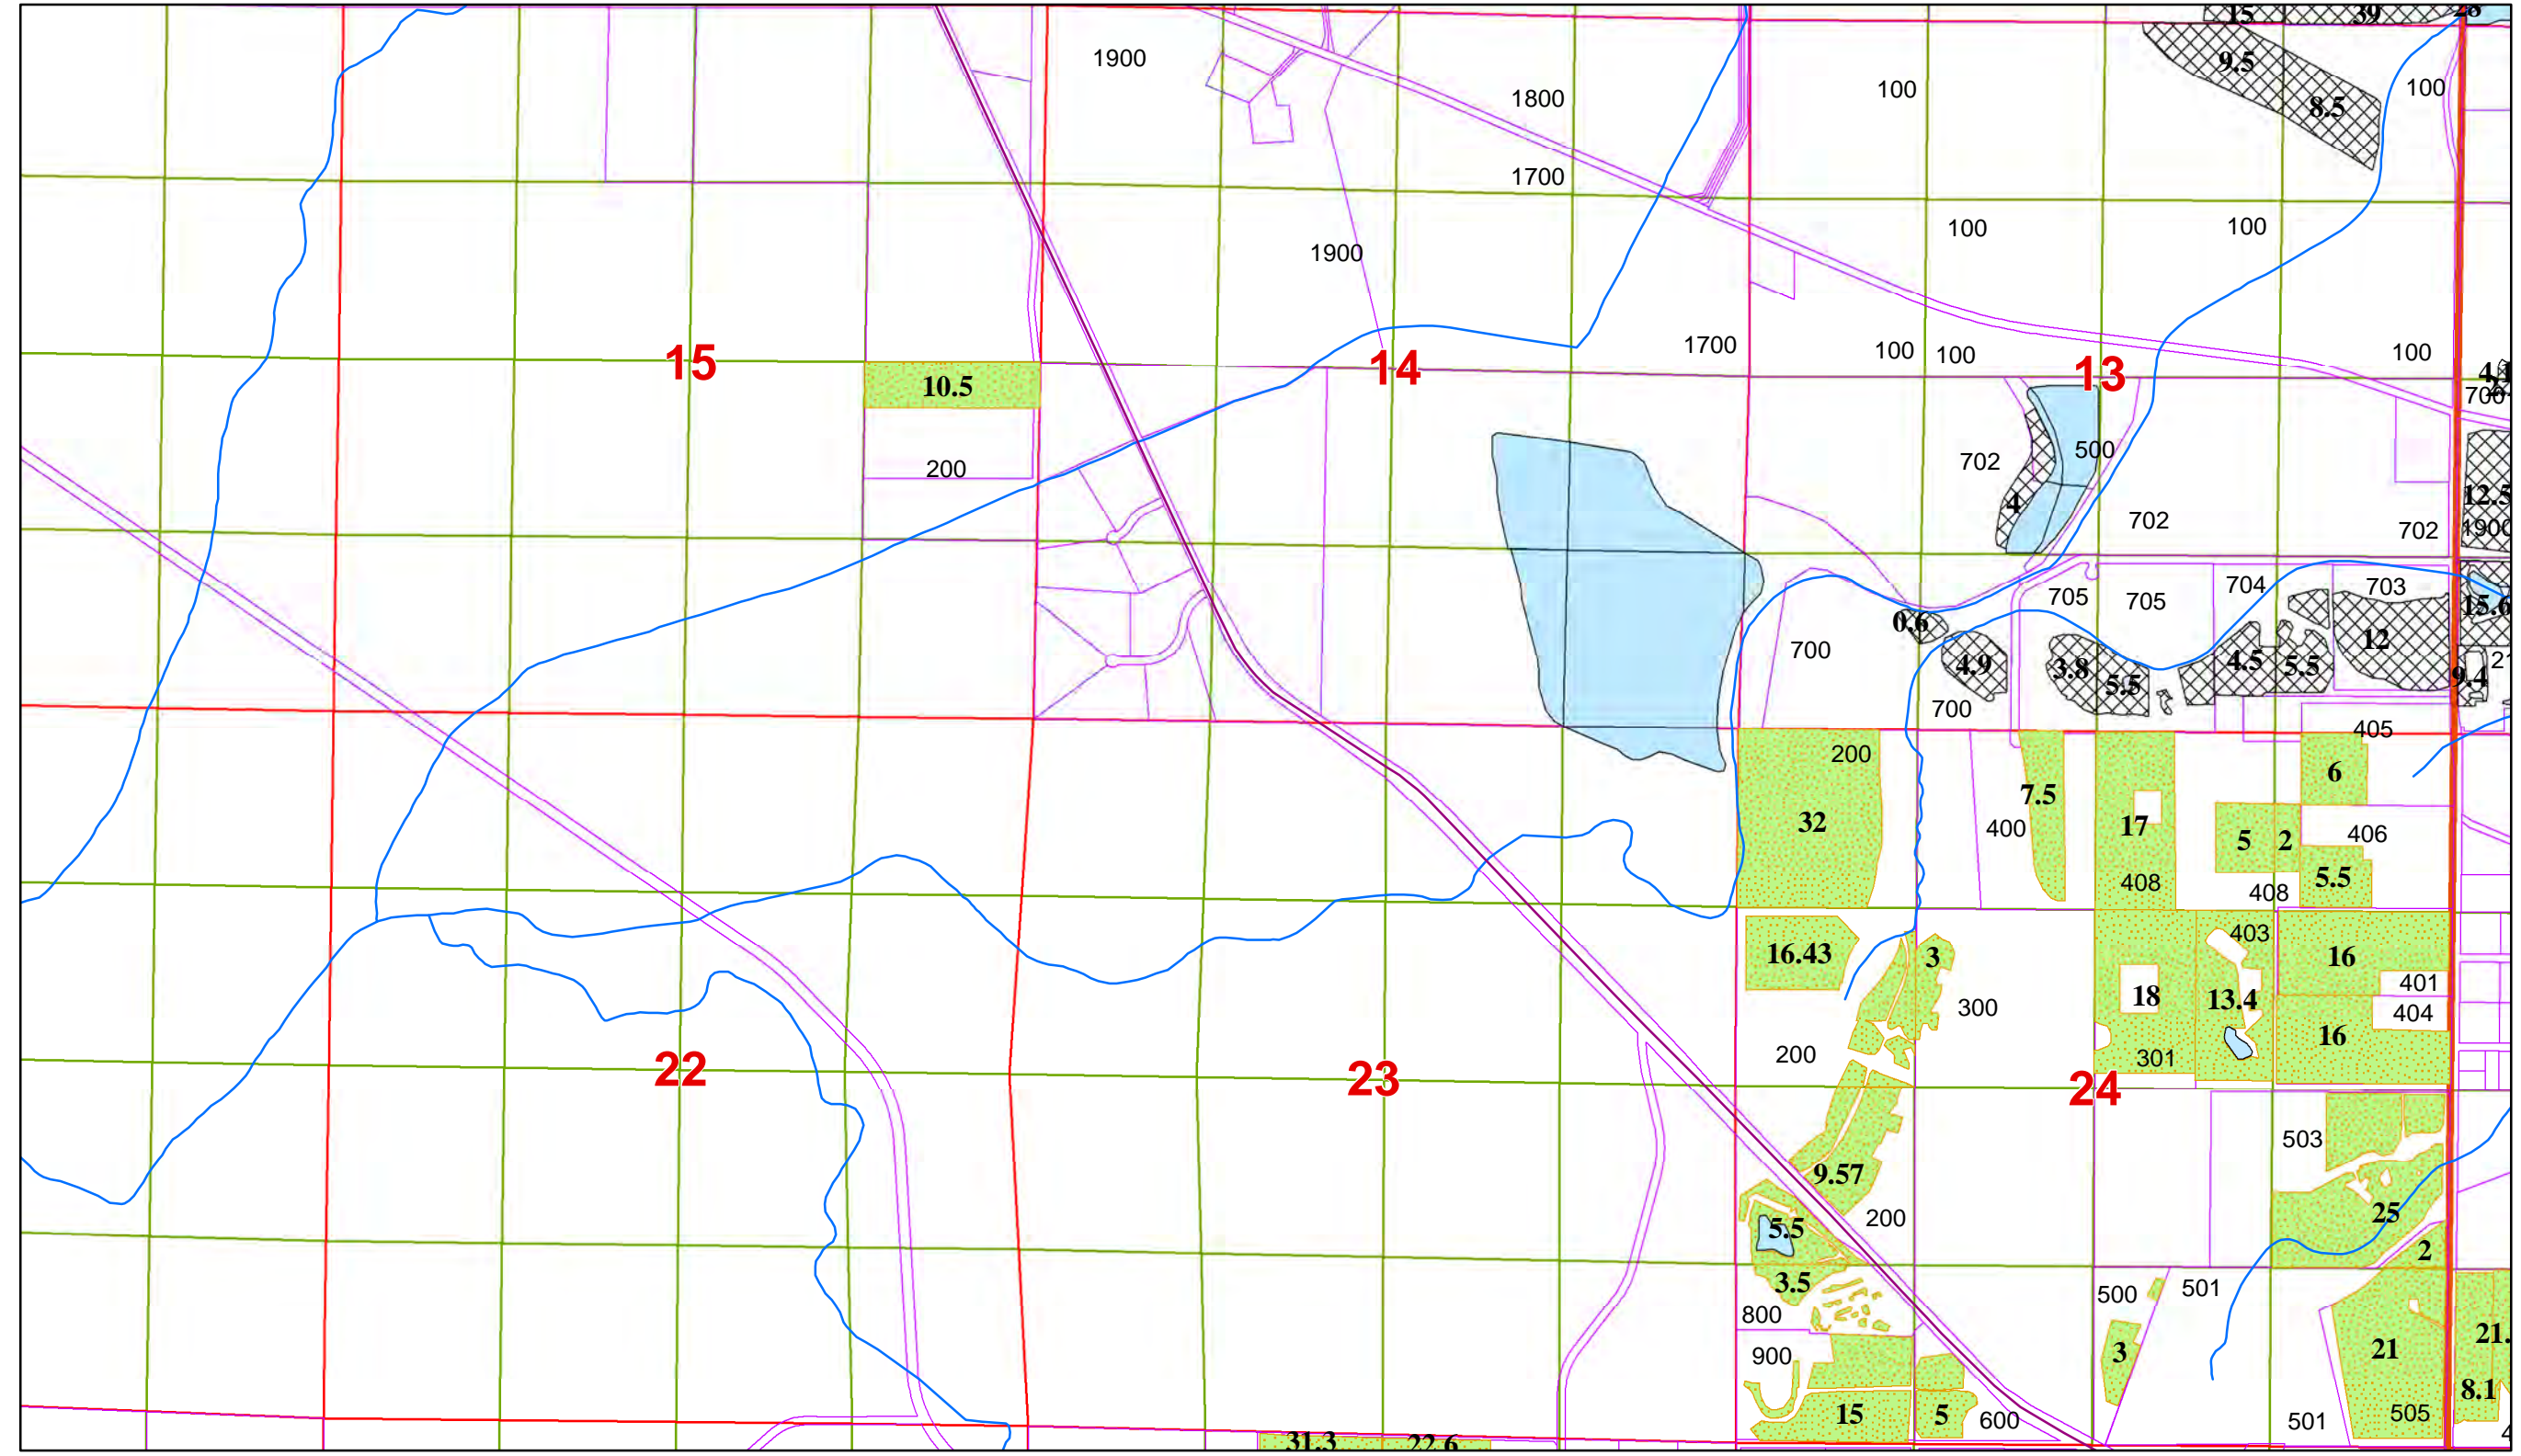
-  S 29312, G 11378
-  S 29312
-  G 11378
-  Ponds

Well 1: 10 FEET SOUTH & 620 FEET WEST FROM THE E /14 CORNER OF SECTION 14, BEING WITHIN T15S R10E SEC 14, NESE, W.M.

Well 2: 40 FEET SOUTH & 1400 FEET WEST FROM THE E /14 CORNER OF SECTION 14 BEING WITHIN T15S R10E SEC 14, NWSE, W .M.

Three Sisters Irrigation District Township 15 South, Range 10 East, W.M.

1 inch = 1,320 feet







Page 1 of 10

This map is for the purpose of identifying the location of the water right.
It is not intended to provide legal dimensions of locations of property ownership lines.

**Supplemental Irrigation
Final Proof Map for Permit G-11378**

supplemental rights:


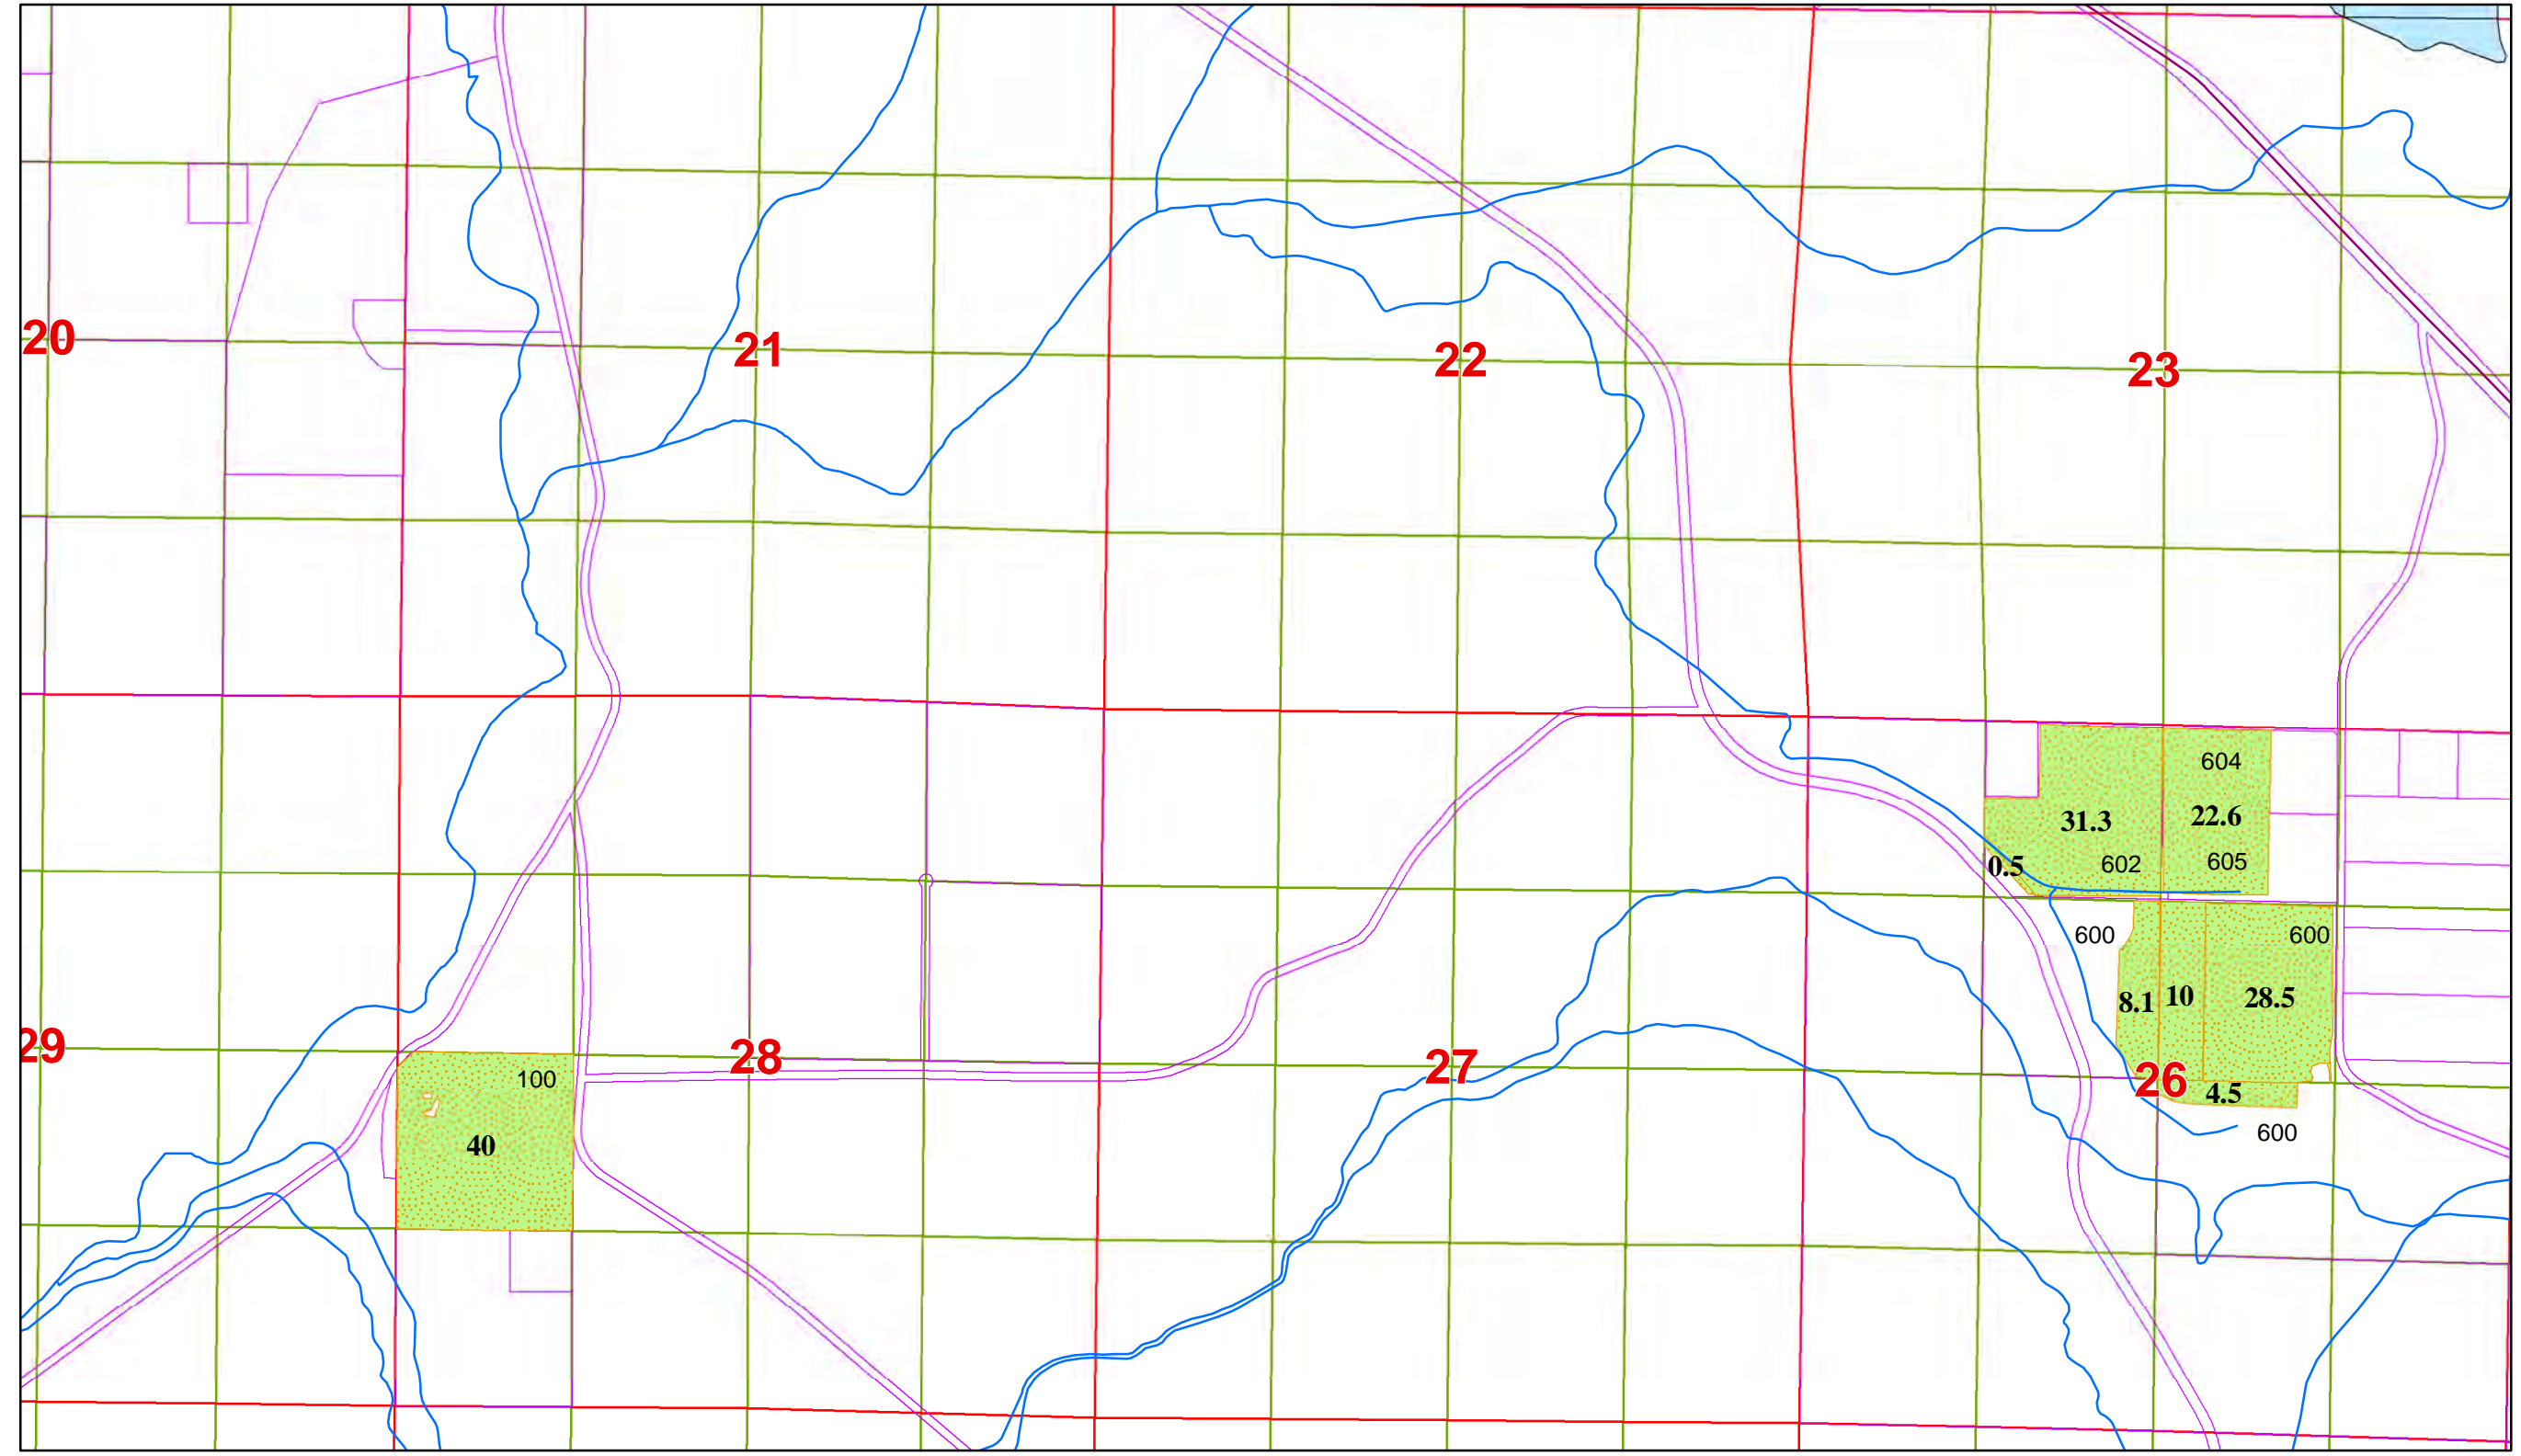
-  S 29312, G 11378
-  G 11378
-  Ponds

Well 1: 10 FEET SOUTH & 620 FEET WEST FROM THE E /14 CORNER OF SECTION 14, BEING WITHIN T15S R10E SEC 14, NESE, W.M.

Well 2: 40 FEET SOUTH & 1400 FEET WEST FROM THE E /14 CORNER OF SECTION 14 BEING WITHIN T15S R10E SEC 14, NWSE, W .M.

Three Sisters Irrigation District Township 15 South, Range 10 East, W.M.

1 inch = 1,320 feet

This map is for the purpose of identifying the location of the water right.
It is not intended to provide legal dimensions of locations of property ownership lines.

Supplemental Irrigation
Final Proof Map for Permit G-11378

supplemental rights:


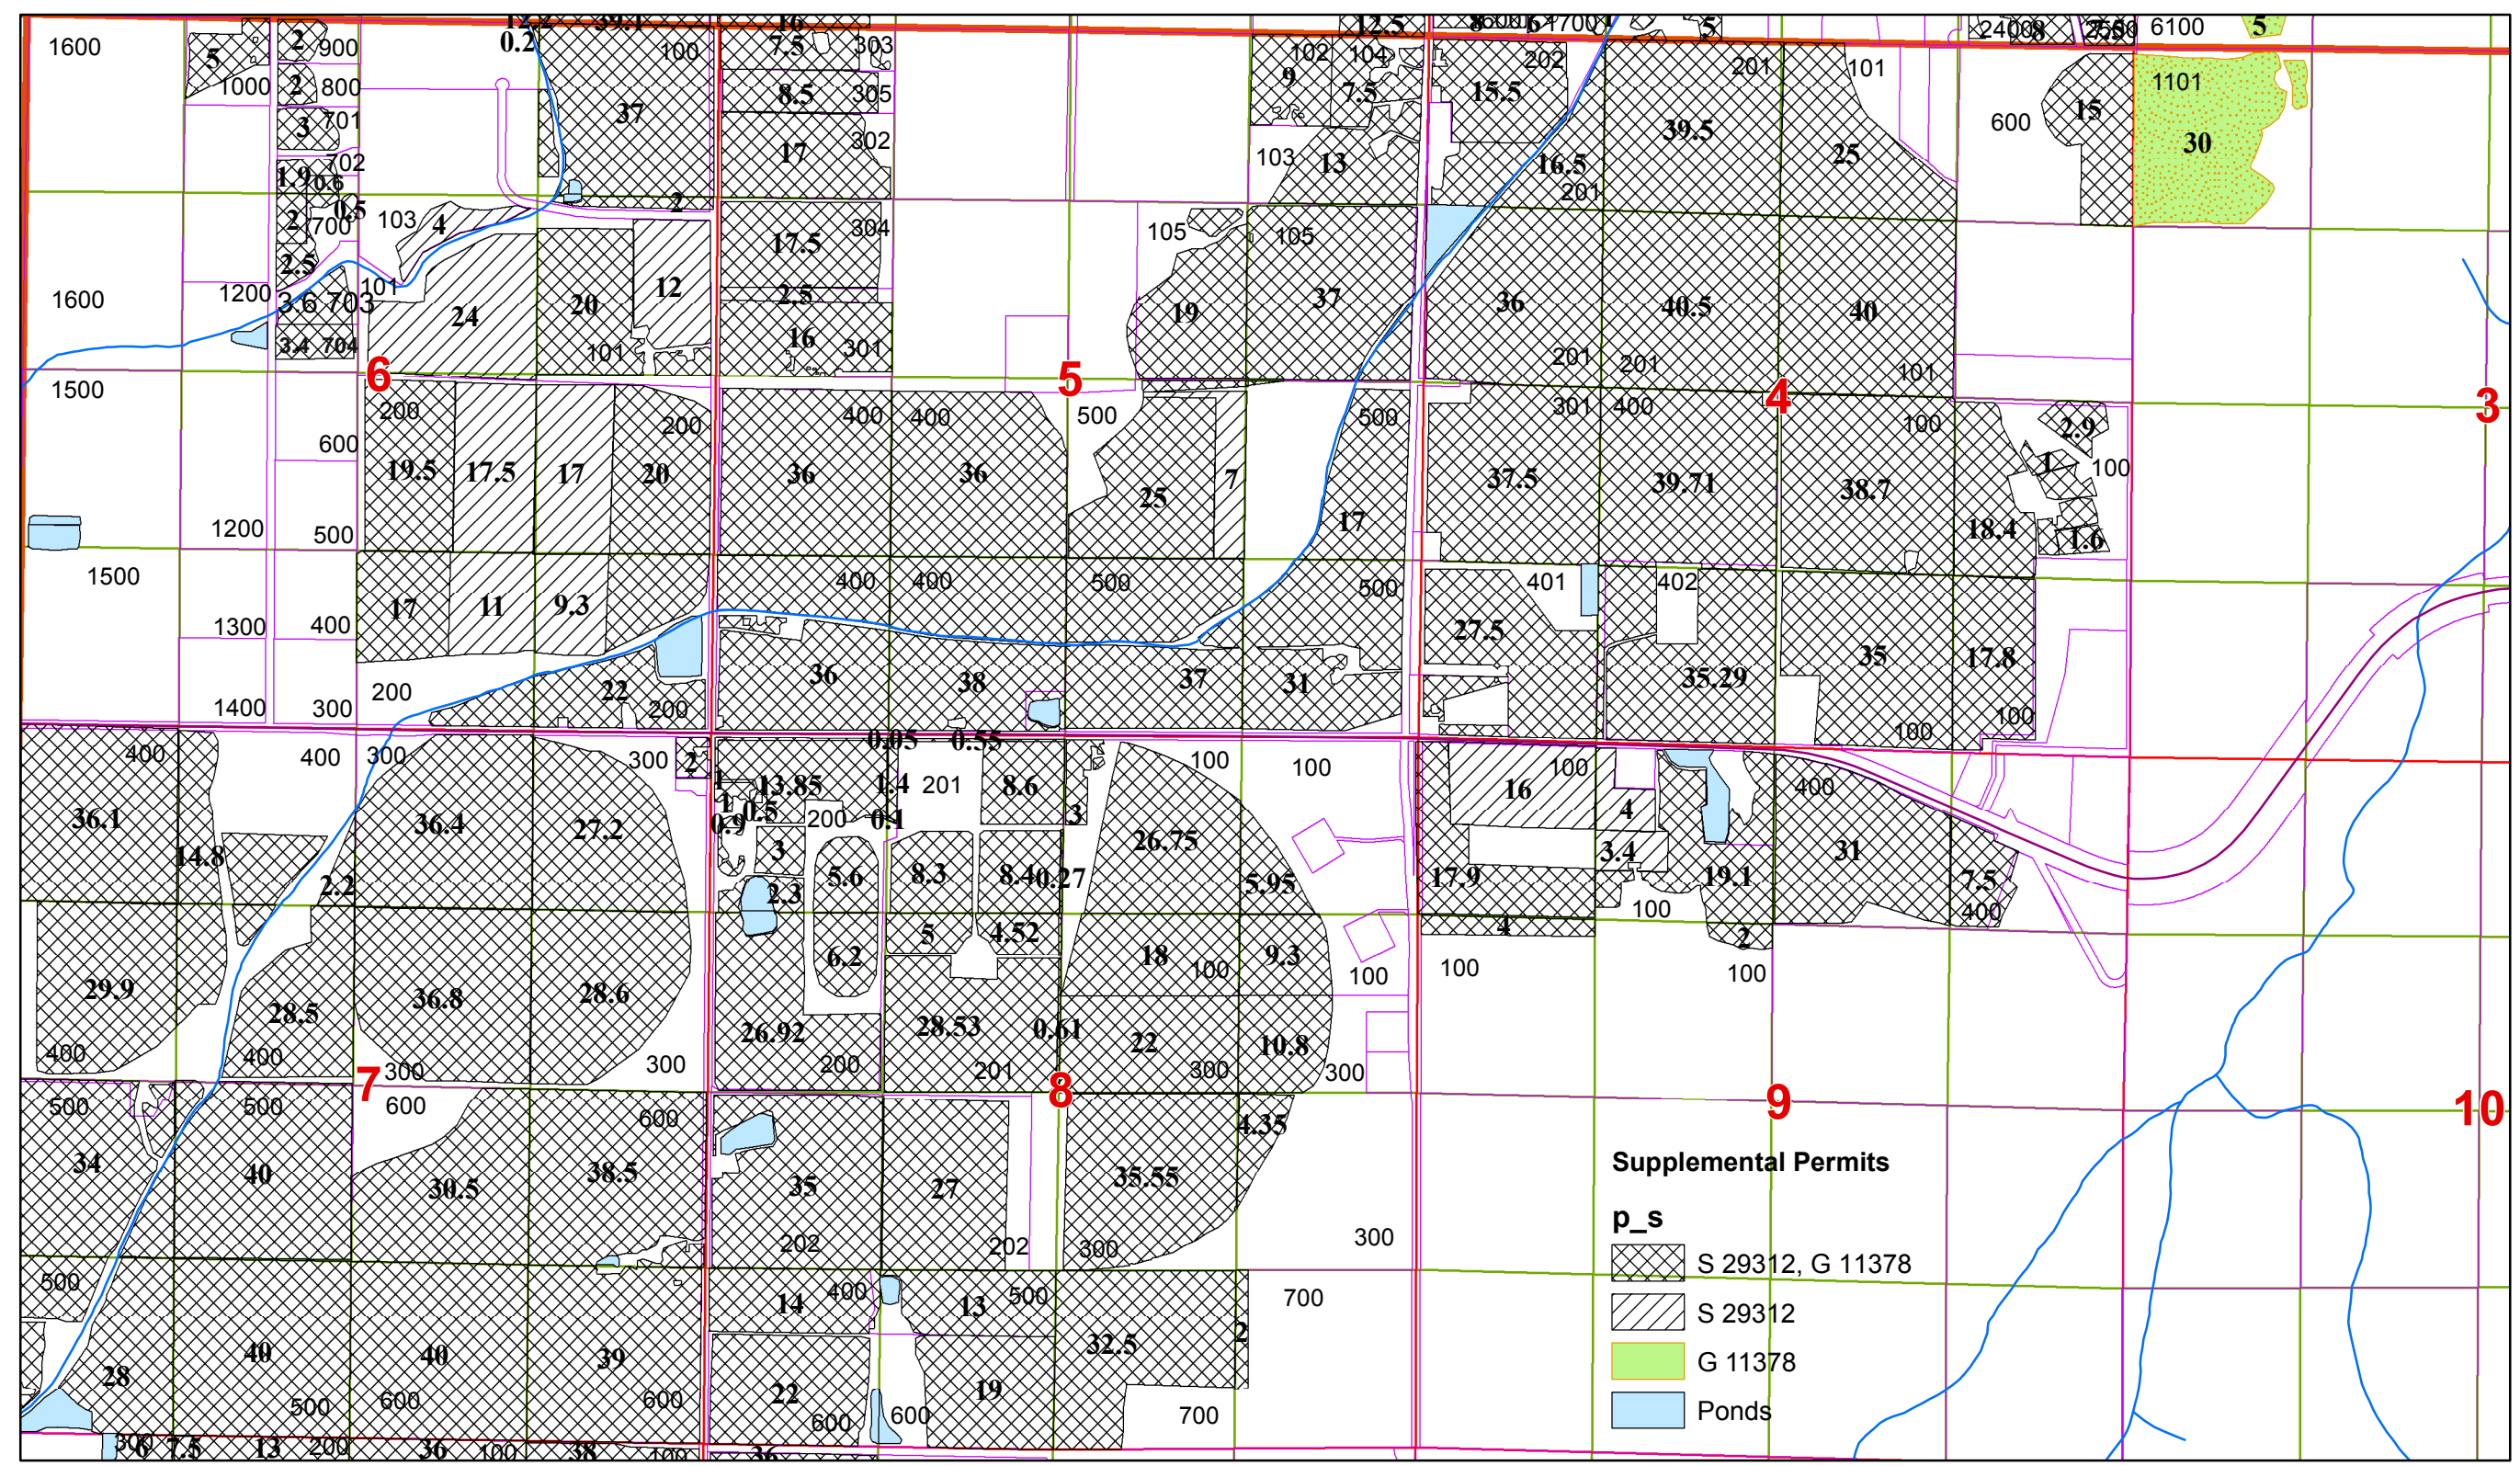
- G 11378
- Ponds

Well 1: 10 FEET SOUTH & 620 FEET WEST FROM THE E /14 CORNER OF SECTION 14, BEING WITHIN T15S R10E SEC 14, NESE, W.M.

Well 2: 40 FEET SOUTH & 1400 FEET WEST FROM THE E /14 CORNER OF SECTION 14 BEING WITHIN T15S R10E SEC 14, NWSE, W .M.

Three Sisters Irrigation District Township 15 South, Range 11 East, W.M.

1 inch = 1,320 feet

This map is for the purpose of identifying the location of the water right.
It is not intended to provide legal dimensions of locations of property ownership lines.

Well 1: 10 FEET SOUTH & 620 FEET WEST FROM THE E /14 CORNER
OF SECTION 14, BEING WITHIN T15S R10E SEC 14, NESE, W.M.


Well 2: 40 FEET SOUTH & 1400 FEET WEST FROM THE E /14 CORNER OF
SECTION 14, BEING WITHIN T15S R10E SEC 14, NWSE, W .M.

Three Sisters Irrigation District

Township 15 South, Range 11 East, W.M.



1 inch = 1,320 feet

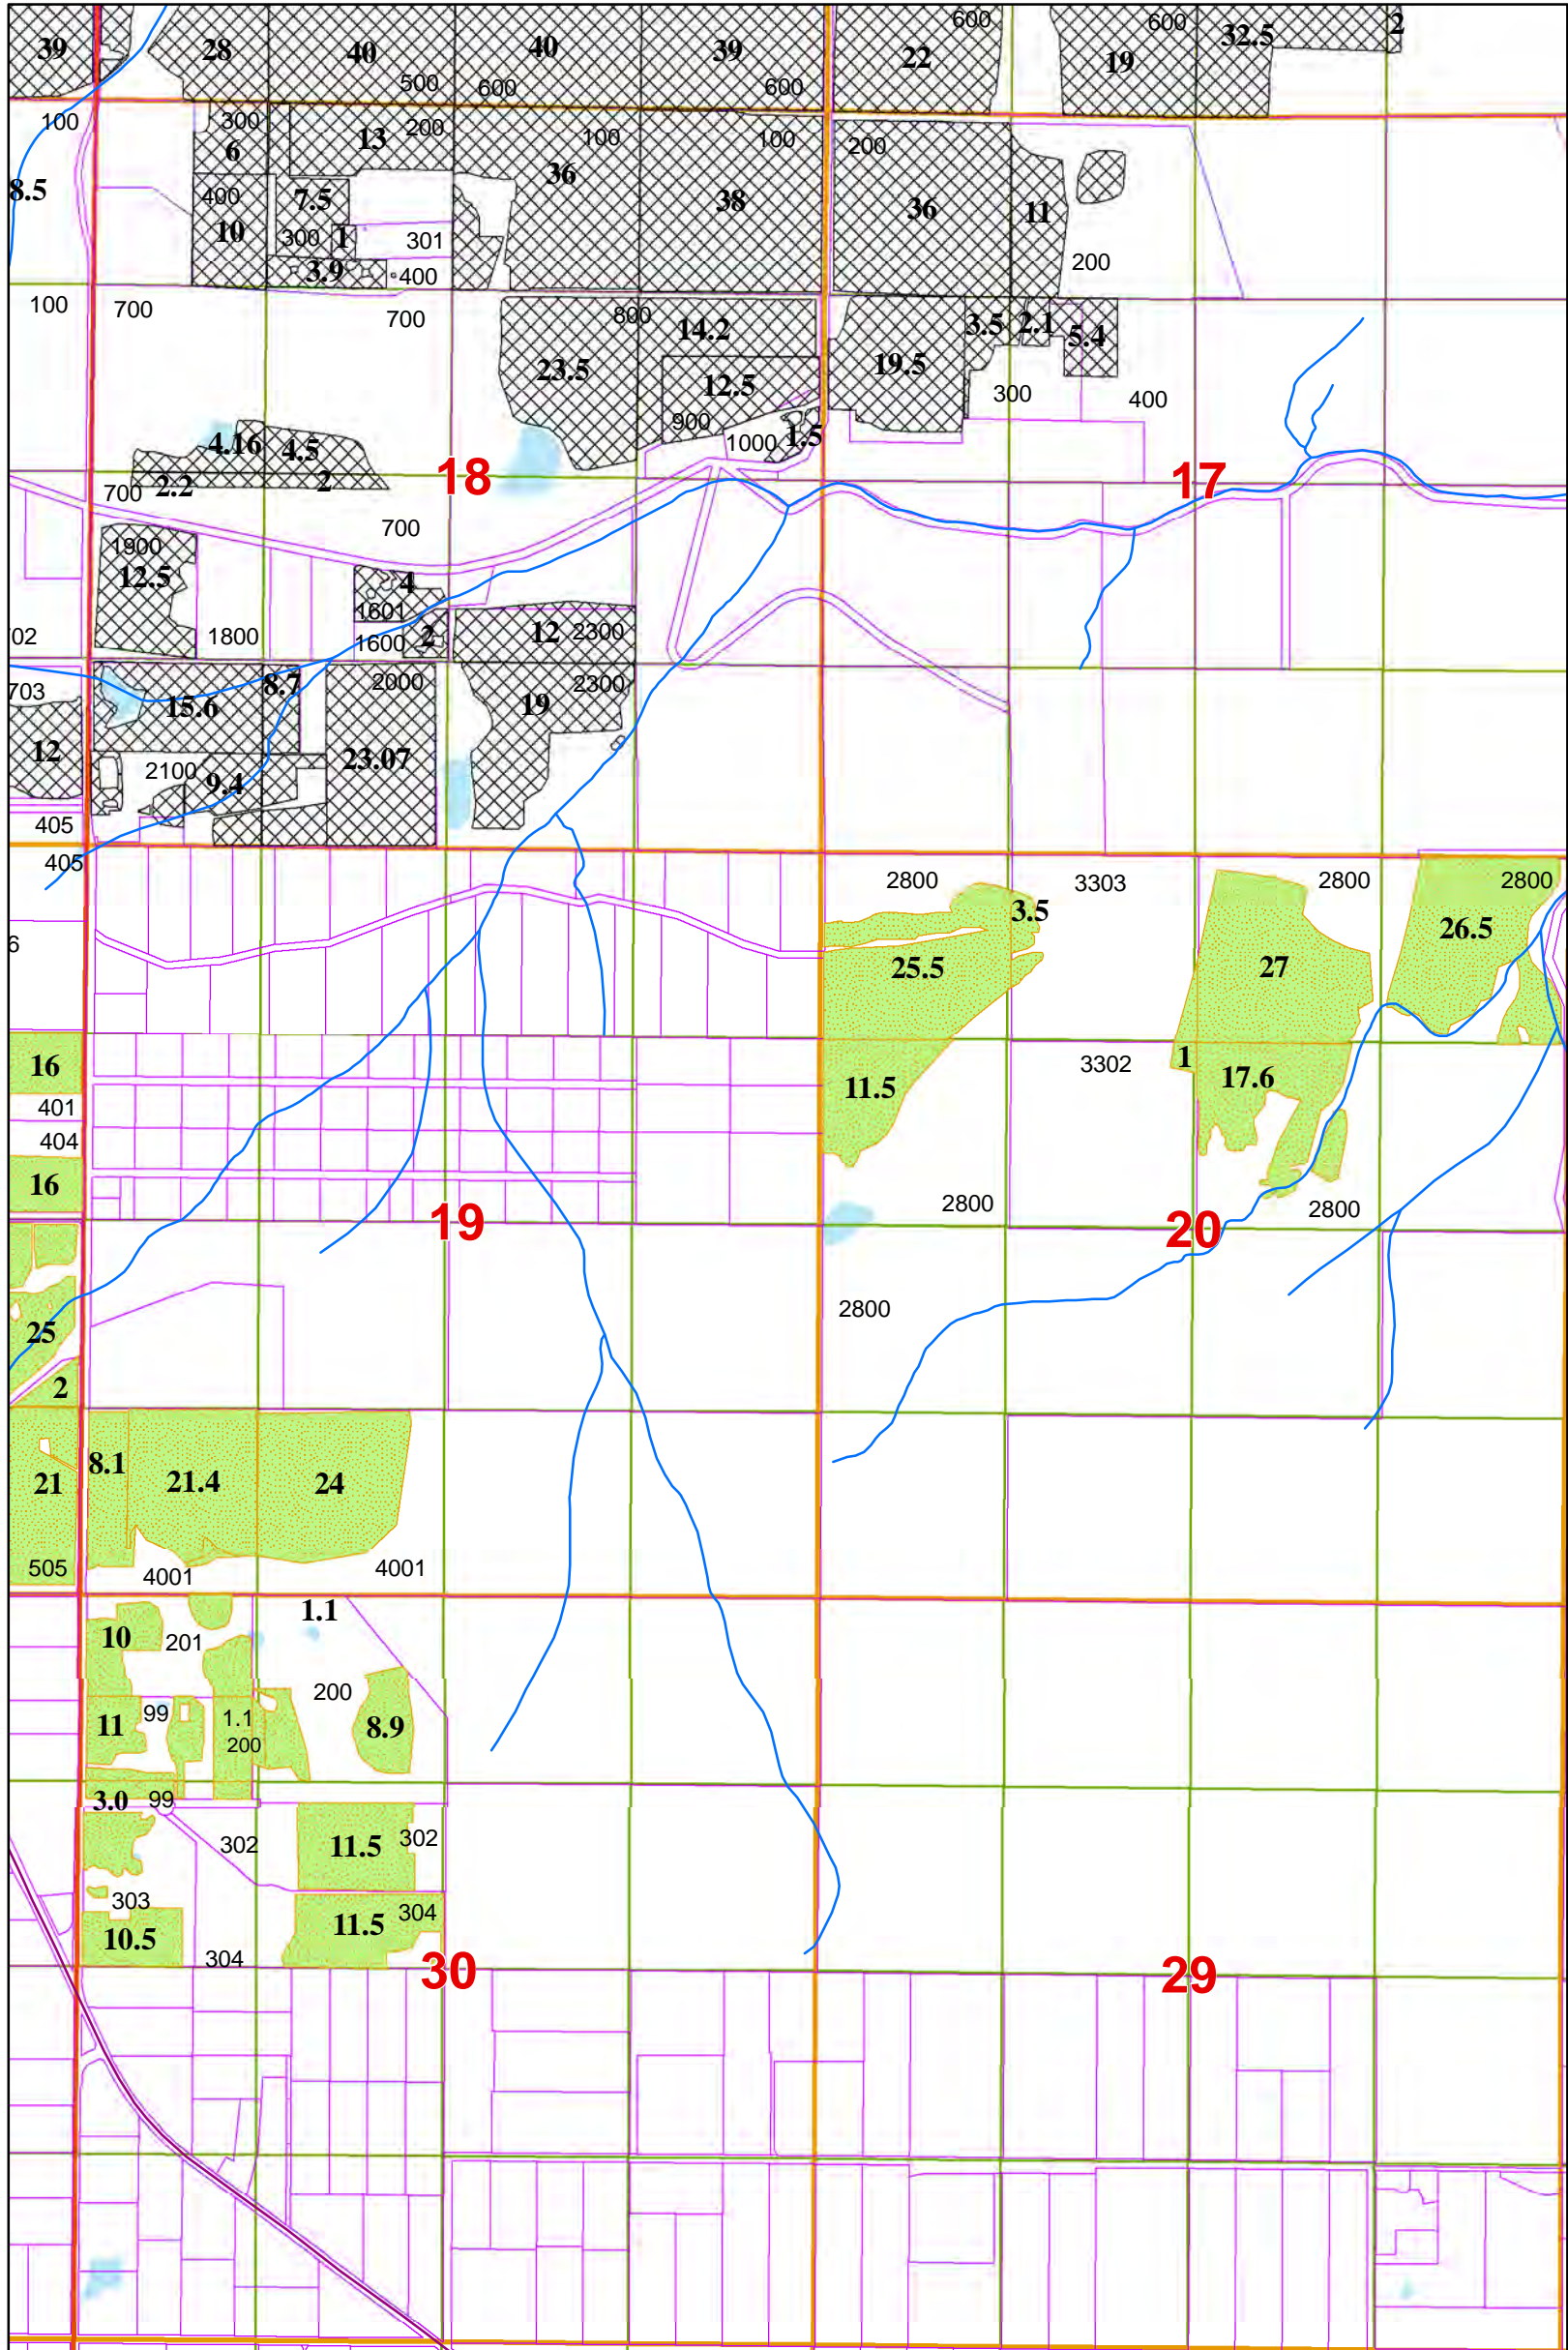

This map is for the purpose of identifying the location of the water right.
It is not intended to provide legal dimensions of locations of property ownership lines.

Supplemental Irrigation
Final Proof Map for Permit G-11348

mg_TSID_2019
supplemental rights:

- S 29312, G 11378
- G 11378

Well 1: 10 FEET SOUTH & 620 FEET WEST FROM THE E /14 CORNER OF SECTION 14, BEING WITHIN T15S R10E SEC 14, NESE, W.M.

Well 2: 40 FEET SOUTH & 1400 FEET WEST FROM THE E /14 CORNER OF SECTION 14 BEING WITHIN T15S R10E SEC 14, NWSE, W.M..