


Township 6 South, Range 1 East, W.M.

Section 3

RECEIVED

AUG - 6 1997

WATER RESOURCES DEPT.  
SALEM, OREGON

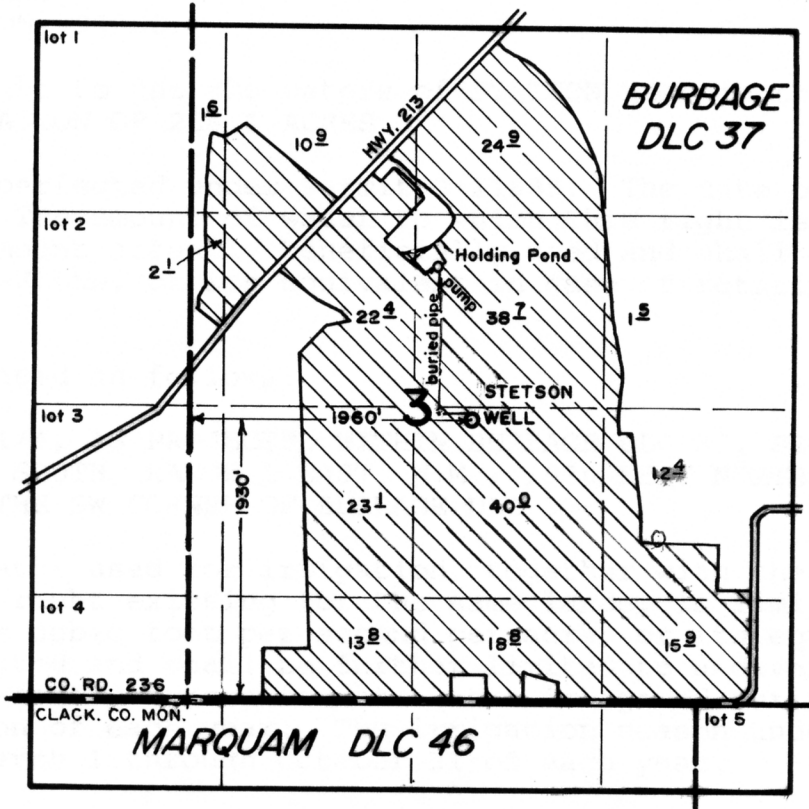

FINAL PROOF SURVEY


under

Appl. No. G-12149, Per. No. G-11688

in name of

KRAEMER FARMS

Apr. 29, 1997

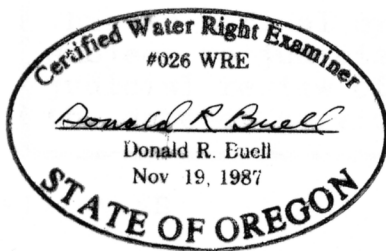

THIS MAP WAS PREPARED FOR THE PURPOSE OF IDENTIFYING THE LOCATION OF A WATER RIGHT ONLY AND IS NOT INTENDED TO PROVIDE LEGAL DIMENSIONS OR LOCATION OF PROPERTY OWNERSHIP LINES.