

SECTION 33, TWP.3 S. RANGE 16 E. W.M.
SHERMAN COUNTY, OREGON


RECEIVED

FEB 19 2008

WATER RESOURCES DEPT
SALEM, OREGON

TAX LOT
3S-16 2700

TAX LOT 3S-16 3900

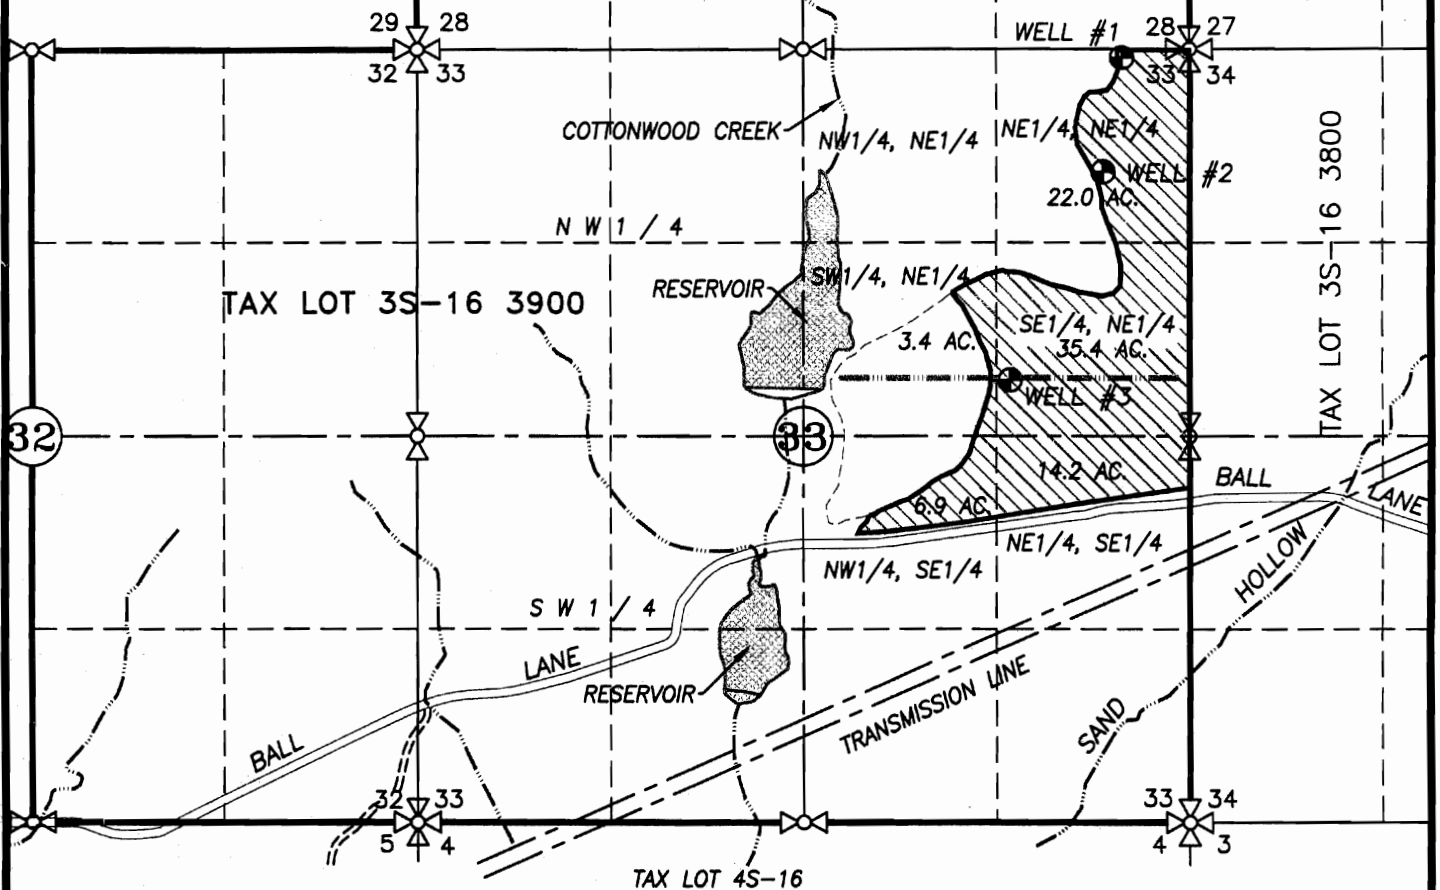

- EXISTING WELL #1, 60' S. & 460' W. OF NE COR. SEC. 33
- EXISTING WELL #2, 840' S. & 590' W. OF NE COR. SEC. 33
- EXISTING WELL #3, 2255' S. & 1225' S. OF NE COR. SEC. 33



EXISTING WATER RIGHT CERT. #67578 AREA = 81.9 AC.

--- IRRIGATION MAIN

WATER RIGHT TRANSFER APPLICATION

SCALE: 1" = 1320'

TRANSFER No. _____

APPLICATION No. G-10879

PERMIT No. G-10074


IN THE NAME OF:

FRED AND JUDY JUSTESEN

DATE: JANUARY 23, 2008

BY: **TENNESON ENGINEERING CORP.**

409 LINCOLN STREET,
THE DALLES, OREGON. 97058
PH. (541) 296-9177
FAX (541) 296-6657

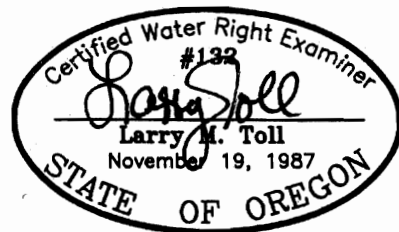

EXPIRES: 06/30/08


NOTE:

"THIS MAP IS NOT INTENDED TO
PROVIDE DIMENSIONS OR LOCATIONS
OF PROPERTY OWNERSHIP LINES."

W.O. #12416A_wr

T. 3 S. R. 16 E. W.M.

↑
N

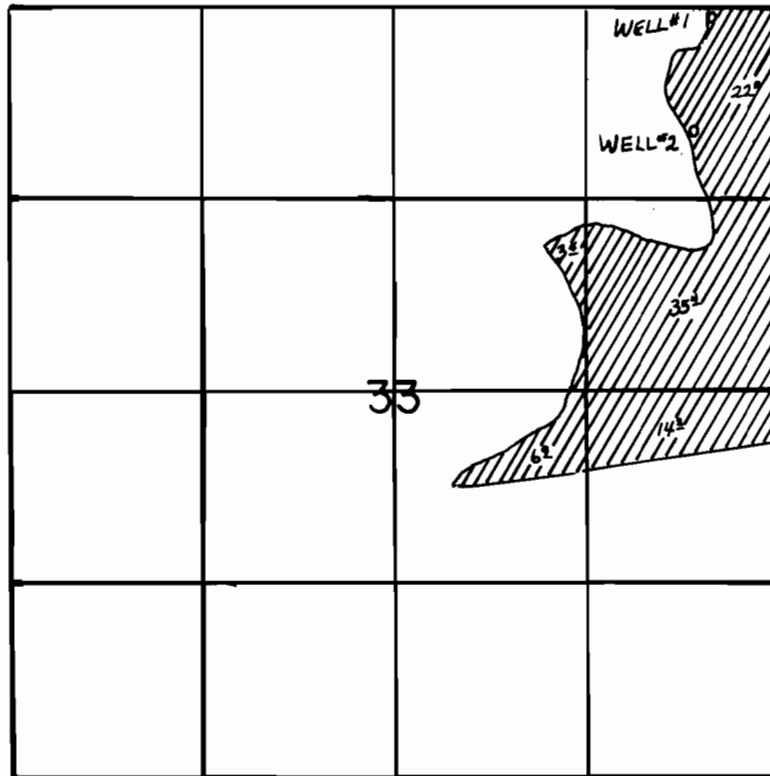

WELL #1 - 60' S. and 460' W.; WELL #2 - 840' S. and 590' W., both from the NE Corner of S. 33, being within the NE $\frac{1}{4}$ NE $\frac{1}{4}$ of S.33, T.3 S. R 16 E., WM.

FINAL PROOF SURVEY UNDER

Application No. ~~G-10879~~ Permit No. G10074..
IN NAME OF

.....FRED. A. JUSTESEN.....

Surveyed ~~10-8~~ 1991., by J. Miller.....

41055-279-134L
NCR
Jm 1-22-92