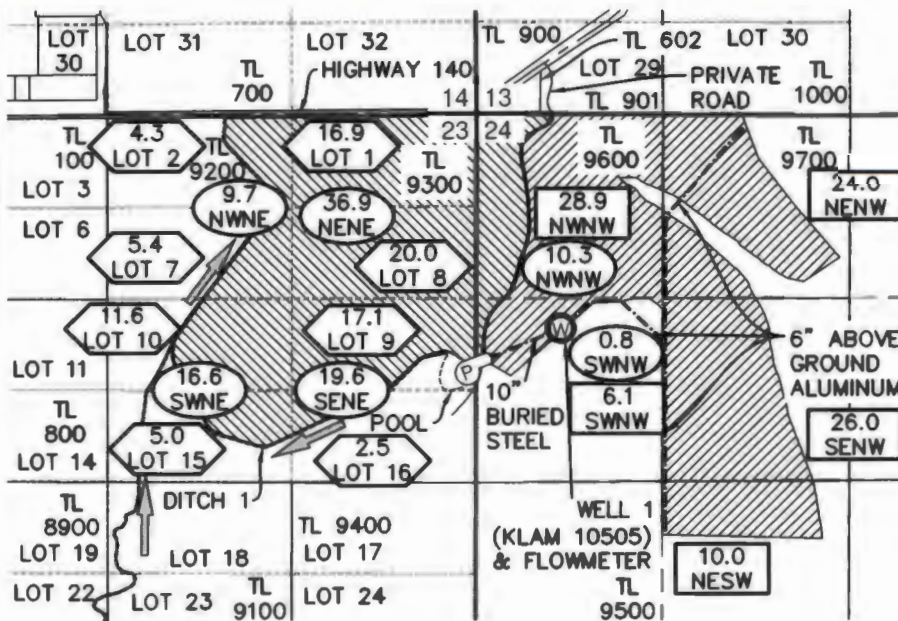


NOTES:

1. THIS MAP WAS PREPARED FROM FIELD MEASUREMENTS, NAIP 2023 AERIAL PHOTOGRAPHY, KLAMATH COUNTY TAX MAPS, AND OREGON GLO MAPS.

2. THE PURPOSE OF THIS MAP IS TO IDENTIFY THE LOCATION OF THE WATER RIGHT ONLY, AND IS NOT INTENDED TO PROVIDE DIMENSIONS OR LOCATION OF PROPERTY LINES.

3. DATE OF PRIORITY FOR THIS WATER RIGHT IS AUGUST 26, 1993.


WELL LOCATION:

WELL 1 (KLAM 10505): 1562' SOUTH & 618' EAST FROM THE NORTHWEST CORNER OF SECTION 24.

Received by OWRD

MAY 20 2024

Salem, OR

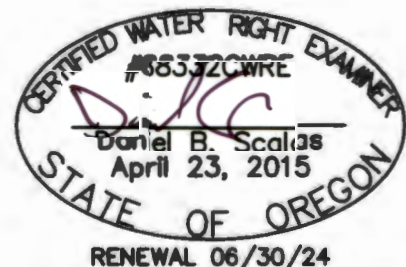

LEGEND

—	SECTION LINE	⊙	WELL
- - -	1/4 1/4 LINE	▨	IRRIGATED UNDER PERMIT G-12912 (SUPPLEMENTAL TO KA 119)
- - -	GOVERNMENT LOT LINE	▨	IRRIGATED UNDER PERMIT G-12912 (SUPPLEMENTAL TO CERTIFICATE 67800)
- - -	TAX LOT LINE	⊙	IRRIGATED ACRES (SUPPLEMENTAL TO KA 119)
- - -	DITCH LINE	⊙	1/4 1/4 SECTION
- - -	MAINLINE PIPE	⊙	IRRIGATED ACRES (SUPPLEMENTAL TO KA 119)
- - -	ROAD	⊙	GOVERNMENT LOT NUMBER
⊙	BOOSTER PUMP	⊙	IRRIGATED ACRES (SUPPLEMENTAL TO CERTIFICATE 67800)
←	FLOW DIRECTION	⊙	GOVERNMENT LOT NUMBER
22/22	SECTION CORNER	⊙	POOL
22/22	TAX LOT NUMBER	⊙	
TL 0000	GOVERNMENT LOT NUMBER	⊙	
LOT 1	POOL	⊙	

AL ADKINS
ENGINEERING & SURVEYING

o / 541.684.4666
w / AdkinsEngineering.com

1435 ESPLANADE AVENUE, KLAMATH FALLS, OR 97601

SERVING S. OREGON & N. CALIFORNIA

CLAIM OF BENEFICIAL USE AND FINAL PROOF MAP

FOR
PATTON RANCH MANAGEMENT
T36S, R12E, SECS. 23 & 24, WM
KLAMATH COUNTY, OREGON
PERMIT G-12912
APPLICATION G-13503

5/16/2024

ENGINEERING • SURVEYING • PLANNING • TESTING

4107-01