


T.4S. R.1E. Sec. 23, 24 & 25, W.M.

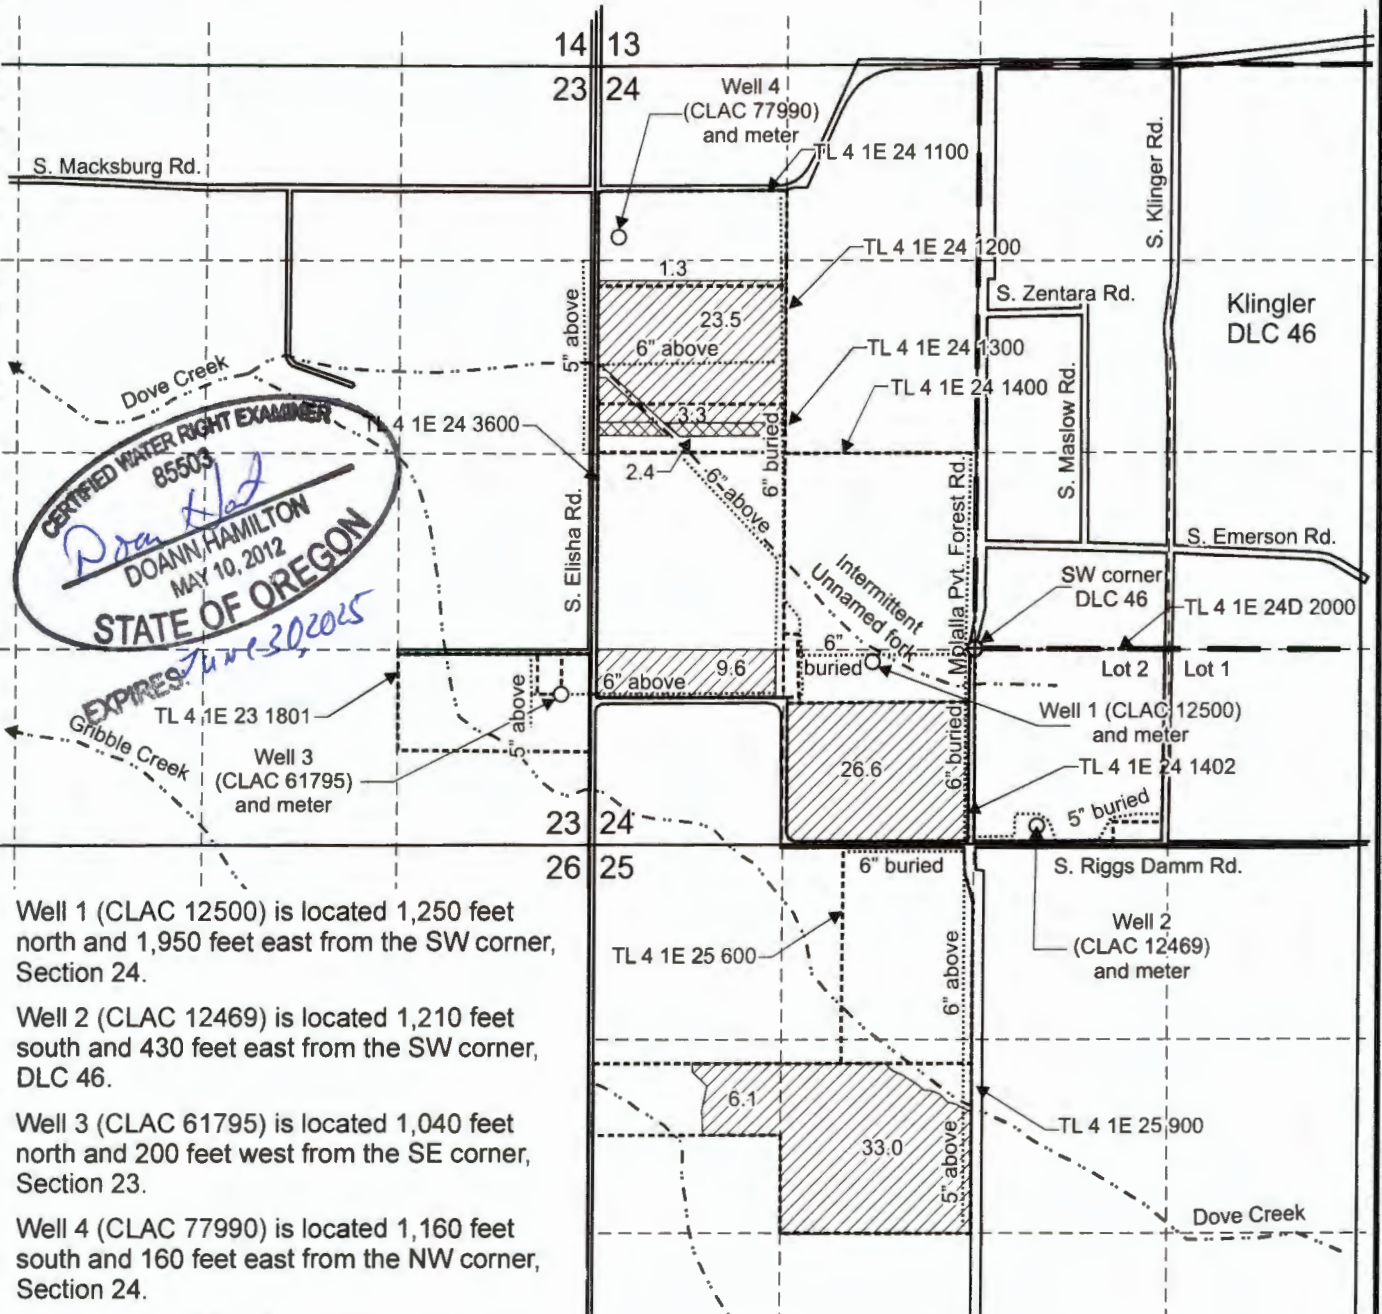

Pacific Hydro-Geology Inc.

10/2023

Claim of Beneficial Use Map
 T-13425, formerly Certificate 94707

Steve Koch
 T.4S. R.1E. Sec. 23, 24 & 25, W.M.

RECEIVED
 NOV 17 2023
 OWRD