


T. 1N. R. 3W. W.M.

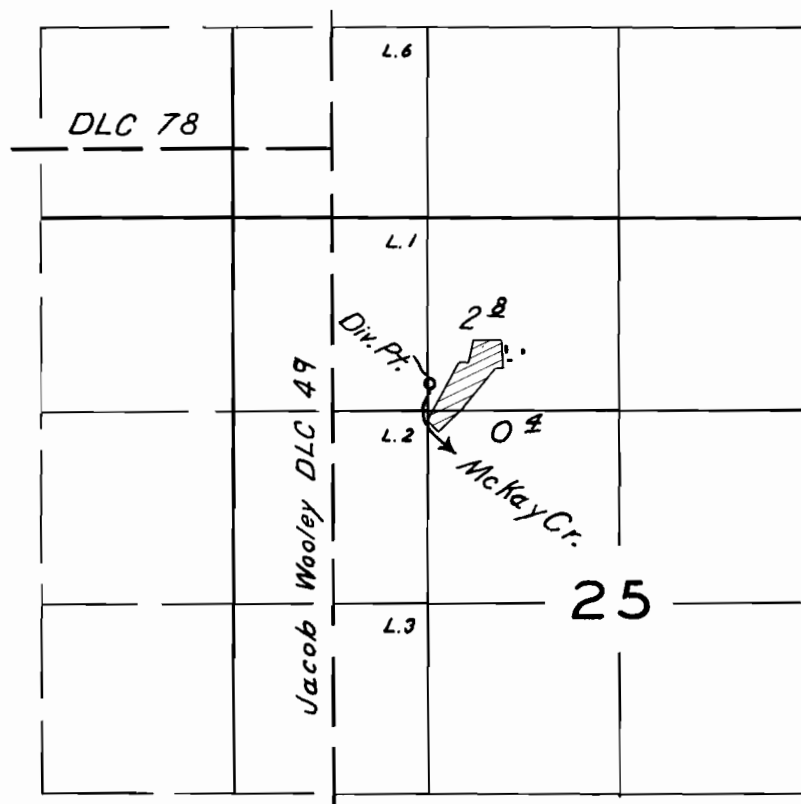

FINAL PROOF SURVEY
UNDER

Application No. 26311 Permit No. 20465
IN NAME OF


E.K. Prickett

Surveyed April 29 1958, by *R.H. Whitby*

Transfer Application

Swallowtail School

Township 1N, Range 3W, Section 25, W.M.

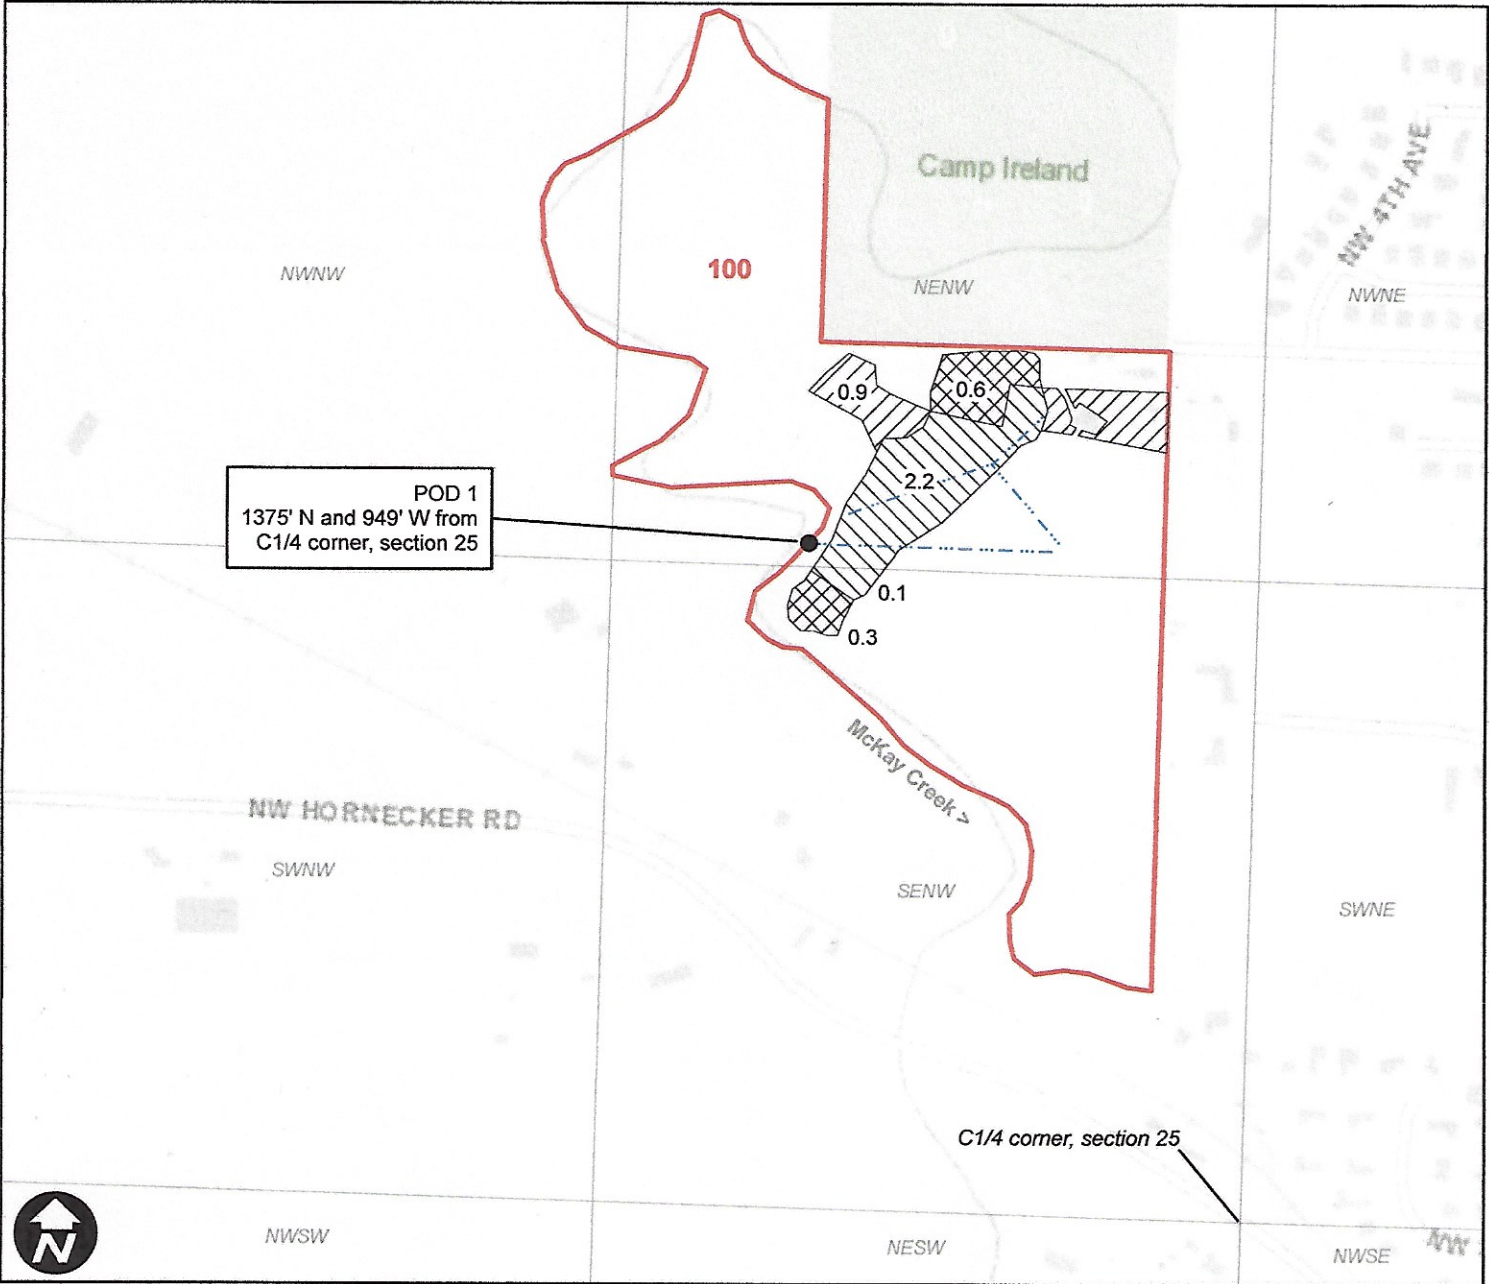

Legend

- Cert. 24739 From
- Cert. 24739 To
- Cert. 24739 No Change
- Mainline
- Taxlot
- Bulge Reservoir

