


MAP TO ACCOMPANY APPLICATION TO CHANGE
PLACE OF USE
FOR RUSS MATTIS

SECTION 28, TOWNSHIP 26 SOUTH, RANGE 14 EAST, W.M.
TAX LOT: 2100

RECEIVED

SEP 22 2022

OWRD

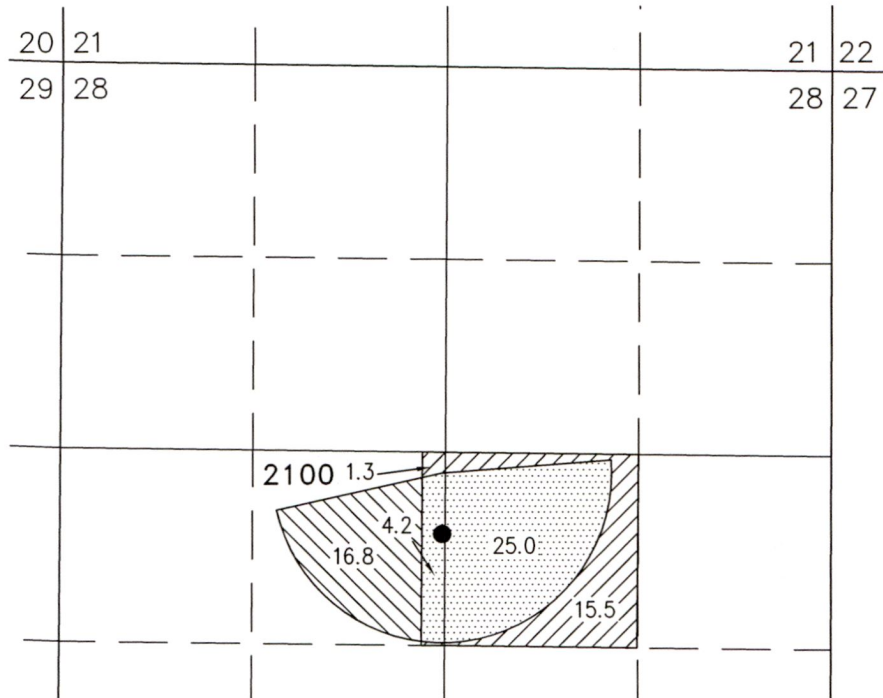


29.2 ACRES IR FROM C52624,
REMAIN AS SHOWN

16.8 ACRES IR FROM C52624,
TRANSFERRED OFF, AS SHOWN

16.8 ACRES IR FROM C52624,
TRANSFERRED ON, AS SHOWN

- POA (LAKE 364/365)
EXISTING WELL AUTHORIZED BY C52624 LOCATED IN THE
NE 1/4 OF THE SW 1/4 SECTION 28 & 560 FEET SOUTH
& 20 FEET WEST FROM THE C 1/4 CORNER SECTION 28.

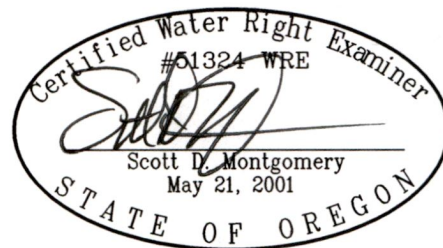

RENEWAL DATE: 12/31/2022 ~~14095~~

THIS MAP IS FOR THE PURPOSE OF DESIGNING AN
IRRIGATION SYSTEM PLAN AND HAS NO INTENT TO PROVIDE
LEGAL DIMENSIONS OR THE LOCATION OF PROPERTY LINES

PROJECT No. 22-093

PREPARED AT THE REQUEST OF:

RUSS MATTIS
P.O. BOX 87
FT. ROCK, OR 97735

ALL POINTS ENGINEERING
& SURVEYING, INC.




P.O. BOX 767
TERREBONNE, OREGON 97760
(541) 548-5833 PH
Scott@APEandS.com
www.APEandS.com

14096

G:7510
52624

T.26S.,R.14E.,W.M.

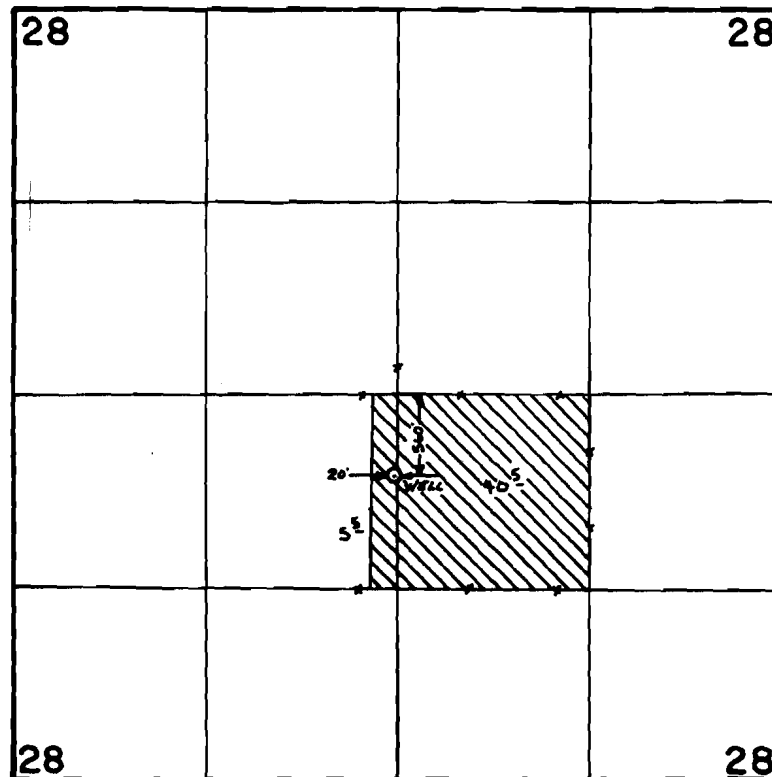

FINAL PROOF SURVEY
UNDER

Application No. .G:8139.. Permit No. .G:7510.....
IN NAME OF

...WILLIAM...L...&...FLOY...O...SMITH

Surveyed July..26.. 19.83., by ...L...M...TOLL.....