TOWNSHIP 16 SOUTH, RANGE 22 EAST, W.M.

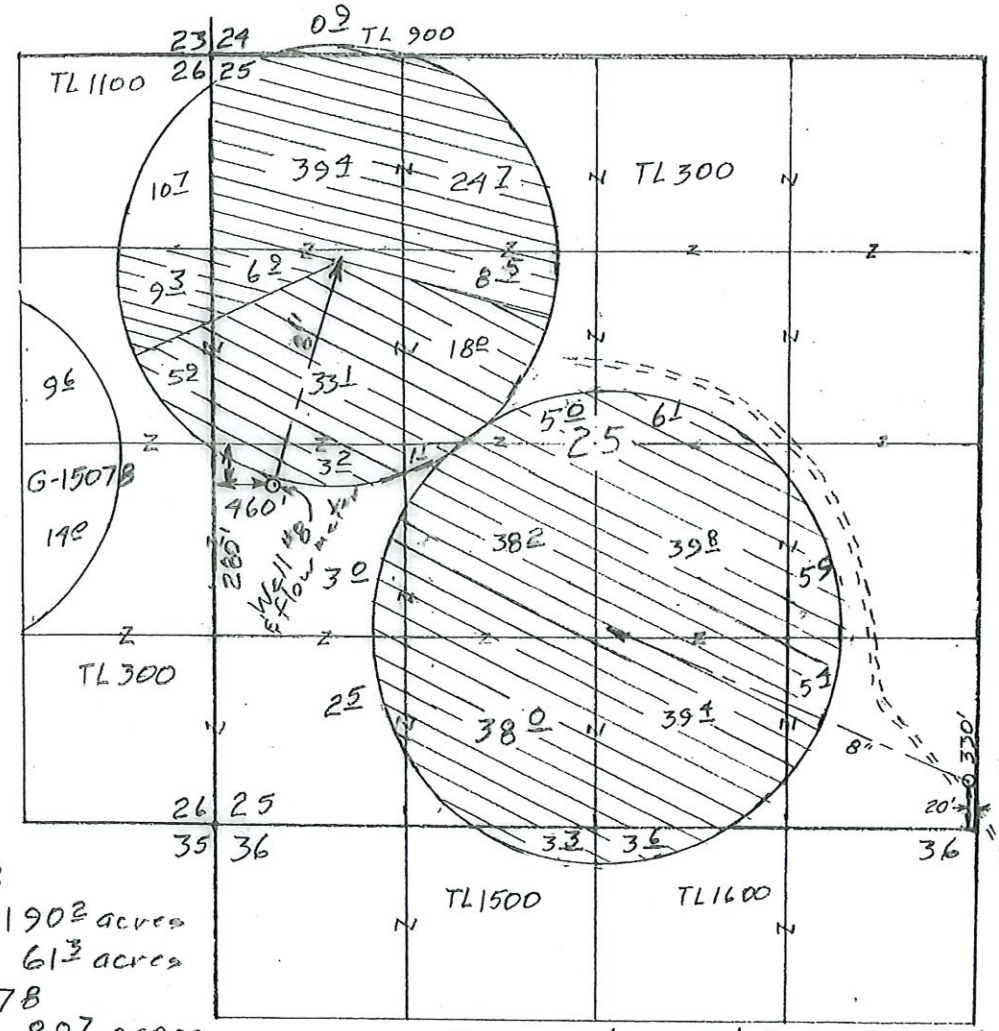

Scale
1" = 1320'
(4" = 1 mile)

Pivot #5
190.2 acres

Well #5 & flow meter

- G-15598
  - Well #5 190.2 acres
  - Well #8 61.3 acres
- G-15078
  - Well #8 89.7 acres

Surveyed March 8, 2014 & July 22, 2014

Claim of Beneficial Use Map
for
Gutierrez Cattle Co.

App G-16037
Per G-15598
T-11055

App G-15222
Per G-15078
T-10868

Certified Water Right Examiner #1
Bruce A. Estes
Nov. 19, 1987
STATE OF OREGON
Renewal Dec 31, 2015

Sheet 2 of 2

RECEIVED BY OWRD
AUG 01 2014

This map is for the purpose of locating a water right only and has no intent to provide legal dimensions or the location of property lines.

ESTES SURVEYS, LLC
~~PO Box 17519~~
~~Salem, OR 97305-7519~~
~~(503) 585-7593~~
60382 Arnold Rd
Bend, OR 97702
(541) 382-7391

Amended 9 Jul 15