


T. 40 S., R. 2 W., W. M.

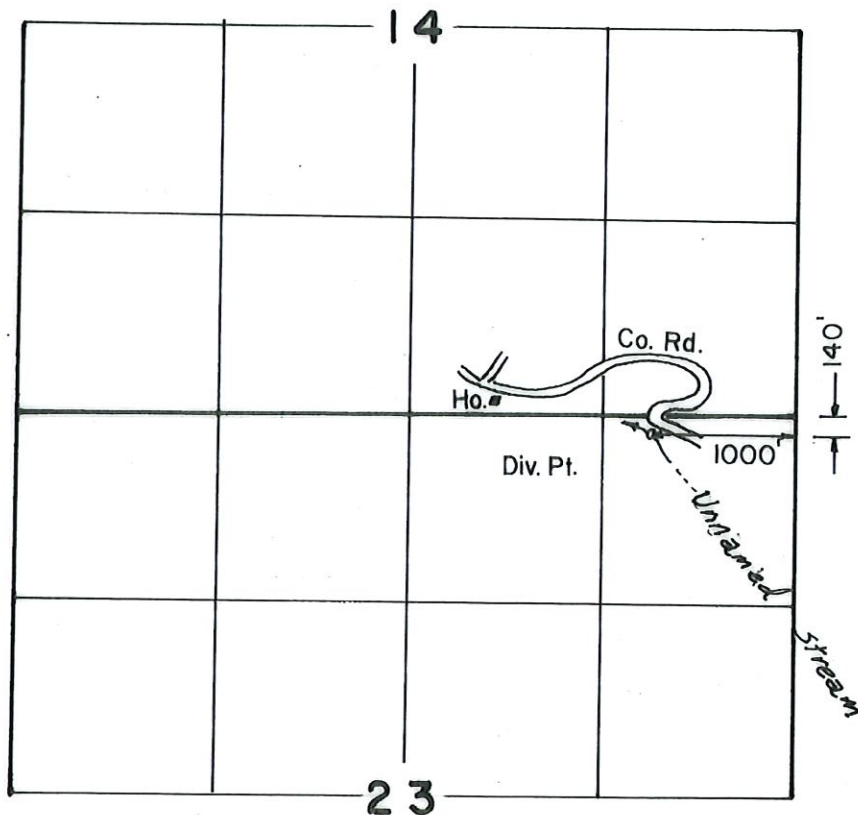

Scale: 1" = 1320'

FINAL PROOF SURVEY
UNDER

Application No. 65023 Permit No. 477.28...
IN NAME OF

.....*Pamela S. Stover*.....

Surveyed AUG... 1991..., by B..S..JAMES....