




**T27S R17E, WM,
LAKE COUNTY, OR**

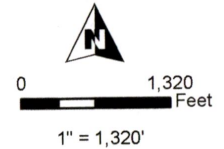

- Well
- POU IR CERT 81515 REMAINING
- POU IR CERT 81515 "OFF"
- Section
- Quarter Quarter
- Tax Lot

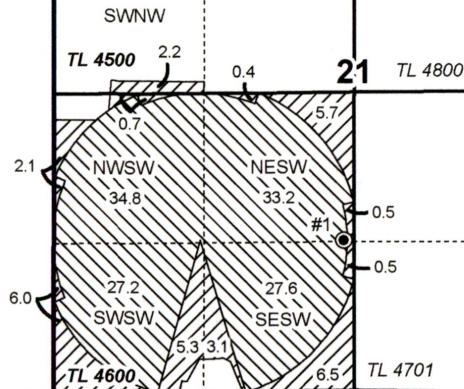

Well #1 (LAKE 1033) Location:
S 3,930', W 2,750' of the NE cor Sec 21

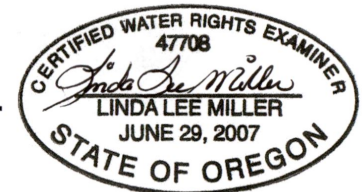

RENEWAL DATE 12/31/2020



**TRANSFER "OFF" MAP
Golden Rule Farms, LLC**

This map is not intended
to provide legal dimensions
or locations of property
ownership lines.


WATER RIGHT SERVICES, LLC
PO BOX 1830, BEND, OR 97709
WWW.OREGONWATER.US CCB # 197121
johnshort@usa.com 541-389-2837

RECEIVED
APR 04 2019
OWRD

13162

G 6770
51594

T.27S. R.17E. W.M.

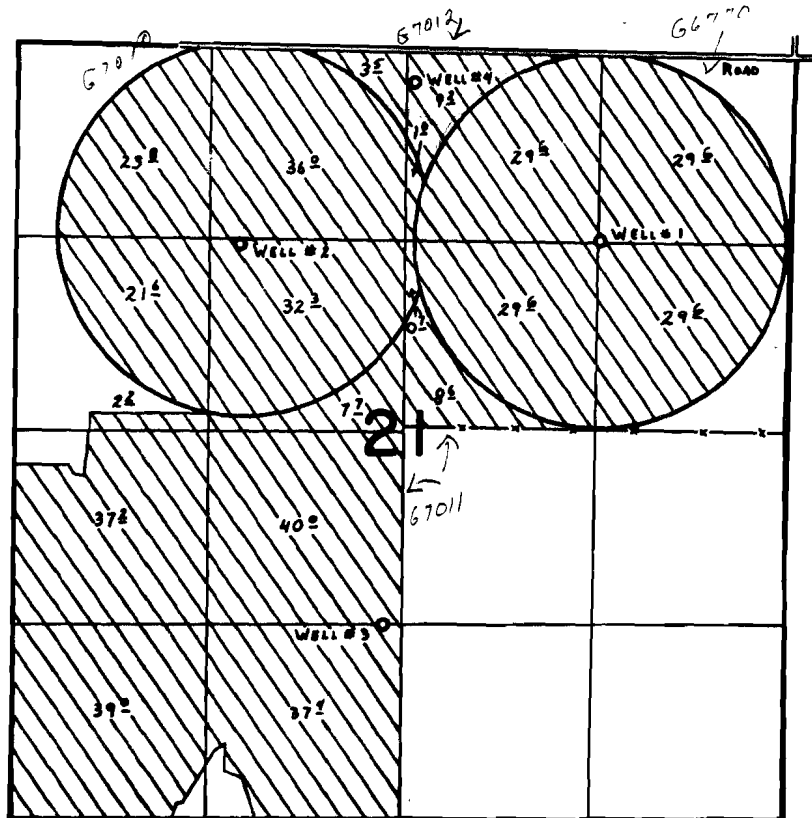

WELLS Loc:

- #1- 1280'S. { 1300'W. }
#2- 1350'S. { 3770'W. }
#3- 3780'S. { 2750'W. }
#4- 220'S. { 2610'W. }
ALL FROM N.E. COR. SEC. 21.

FINAL PROOF SURVEY

UNDER

G-7332
G-7539
G-7540

G-6770-^{#51594}
G-7010-^{#51594}
G-7011-^{#51594}

Application No. G-7541. Permit No. G-7012-^{#51594}

IN NAME OF

HASKEL & SHIRLEY A. BLACK

Surveyed Aug. 28, 1978, by S.P. APPELEGATE