


**T27S R17E, WM,
LAKE COUNTY, OR**




- Well
- POU IR CERT 82619 "OFF"
- POU IR CERT 82619 REMAINING "ON"
- Section
- Quarter Quarter
- Tax Lot

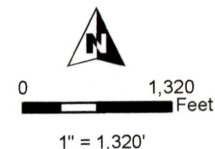

RENEWAL DATE 12/31/2020



13162

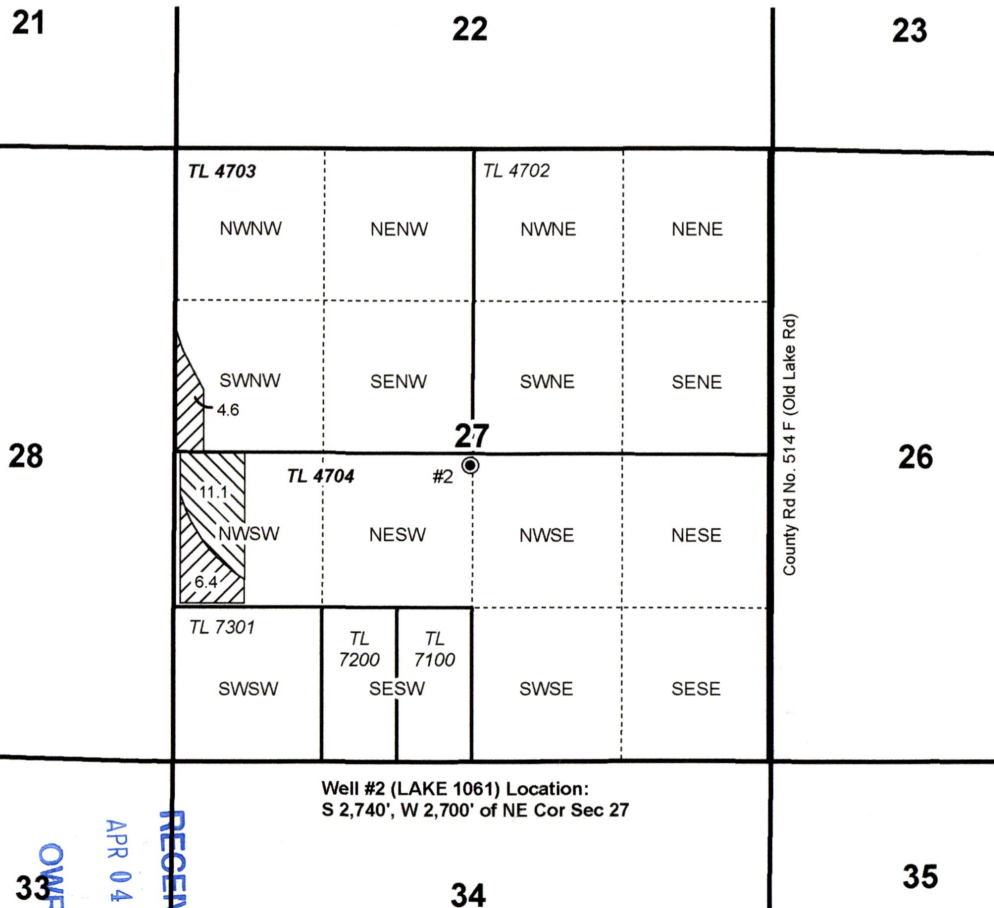

Well #2 (LAKE 1061) Location:
S 2,740', W 2,700' of NE Cor Sec 27

RECEIVED

APR 04 2019

OWRD

**TRANSFER "OFF" MAP
Golden Rule Farms, LLC**

PG 3 OF 17


Certificate 82619

Date: 3/4/2019

This map is not intended
to provide legal dimensions
or locations of property
ownership lines.

WATER RIGHT SERVICES, LLC
PO BOX 1830, BEND, OR 97709
WWW.OREGONWATER.US CCB # 197121
johnshort@usa.com 541-389-2837

T. 27 S. R. 17 E. W.M.

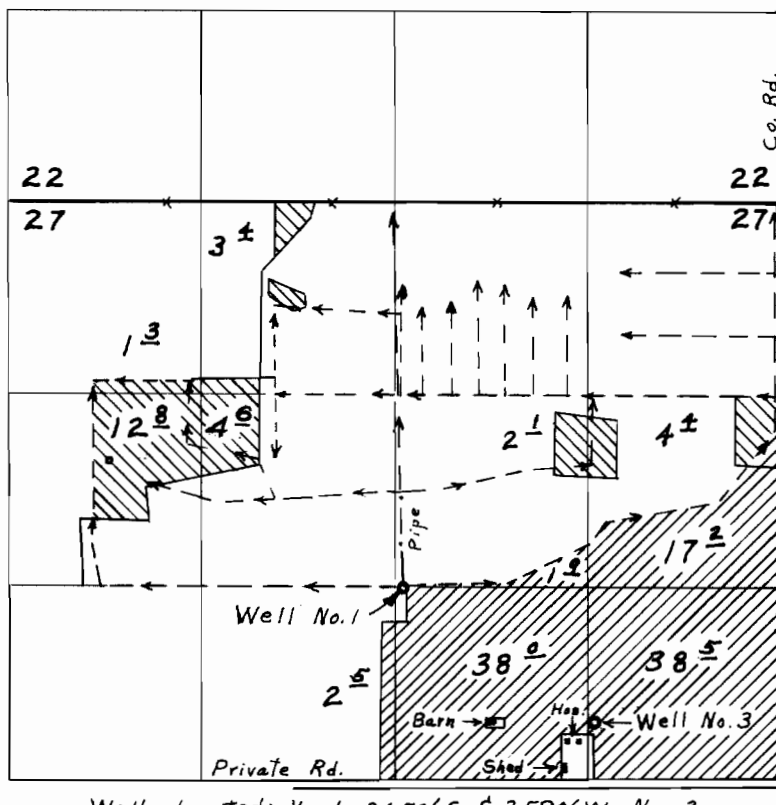

Wells located; No. 1, 2650' S. & 2590' W., No. 3, 3570' S. & 1290' W. both from N.E. Cor. Sec. 27

WELL No. 1 

WELL No. 3 

FINAL PROOF SURVEY UNDER

Application No. G-2292. Permit No. G-2165
IN NAME OF
CENTURY RANCH (LOSSIE HOWARD)

Surveyed July 30, 1968, by L. E. Gould