


T.4S. R.1E. Sec. 23, 24 & 25, W.M.

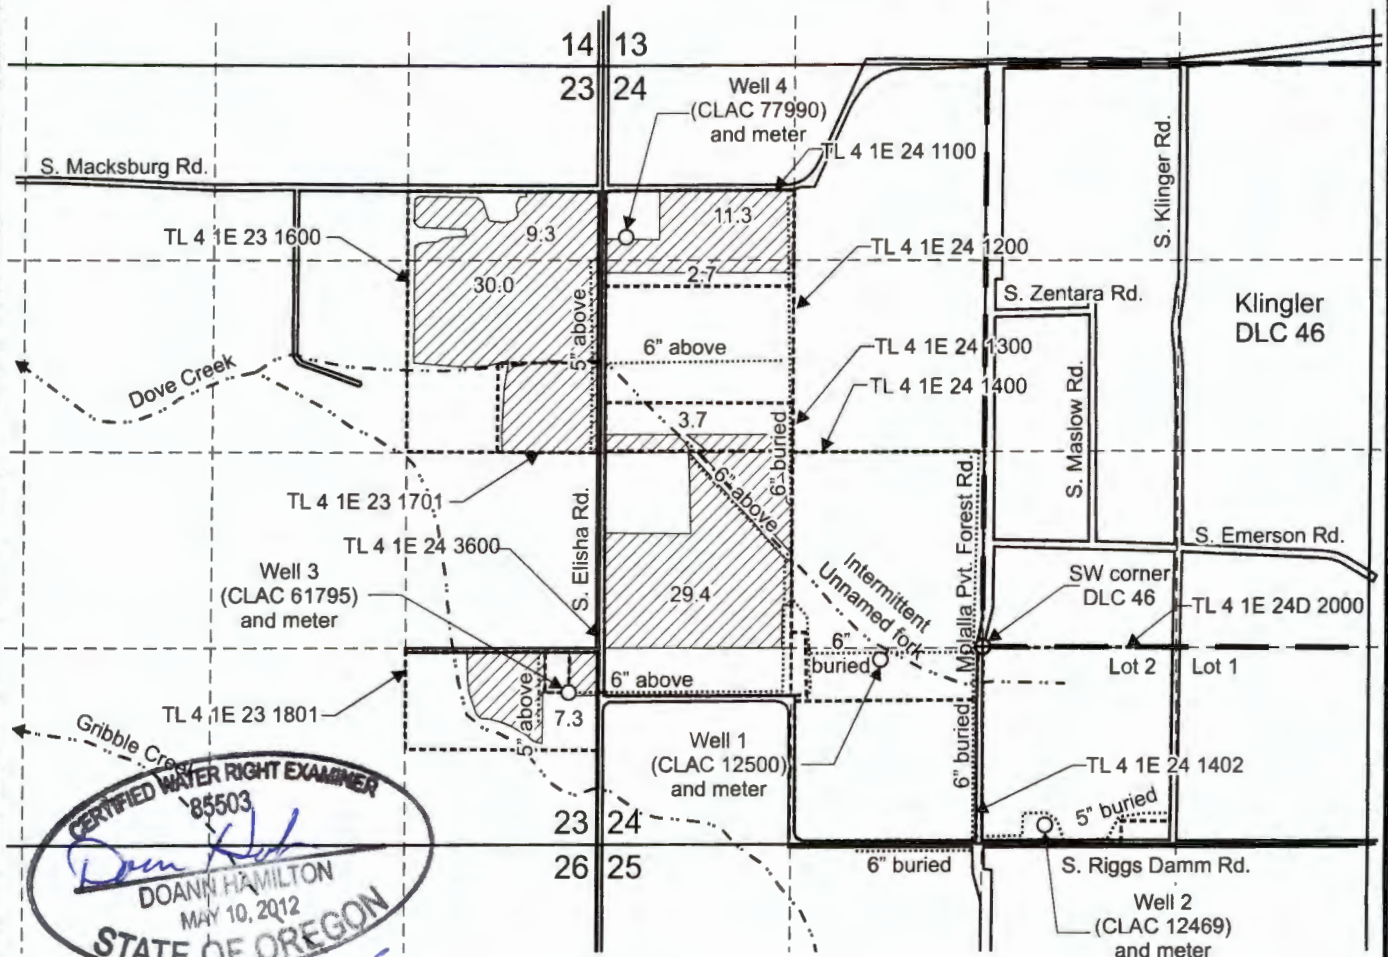




CERTIFIED WATER RIGHT EXAMINER
 85503
Doann Hamilton
 DOANN HAMILTON
 MAY 10, 2012
 STATE OF OREGON

EXPIRES: *June 30, 2025*

Well 1 (CLAC 12500) is located 1,250 feet north and 1,950 feet east from the SW corner, Section 24.
 Well 2 (CLAC 12469) is located 1,210 feet south and 430 feet east from the SW corner, DLC 46.
 Well 3 (CLAC 61795) is located 1,040 feet north and 200 feet west from the SE corner, Section 23.
 Well 4 (CLAC 77990) is located 1,160 feet south and 160 feet east from the NW corner, Section 24.

 Area (93.7 Acres), nursery use under Application G-16289, Permit G-18483.

-  Donation Land Claim boundary
-  Tax lot boundary
-  Irrigation mainlines

RECEIVED
 NOV 17 2023
OWRD

Scale: 1" = 1,320'



This map was prepared for the purpose of identifying the location of a water right only and is not intended to provide legal dimensions or location of property ownership lines.

Claim of Beneficial Use Map
 Application G-16289, Permit G-18483, T-13426

Pacific Hydro-Geology Inc.

Steve Koch
 T.4S. R.1E. Sec. 23, 24 & 25, W.M.

10/2023

KochG-16289COBUMap.cdr