


RECEIVED
MAY 01 2020
OWRD

T.9S., R.27E., W.M.

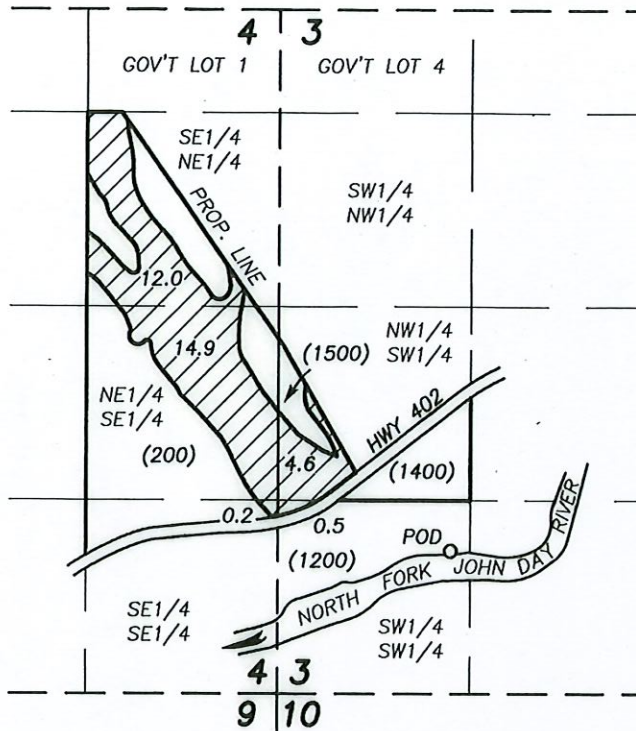

SCALE: 1" = 1320'

○ POD & FISHSCREEN: 3605 FT. SOUTH & 1140 FT. EAST FROM THE CLOSING CORNER MONUMENT BETWEEN SECTIONS 3 & 4
FLOW METER BEARS N.02°W., 30 FT. FROM POD

**FINAL PROOF SURVEY
UNDER T-11527
SPECIAL ORDER VOL. 93, PAGE 103**


IN NAME OF
LARRY BLAKESLEE

PREPARED BY
ROBERT D. BAGETT, PLS, CWRE
217 N. CANYON BLVD.
JOHN DAY, OREGON
(541) 575-1251

APRIL 23, 2020

 PLACE OF USE

() TAX LOT

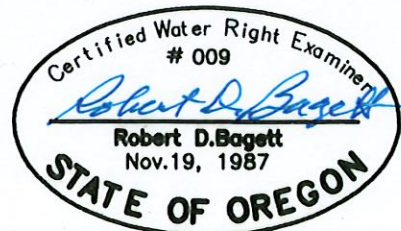

DISCLAIMER: THIS MAP IS NOT INTENDED TO PROVIDE LEGAL DIMENSIONS FOR LOCATIONS OF PROPERTY OWNERSHIP LINES.

RENEWS 12/31/2021