

RECEIVED

MAY 11 2020


OWRD

Scale 1"=1320'
(4"=1 mile)

RECEIVED

APR 22 2020

OWRD

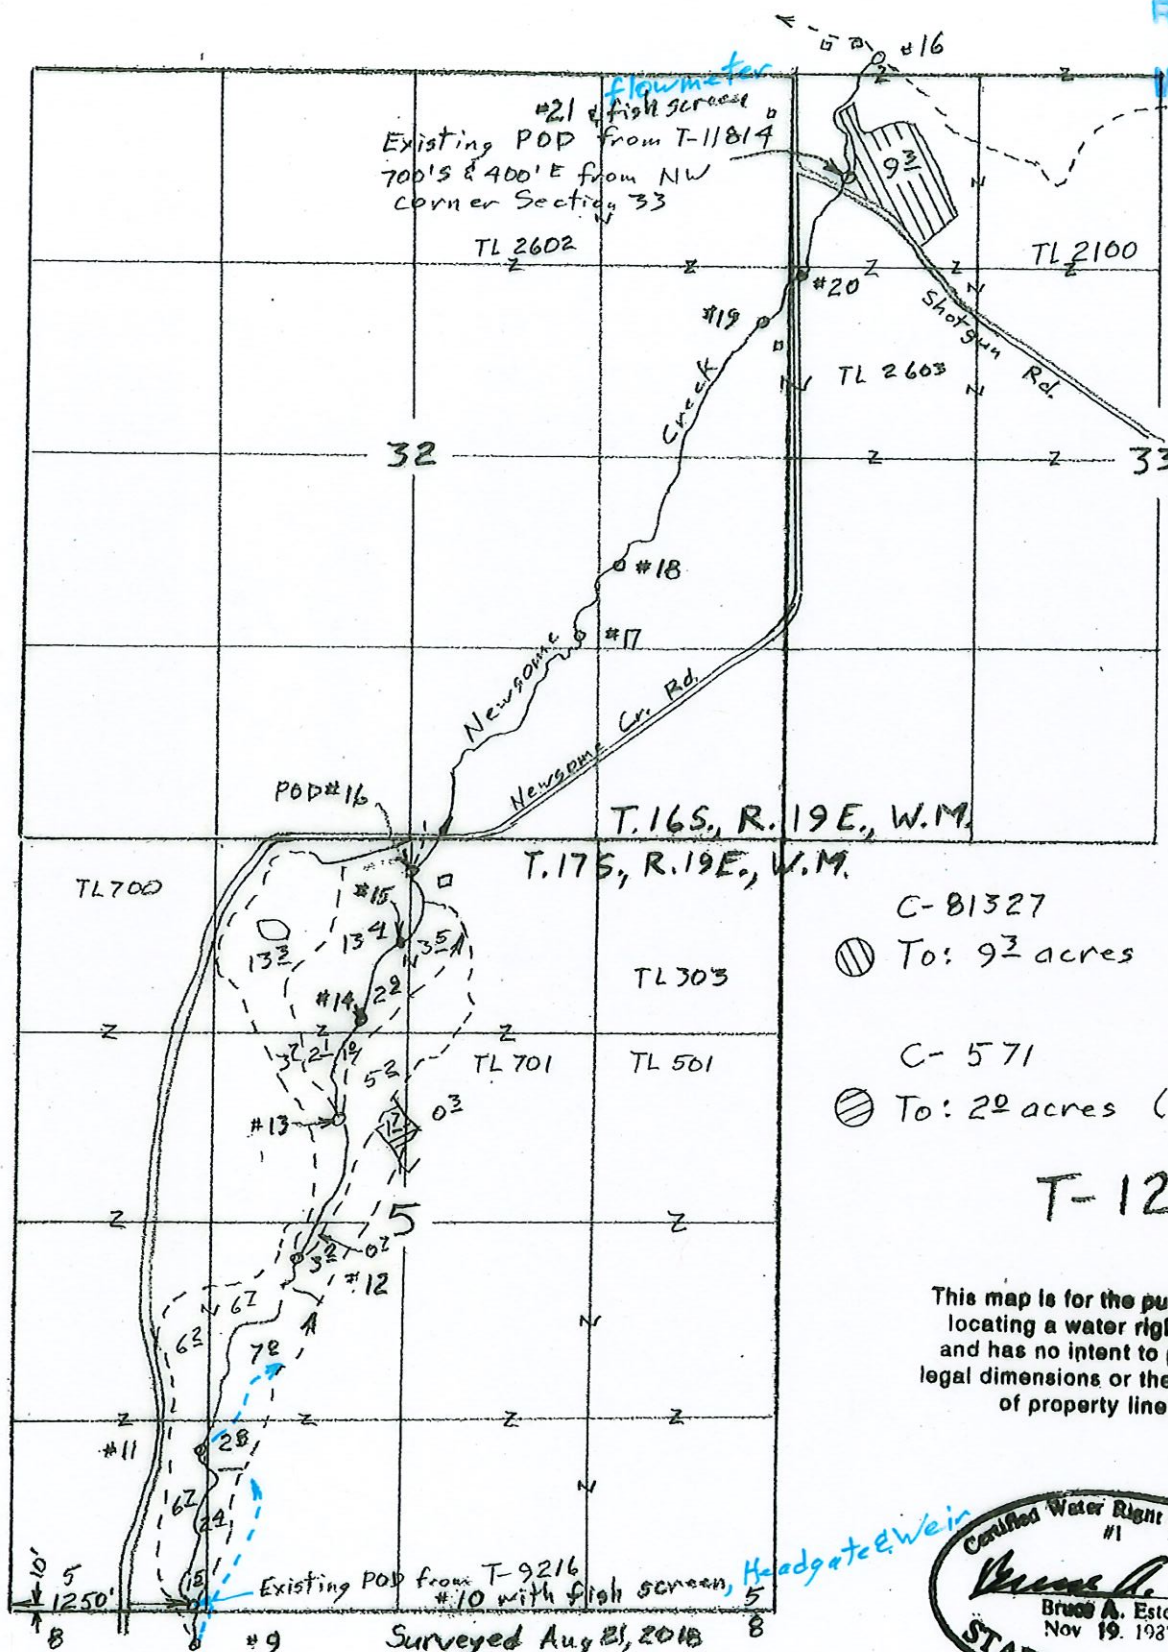

C-81327


⊗ To: 93 acres (1879)

C-571

⊗ To: 22 acres (1890)

T-12178

This map is for the purpose of
locating a water right only
and has no intent to provide
legal dimensions or the location
of property lines.

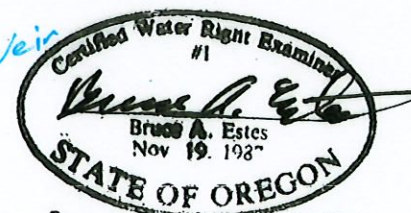

Renewal Dec 31, 2019

Claim of Beneficial Use Map
for
Aspen Valley Ranch

ESTES SURVEYS, LLC

PO Box 17510
Salem, OR 97305-7519
(503) 585-7503

60382 Arnold Rd
Bend, OR 97702
(541) 382-7381