

RECEIVED

MAY 11 2020


OWRD

Scale 1" = 1320'
(4" = 1 mile)

RECEIVED

APR 22 2020

OWRD

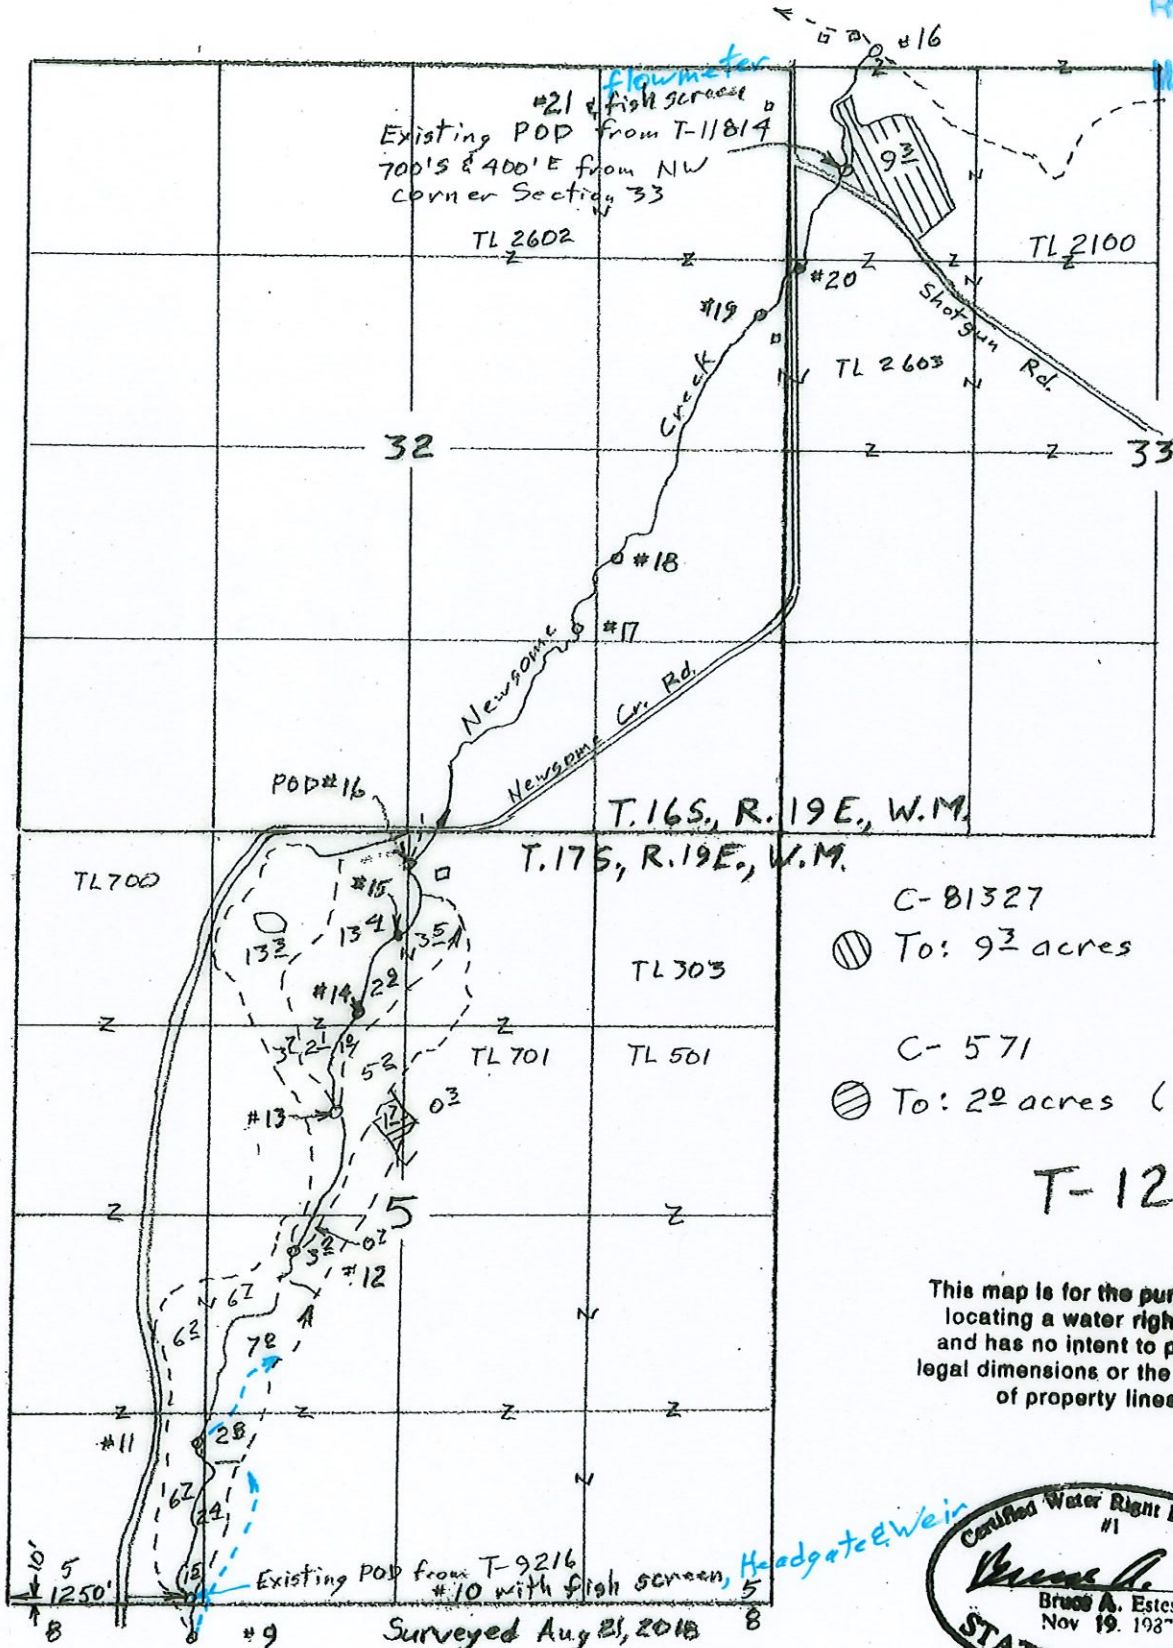


C-81327
 To: 93 acres (1879)

C-571
 To: 22 acres (1890)

T-12178

This map is for the purpose of locating a water right only and has no intent to provide legal dimensions or the location of property lines.

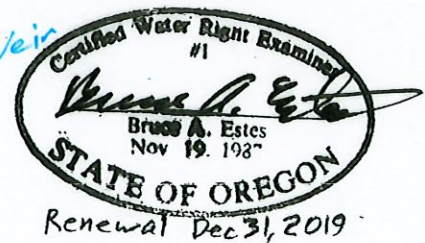

Claim of Beneficial Use Map
 for
 Aspen Valley Ranch

ESTES SURVEYS, LLC
 PO Box 17510 60382 Arnold Rd
 Salem, OR 97305-7510 Bend, OR 97702
 (503) 305-7503 (541) 382-7391