


Transfer Application - Certificate 54436

Whitehead

Township 10S, Range 2W, W.M.

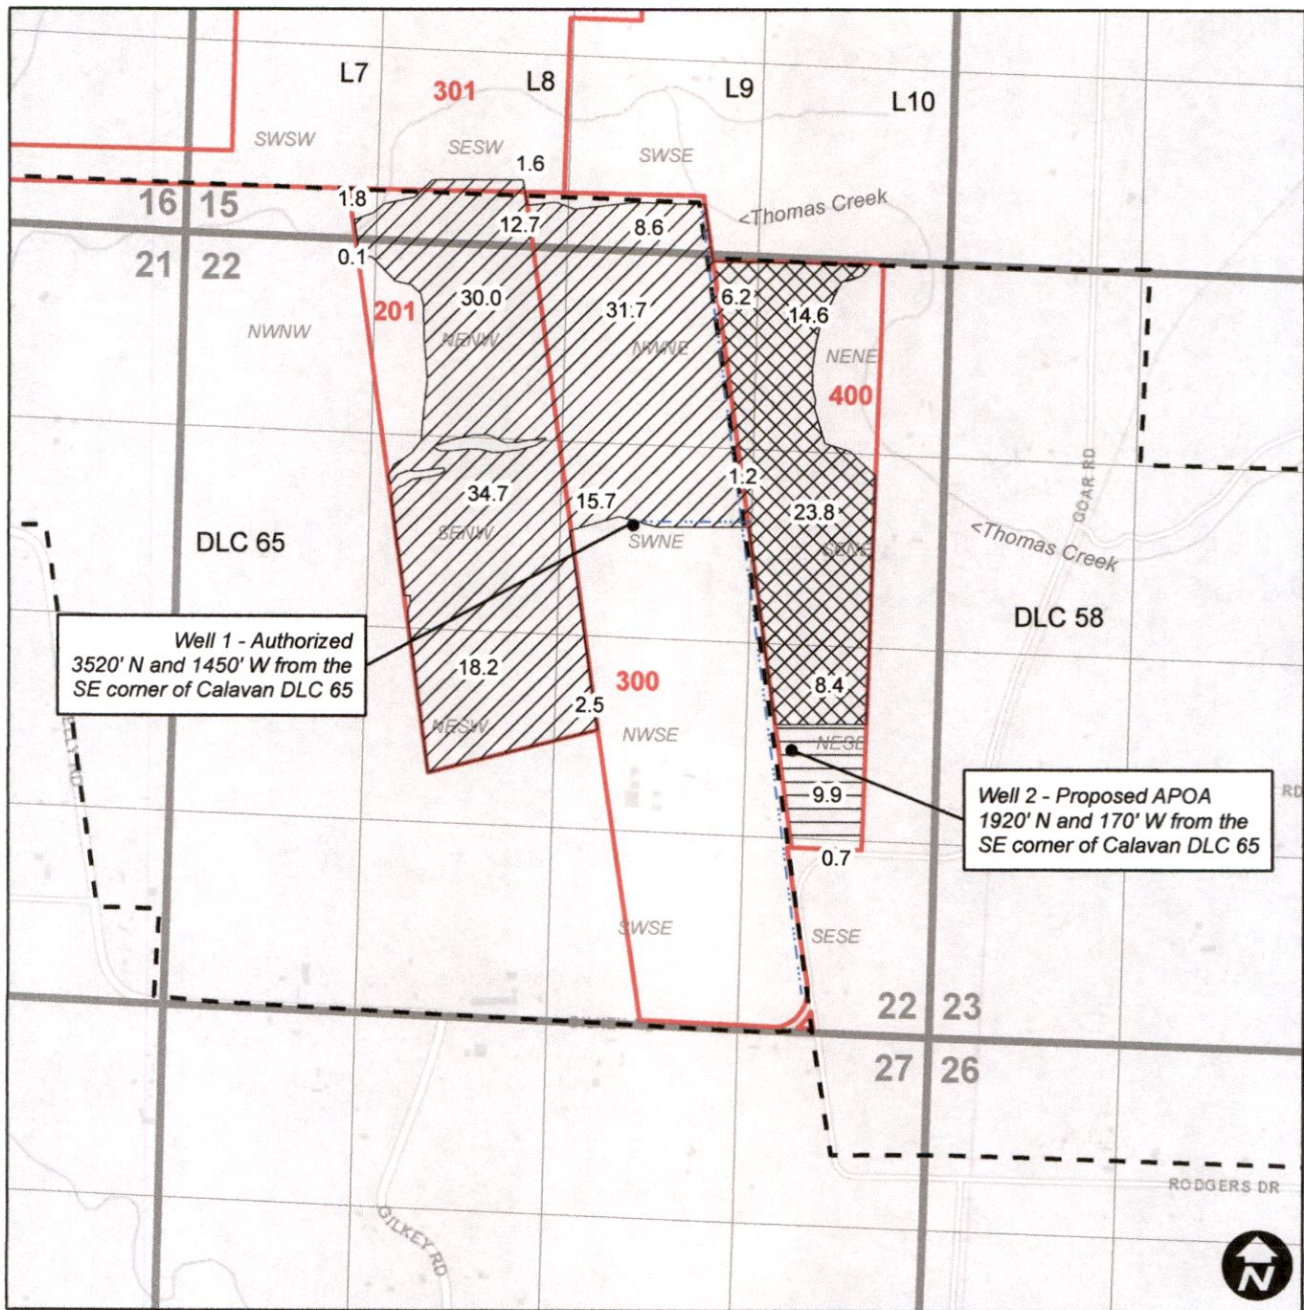


Legend

- | | | | |
|--|--------------------------|--|----------|
| | Cert. 54436 IR APOA | | Mainline |
| | Cert. 54436 IS APOA | | Taxlots |
| | Cert. 54436 IS No Change | | DLC |



T.10S., R.2W., W.M.

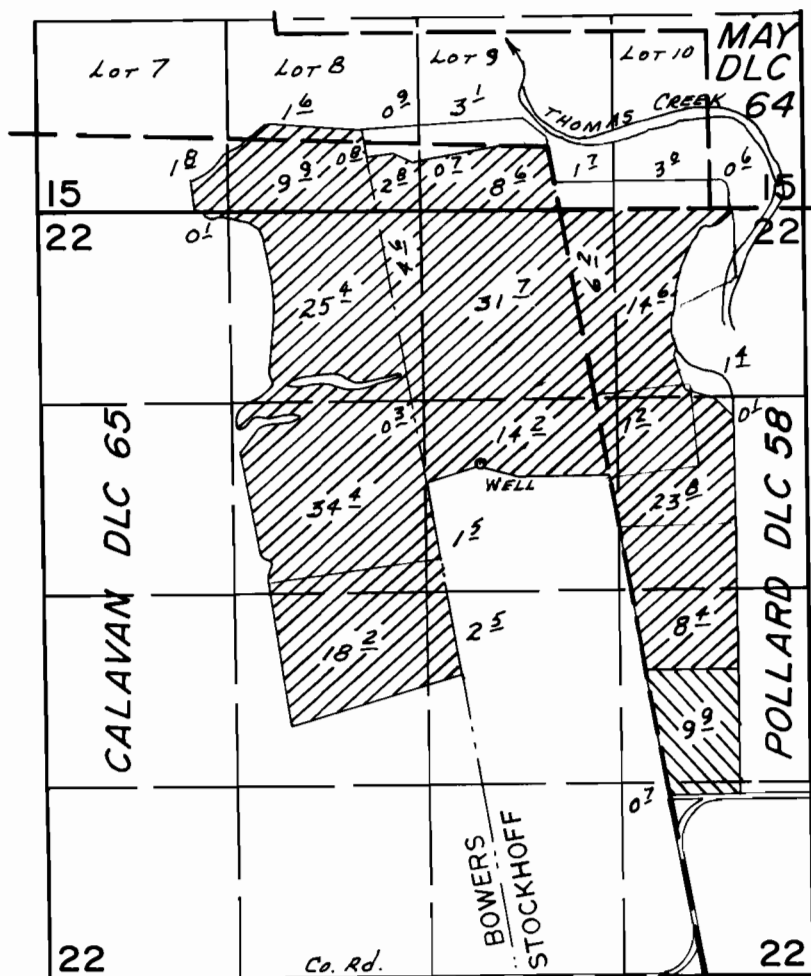

WELL LOCATED 3520' N. & 1450' W. FROM SE COR. DLC 65

PRIMARY
SUPPLEMENTAL

FINAL PROOF SURVEY UNDER

Application No. G-7879. Permit No. G-7294.....
IN NAME OF

ROBERT L. STOCKHOFF

Surveyed JULY 6, 1982, by L.M. TOLL.....