


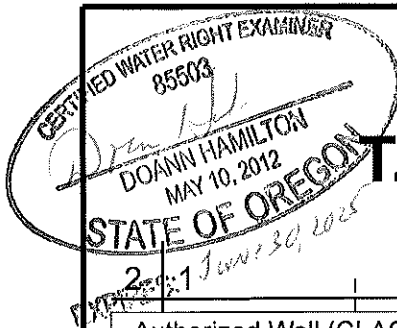

T.5S. R.1E. Sec. 12 & 13
T.5S. R.2E. Sec. 7 & 18, W.M.

Received
APR 15 2024


OWRD

Authorized Well (CLAC 10027) is located 1,030 feet south and 1,330 feet east from the NW corner, DLC 41.


Proposed Well 1 (CLAC 52833) is located 1,470 feet north and 435 feet east from the SW corner, Section 7.

Proposed Well 2 is located 580 feet south and 465 feet east from the NW corner, Section 18.

- Area (90.2 Acres) irrigated under Certificate 75769, priority date June 8, 1965, not affected by this transfer
- Area (46.3 Acres) irrigated under Certificate 75769, priority date June 8, 1965, affected by this transfer

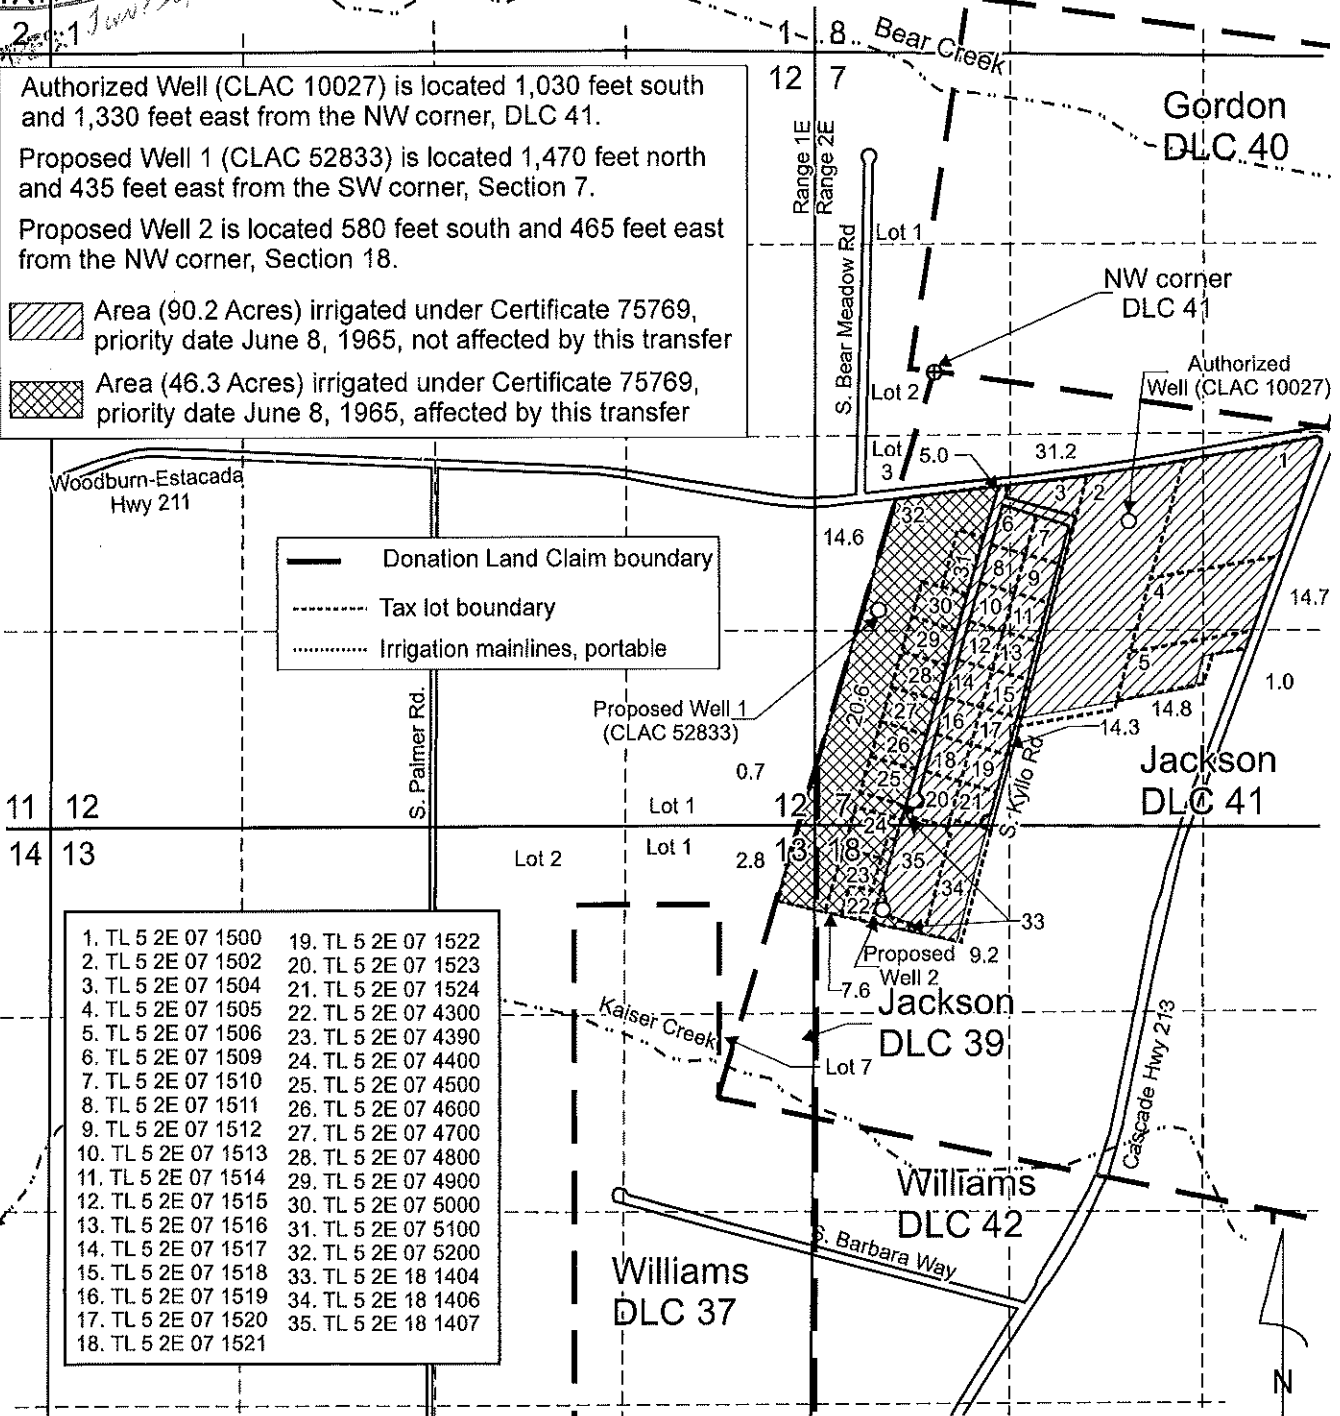

1. TL 5 2E 07 1500	19. TL 5 2E 07 1522
2. TL 5 2E 07 1502	20. TL 5 2E 07 1523
3. TL 5 2E 07 1504	21. TL 5 2E 07 1524
4. TL 5 2E 07 1505	22. TL 5 2E 07 4300
5. TL 5 2E 07 1506	23. TL 5 2E 07 4390
6. TL 5 2E 07 1509	24. TL 5 2E 07 4400
7. TL 5 2E 07 1510	25. TL 5 2E 07 4500
8. TL 5 2E 07 1511	26. TL 5 2E 07 4600
9. TL 5 2E 07 1512	27. TL 5 2E 07 4700
10. TL 5 2E 07 1513	28. TL 5 2E 07 4800
11. TL 5 2E 07 1514	29. TL 5 2E 07 4900
12. TL 5 2E 07 1515	30. TL 5 2E 07 5000
13. TL 5 2E 07 1516	31. TL 5 2E 07 5100
14. TL 5 2E 07 1517	32. TL 5 2E 07 5200
15. TL 5 2E 07 1518	33. TL 5 2E 18 1404
16. TL 5 2E 07 1519	34. TL 5 2E 18 1406
17. TL 5 2E 07 1520	35. TL 5 2E 18 1407
18. TL 5 2E 07 1521	

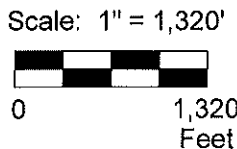

This map was prepared for the purpose of identifying the location of a water right only and is not intended to provide legal dimensions or location of property ownership lines.

Transfer Application Map
Certificate 75769
Joe Weber
T.5S. R.1E. Sec. 12 & 13,
T.5S. R.2E. Sec. 7 & 18, W.M.


Pacific Hydro-Geology Inc.

02/2021
Rev. 04/2024

WeberTransCert75769Map.cdr

T-13706

T.5 S.R.18 2 E.W.M.

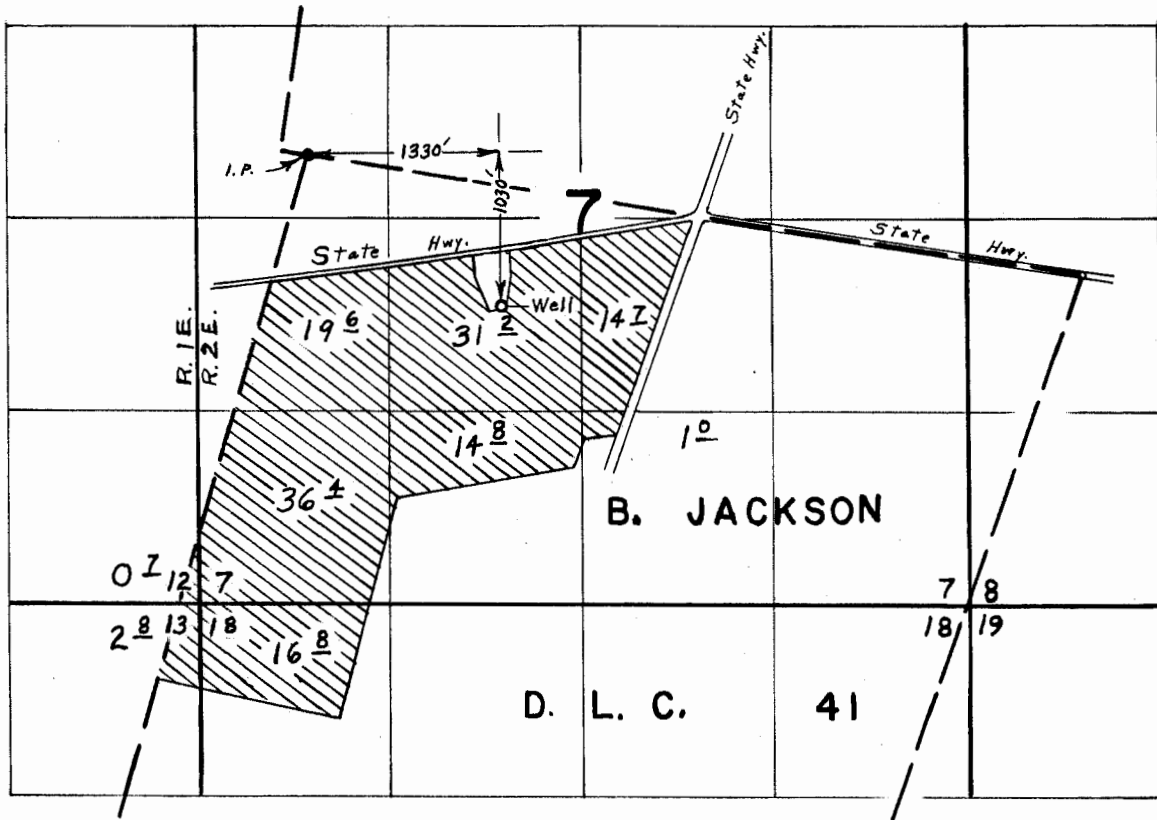

FINAL PROOF SURVEY
UNDER

Application No. G-3129. Permit No. G-2958
IN NAME OF

GEORGE KYLLO

Surveyed Oct. 19, 1967, by L. E. Gould