


Transfer Application T-8290

Claim of Beneficial Use




Township 5S, Range 1W, W.M.

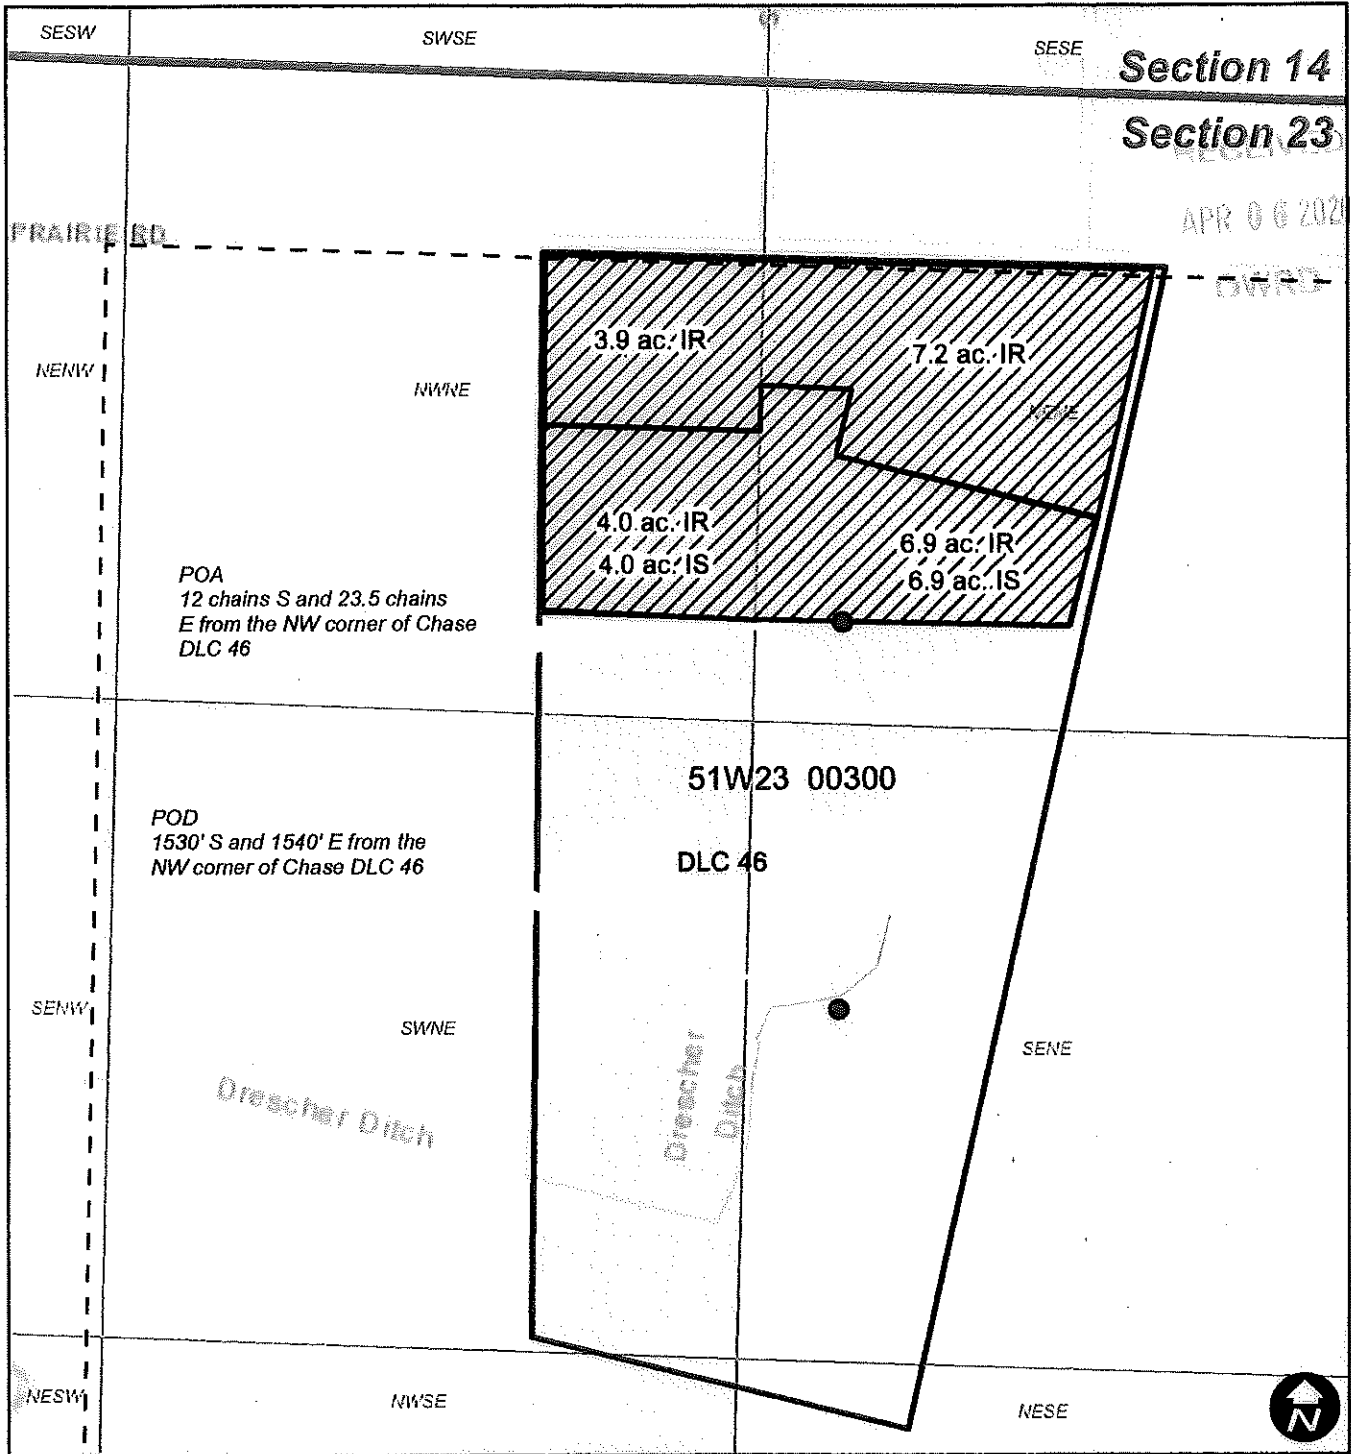

APR 06 2021

0 200 400 Feet

This map is not intended to provide legal dimensions or locations of property ownership lines.

- Legend**
-  Place of Use
 -  Tax Lot
 -  DLC



EXPIRES: 12/31/2020