


CLAIM OF BENEFICIAL USE MAP FOR ARIE & JENNEKE DEJONG SECTION 16, 17, AND 20, TOWNSHIP 39 SOUTH RANGE 11 EAST, KLAMATH COUNTY, OREGON

LEGEND

- SECTION LINE
- 1/4 SECTION LINE
- 1/16 SECTION LINE
- IRRIGATION MAIN LINE
- WHEEL LINE
- PRIMARY IRRIGATION
- SUPPLEMENTAL IRRIGATION

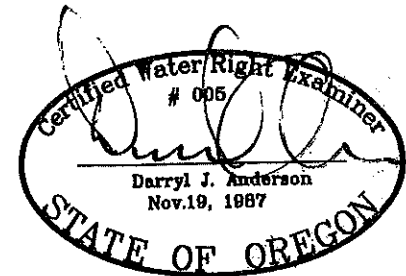

RENEWAL 12/31/07

APPLICATION NO. G-12768
PERMIT NO. G-12447

NOTE:
PREPARATION OF THIS MAP IS FOR IDENTIFYING PROPOSED
WATER RIGHTS ONLY. IT HAS NO INTENT TO PROVIDE
LOCATIONS OR DIMENSIONS OF PROPERTY BOUNDARIES.

COBU MAP #0278

RECEIVED

JUL 27 2007

WATER RESOURCES DEPT
SALEM, OREGON

REVISION	BY

**ANDERSON ENGINEERING
AND SURVEYING, INC.**
P.O. BOX 28
LAKEVIEW, OREGON
97630 (541)
947-4407 FAX
947-2321

FOR:
ARIE & JENNEKE DEJONG
4721 HARPOLD RD.
BONANZA OR, 97823
(541) 545-6173

**CLAIM OF BENEFICIAL USE
APPLICATION NO. G-12768
PERMIT NO. G-12447**

DATE:	1/26/2007
SCALE:	1"=1320'
DWG. BY:	R.C.
JOB:	G-12447
FILE:	2008-128
SHEET:	1 OF 1