
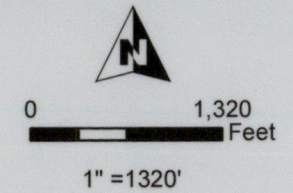


T20S R20E, WM CROOK COUNTY, OR

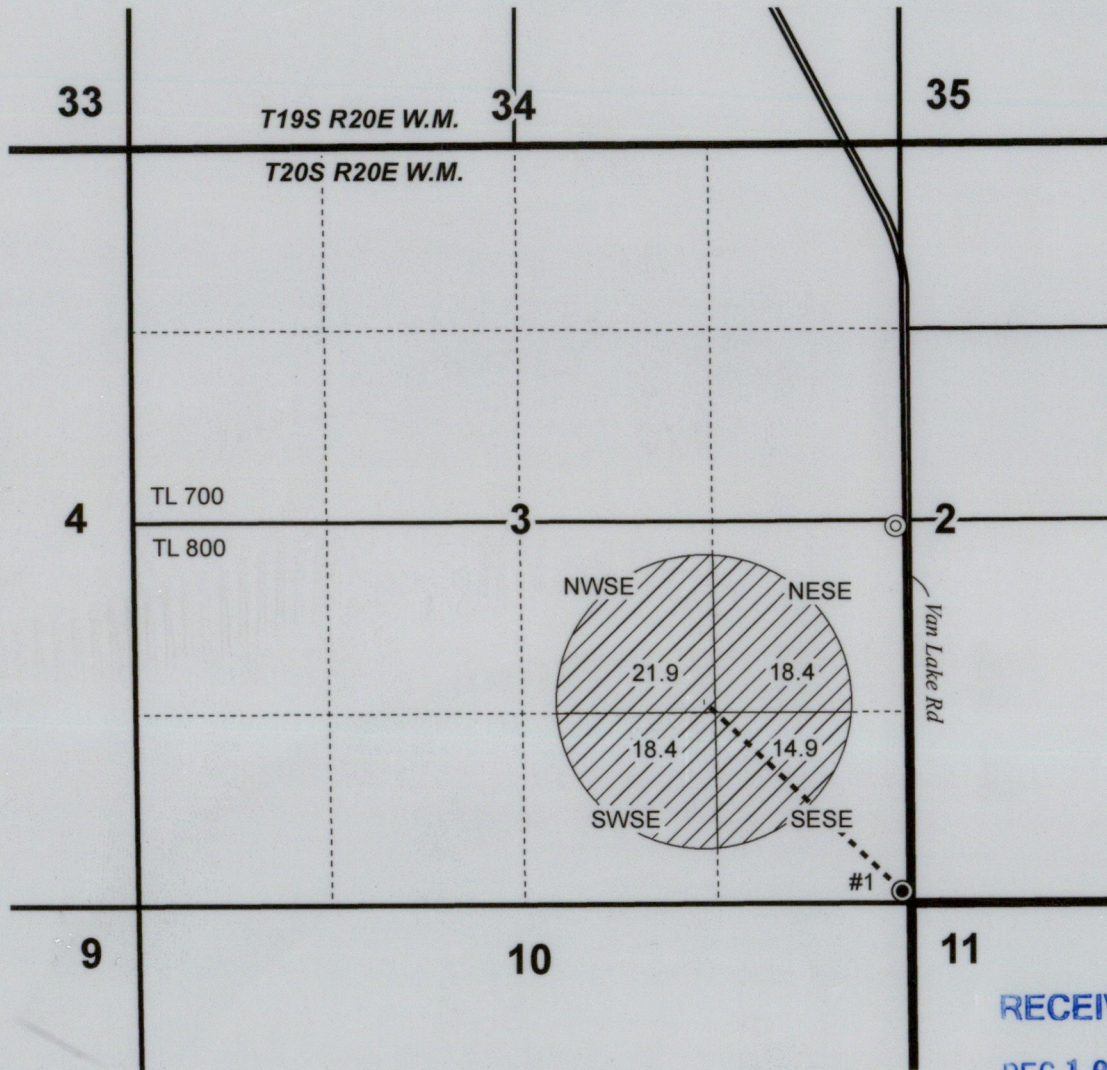


- Well & Meter
- Observation Well
- Pipeline
- POU IR
- Township
- Section
- Quarter Quarter
- Tax Lot

Well Locations:

Well #1 CROO 53256/53447 (L-86785):
80' N, 60' W of SE Cor Sec 3

Observation Well CROO 53448/53504 (L-86831):
40' S, 60' W of E 1/4 Cor Sec 3

RECEIVED
DEC 18 2023
OWRD

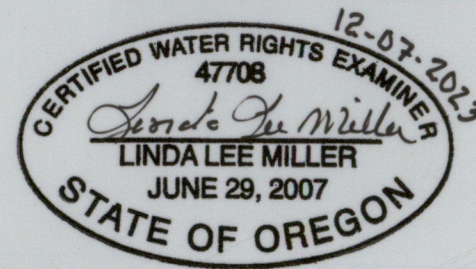

RENEWAL DATE 12/31/2024

**CLAIM OF BENEFICIAL USE MAP
C.B. FOSS**

Date: 12/7/2023

Ap G- 16976 / Permit G-16766

Project #23056

This map is not intended
to provide legal dimensions
or locations of property
ownership lines.

WATER RIGHT SERVICES, LLC
PO BOX 1830, BEND, OR 97709
WWW.OREGONWATER.US CCB # 197121
johnshort@usa.com 541-389-2837