


- POA - Center of Sump
- ⊙ Pump
- Pipeline
- ▨ Sump
- ▨ POU CO 06/30/1997 Priority
- Township
- Section
- Quarter Quarter
- Tax Lot



**T28S R14W, WM,  
COOS COUNTY, OR**

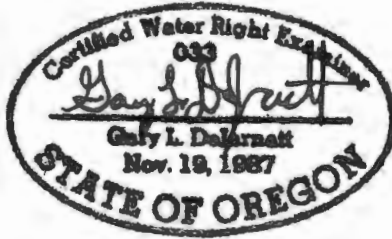


RENEWAL DATE 12/31/2023

1" = 400'

POA (Center of Sump) Locations:

Sump #1: 520' N, 960' E of SW Cor Sec 32  
Sump #2: 550' N, 400' E of SW Cor Sec 32

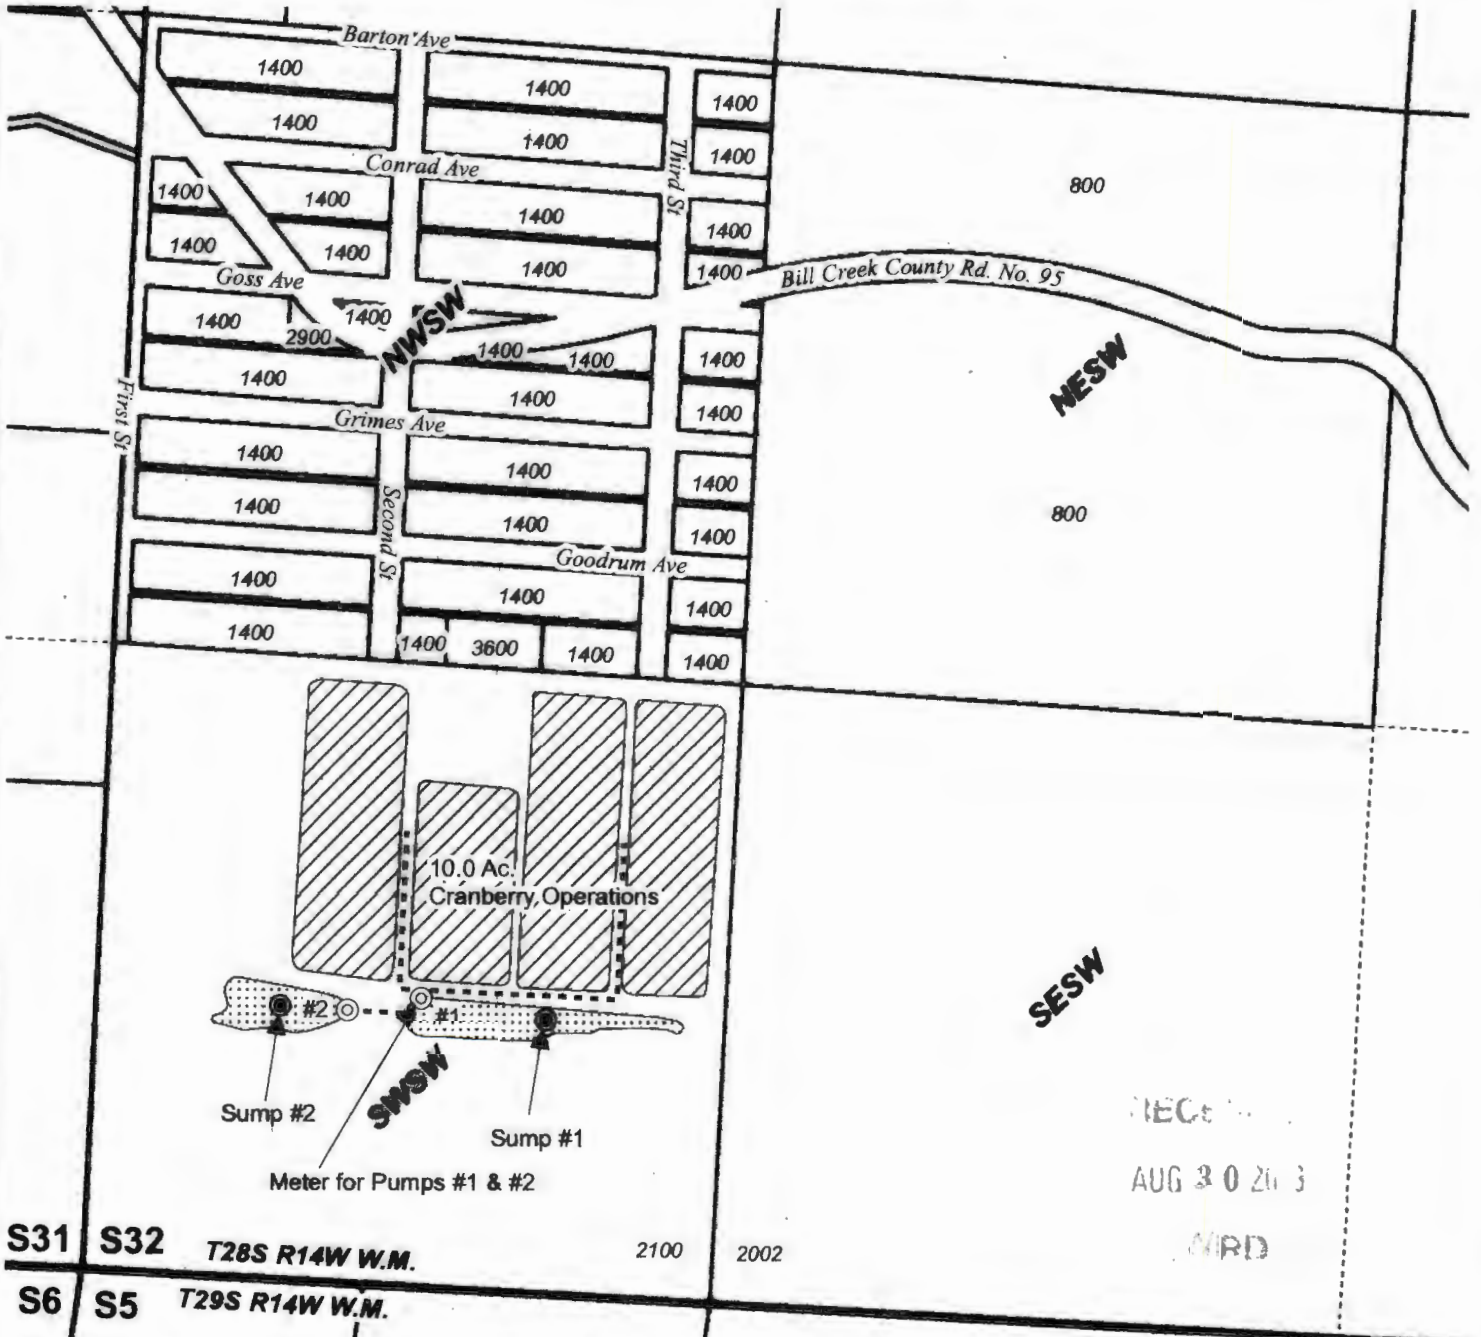

S31 S32 T28S R14W W.M. 2100 2002  
S6 S5 T29S R14W W.M.

REC'D  
AUG 30 2023  
CIRD

**CLAIM OF BENEFICIAL USE MAP**  
Webb Project #23027

Date: 7/10/2023

Ap G-14559 / Permit G-13328

This map is not intended to provide legal dimensions or locations of property ownership lines.

**WATER RIGHT SERVICES, LLC**  
PO BOX 1830, BEND, OR 97709  
[WWW.OREGONWATER.US](http://WWW.OREGONWATER.US) CCB # 197121  
johnshort@usa.com 541-389-2837