
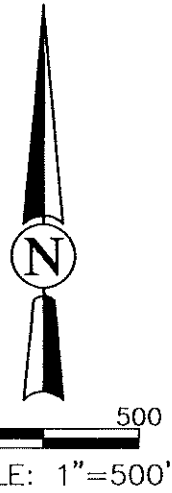





**CLAIM OF BENEFICIAL USE MAP
LOCATED IN THE NORTHEAST 1/4 OF
SECTION 5, TOWNSHIP 25 SOUTH, RANGE
11 WEST, W.M., COOS COUNTY, OREGON**

THIS MAP IS NOT
INTENDED TO PROVIDE
LEGAL DIMENSIONS OR
LOCATIONS OF PROPERTY
OWNERSHIP LINES.

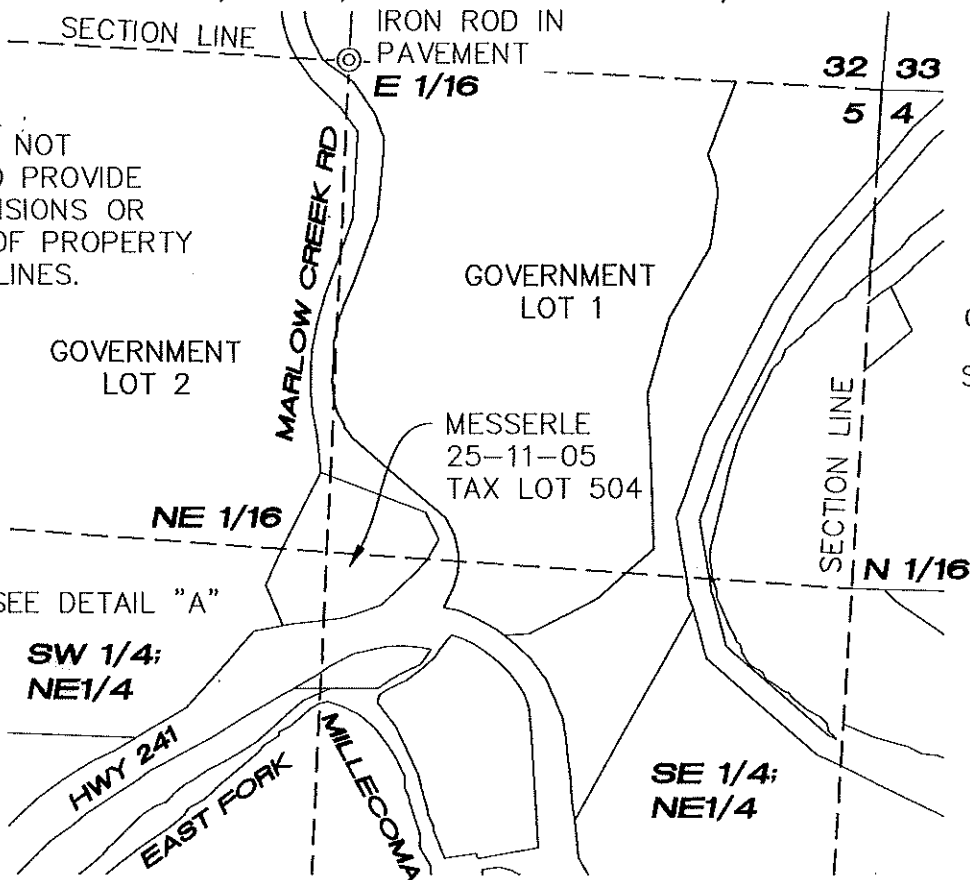

RECEIVED
MAR 16 2023

OWRD

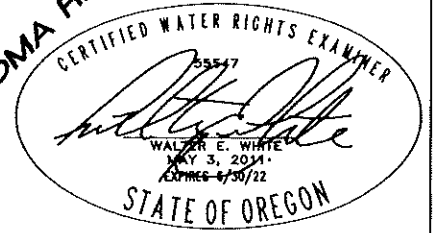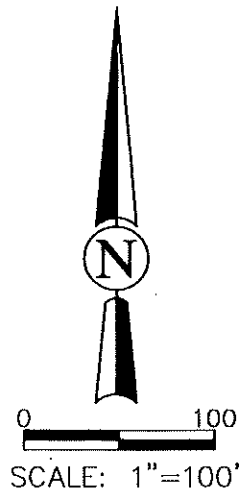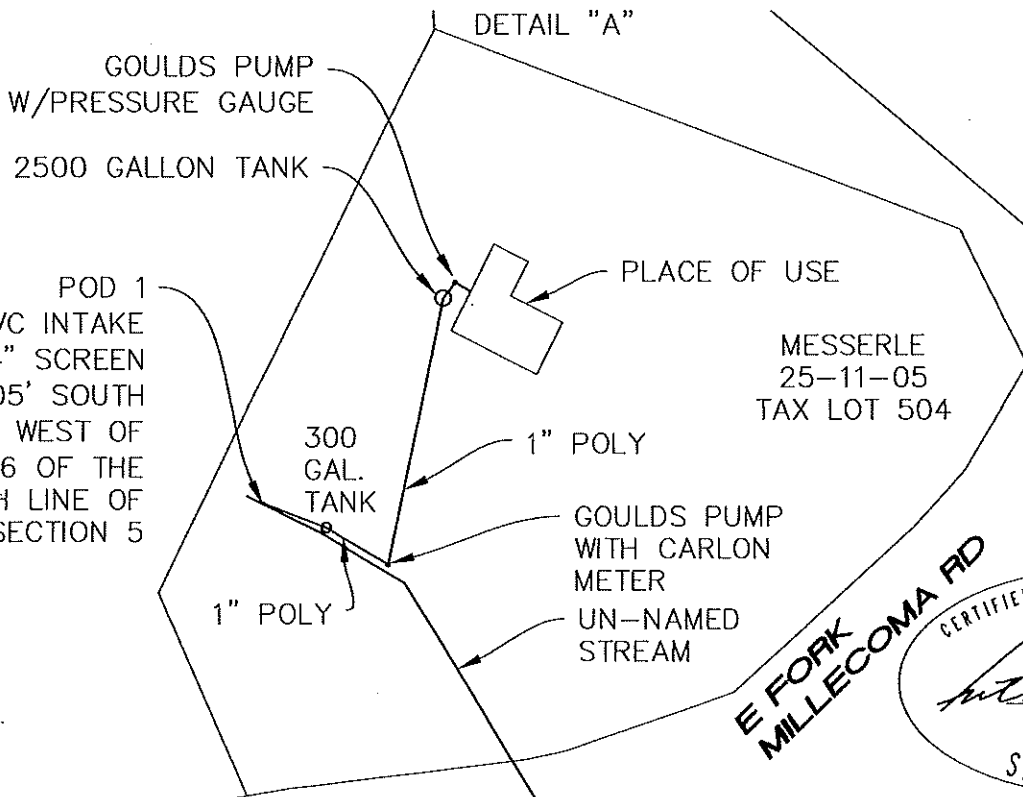

\\CoosBay-FS\Projects\2023\623036-Messerle\Drawings\SAVED:3/1/2023 10:20 AM WWHITE, PLOTTED:3/1/2023 10:22 AM, WHITE, WALTER



Messerle
Water Rights
Coos County, Oregon
March 1, 2023
623036v

Application: S-88928/ Permit: S-55359
Claim of Beneficial Use
SHN 623036
Figure 1