

Map for Cancellation
a portion of
Certificate 20365
Tax Lot 362W15-300
T 36 S, R 2 W, Sec 10, W.M.

SE SE

SW SW

4.9 ac

#1 drain

10

11

NE NE

15

14

NW NW




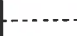
T1 362W15-300

#2 drain

Unnamed slough

RECEIVED
JUN 02 2008
WATER RESOURCES DEPT.
SALEM, OREGON

Legend


-  Water right certificate 20365
-  Water right to be cancelled
-  Section line
-  Quarter-quarter line

N

0 400 Feet

Rogue River

T. 36 S., R. 2 W., W.M.

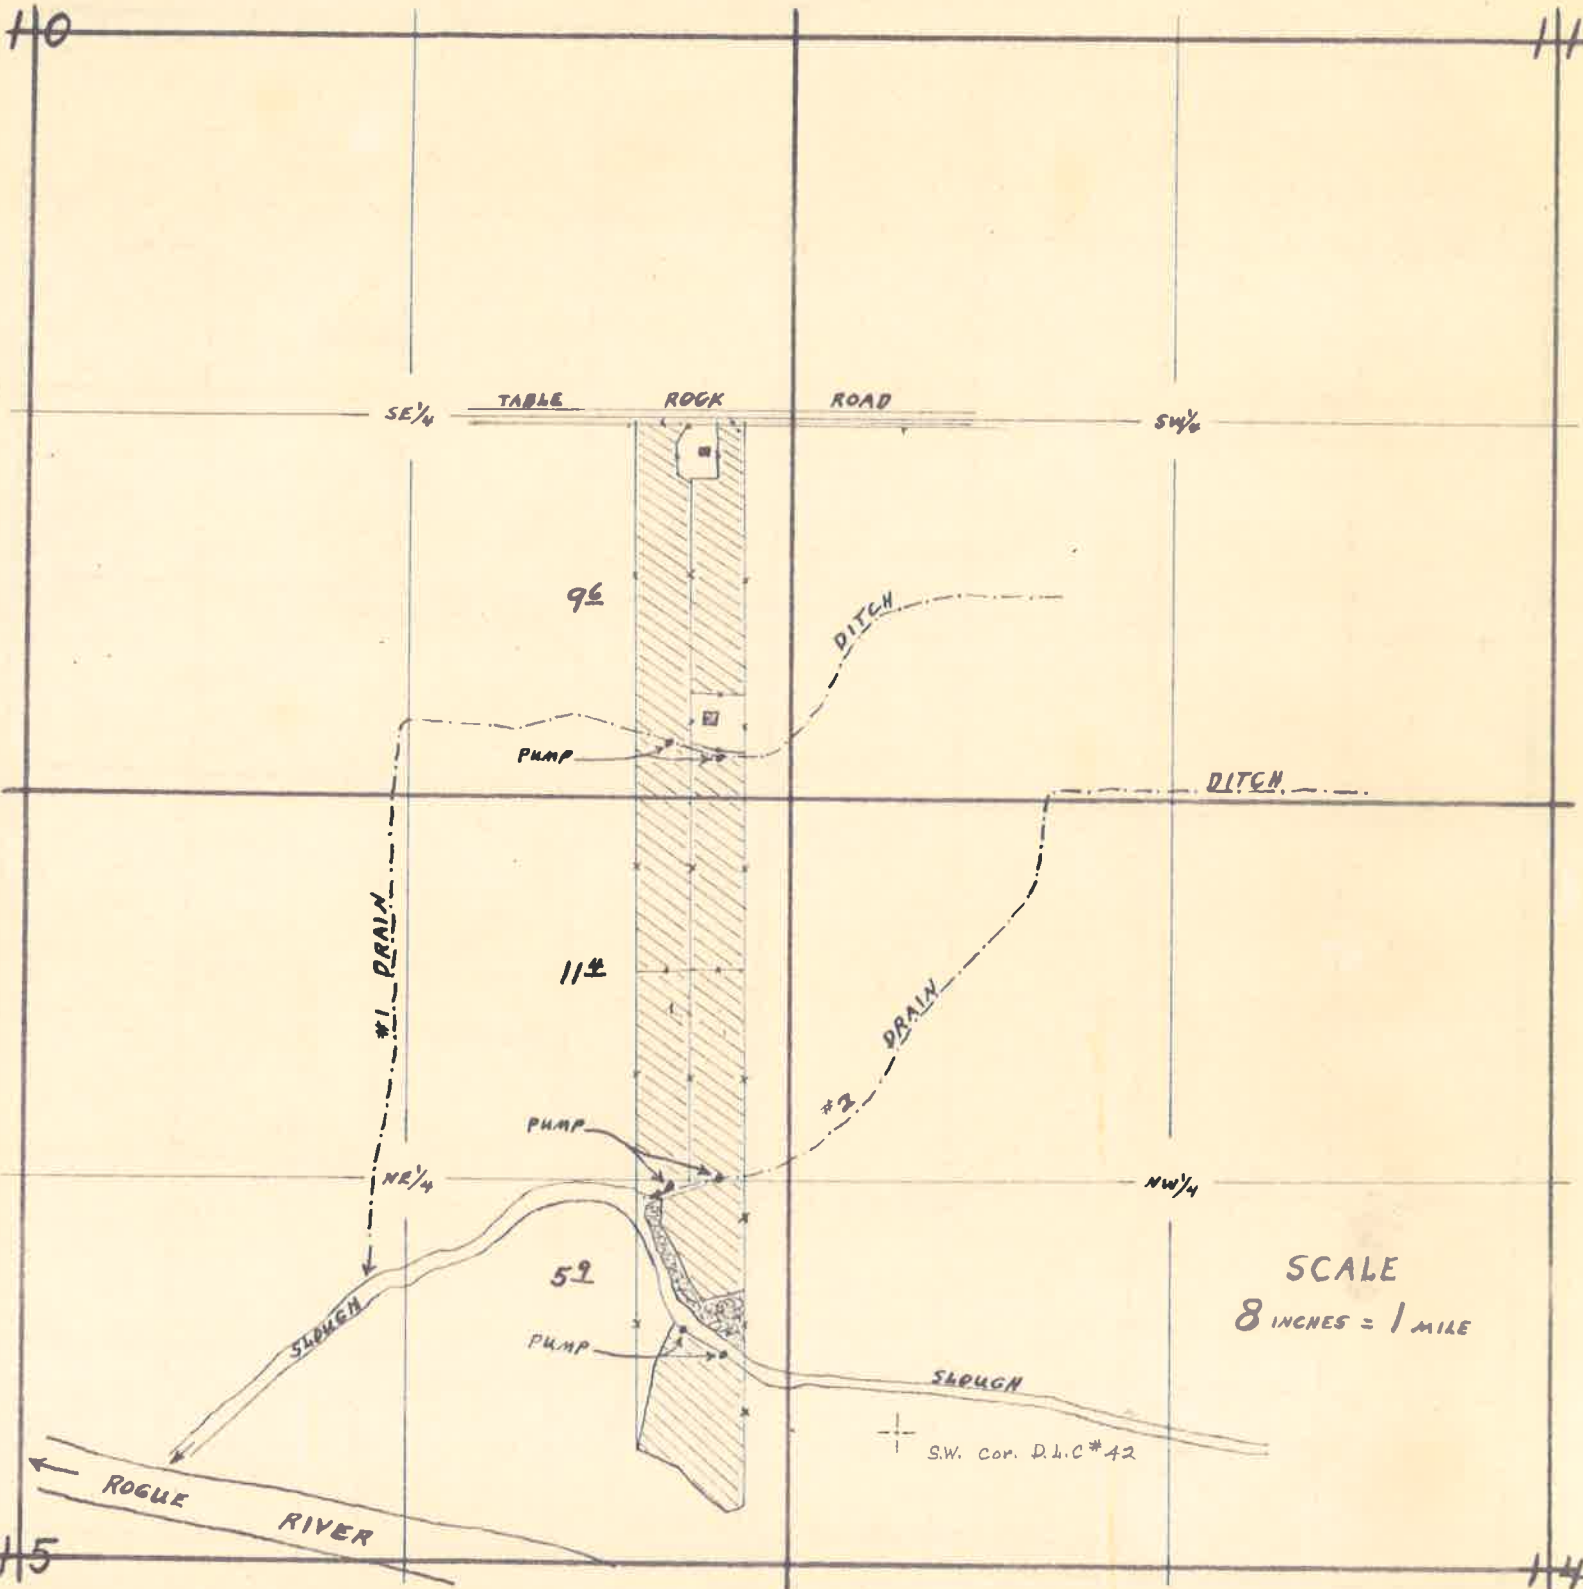

SCALE
 8 INCHES = 1 MILE

MAP ACCOMPANYING FINAL PROOF OF WILLIAM H. BISHOP, FOR USE OF WATER FROM #1 DRAIN DITCH, #2 DRAIN DITCH, AND SLOUGH FOR IRRIGATION PURPOSES.

PERMIT NO. 22381
 APPLICATION NO. 28365

MAP COPIED FROM PLANE TABLE SURVEY - MADE 3-5-54.





CERT. 20365

David L. Hendrix
 WATERMASTER DIST. NO. 15



Scale: 1"=400'
Date: January 19, 2023

LEGEND

- Denotes Found Corner Survey No. 23217
-  Denotes Area From Certificate 84246 Change Place Of Use
-  Denotes Area To Certificate 84246 Change Place Of Use
-  Denotes Area Certificate 84246 No Change In Place Of Use
Denotes Drainage Ditch No. 1 Certificate 84246
-  Denotes Area Certificate 84246 Primary, Certificate 33727 Supplemental

Note: Water Rights Certificate 84246
11.4 Acres NENE and 5.9 Acres SENE
Not Mapped—No Change In Place Of Use



APPLICATION FOR TRANSFER
CHANGE IN PLACE OF USE
CERTIFICATE 84246
SECTION 10, T.36S., R.2W., W.M.
JACKSON COUNTY, OREGON
FOR
PETER W. SAGE
DEBRA F.J. LEE
305 HARVARD PLACE
MEDFORD, OR 97504
SITUS OF TRANSFER
10361 TABLE ROCK ROAD
CENTRAL POINT, OR

RECEIVED

FEB 03 2023

OWRD
SALEM, OREGON

14167

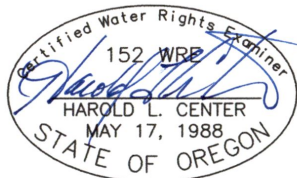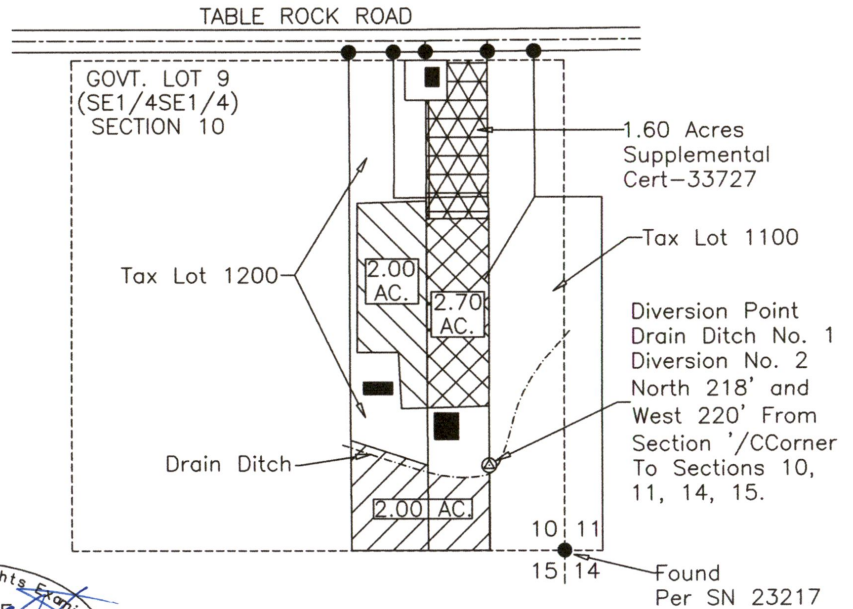

HAROLD L. CENTER
2604 David Lane
Medford, OR. 97504
Phone 541-535-6108
Oregon Certificate No. 152

Renews: 12/31/23