
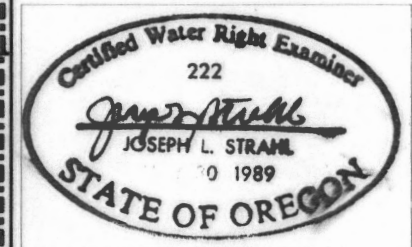


Claim of Beneficial Use Map

for

Application G-15878, Permit G-15478

T 40 S, R 19 E, Section 28, 29 & 32, W.M.

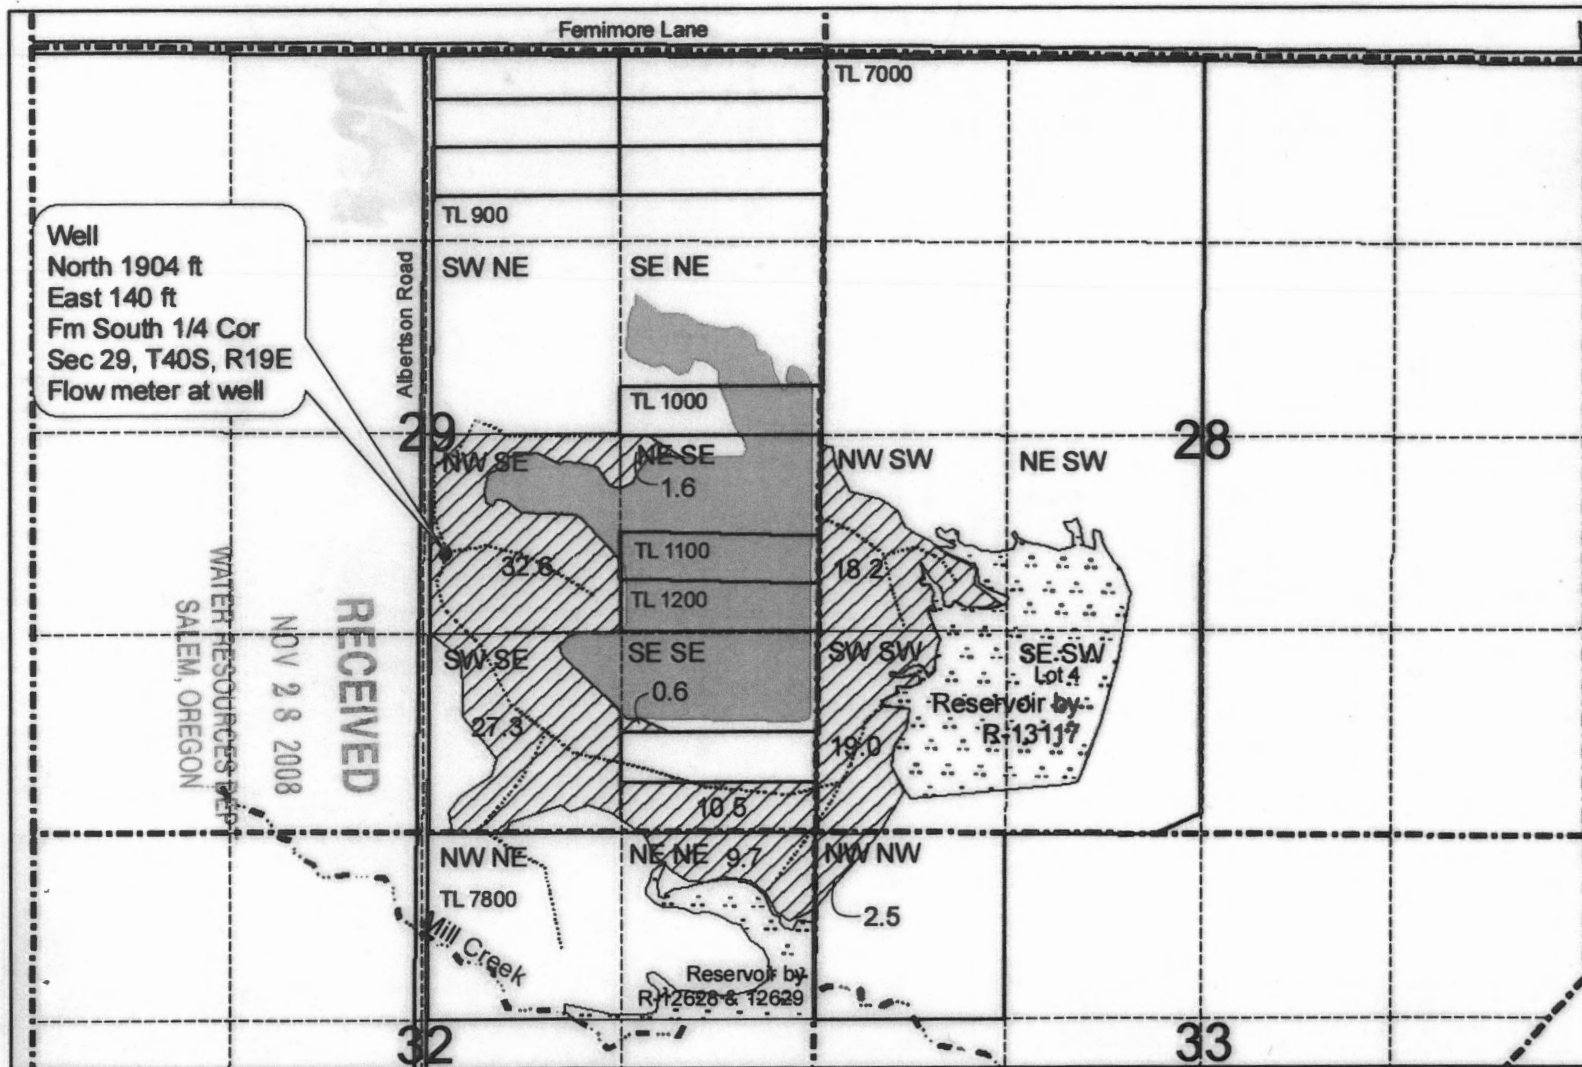

CWRE stamp

Note: This map is not to be used for property line location. It is to be used for water right purposes only.

Legend

- Irrigated land
- Res. by permit G15478
- Supp. supply to res.
- Ditch

N



Scale 1" = 1320'


John Albertson Map of Water Right Transfer Certificate 91208

RECEIVED

OCT 15 2021

OWRD

T 40 S, R 19 E
Sec 28, 29 & 32

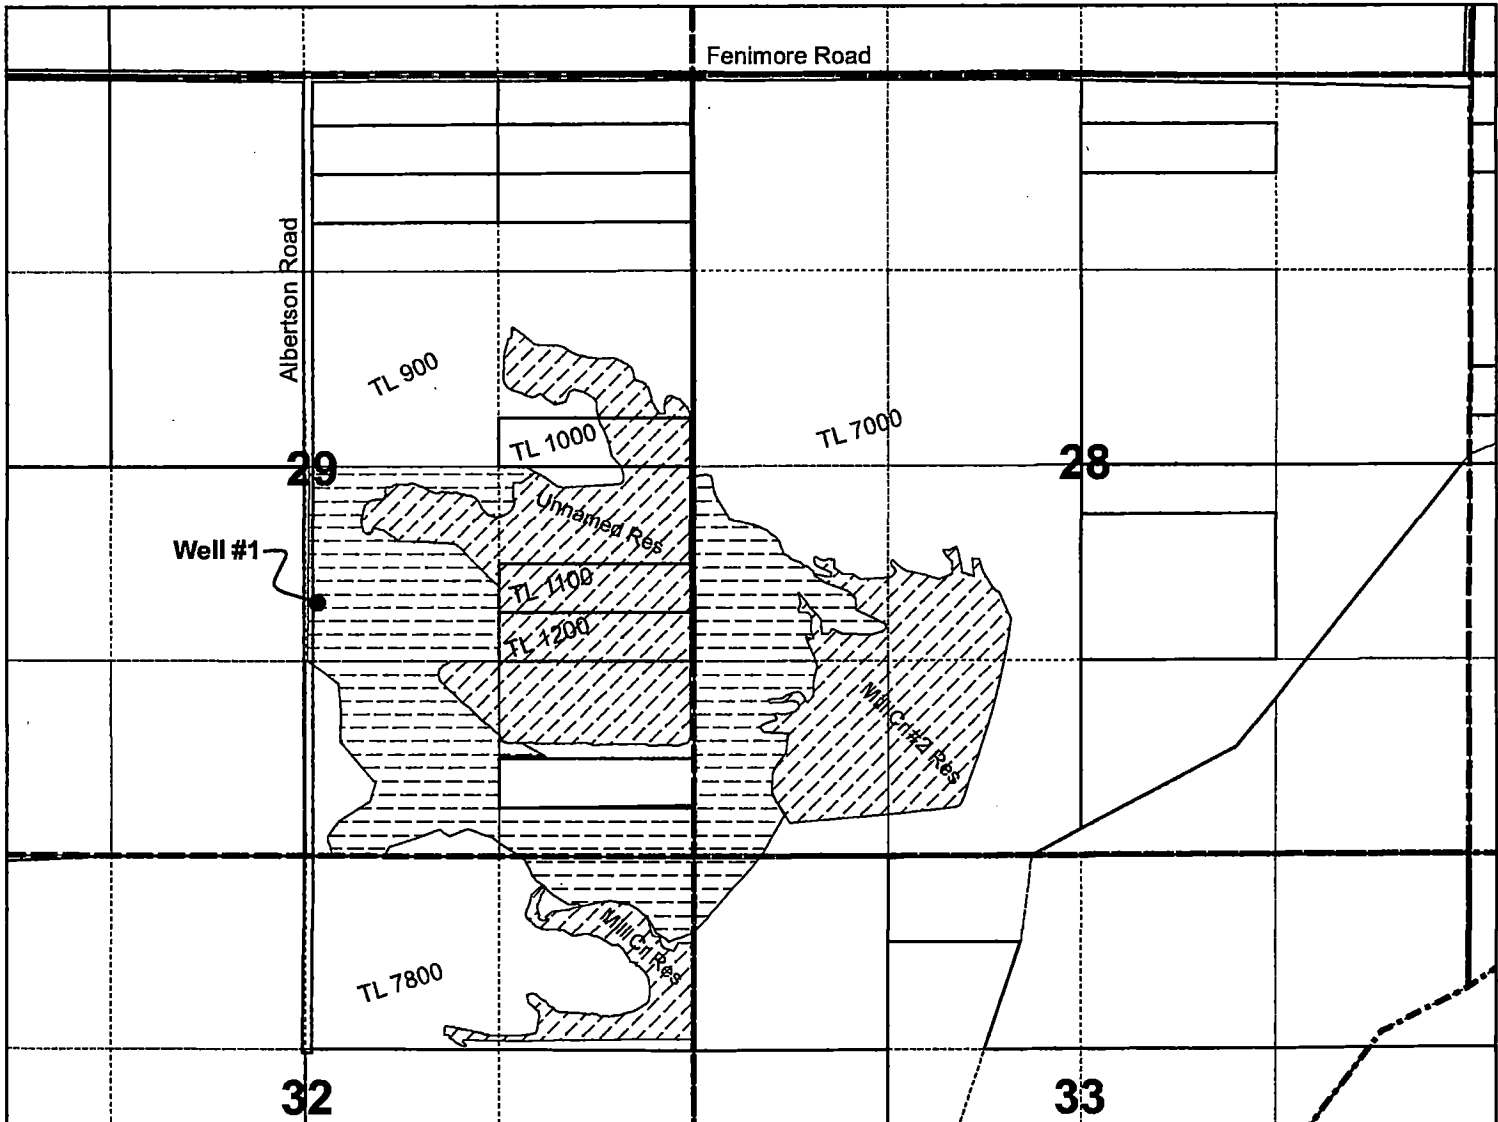

Certificate 91208 lists use for Irrigation and storage for Wetland Enhancement, Wildlife and Recreational uses. This transfer proposes to change the storage uses to "Storage for Multipurpose".

Well #1 located in the NWSE of Section 29, T 40 S, R 19 E. WM 1904 Feet South and 140 Feet East from S 1/4 Cor Sec 29


N



1 inch = 1,320 feet

Legend

-  Cert 91208 No Change
-  Cert 91208 Change to Multipurpose
-  Well

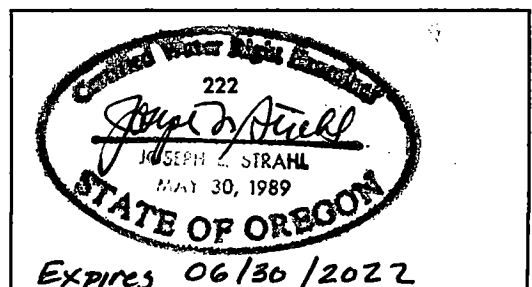

Note: This map is not intended to provide legal dimensions or locations of property ownership lines.

13851