


FOR  
DAN & NINA MICKE

POD #1 - RESERVIOR OUTLET  
WITH THE V-NOTCH WEIR  
MEASUREMENT DEVICE  
OUTLET LOCATED 186.55' NORTH  
AND 2753.94' WEST OF THE  
SOUTHEAST CORNER SECTION 7

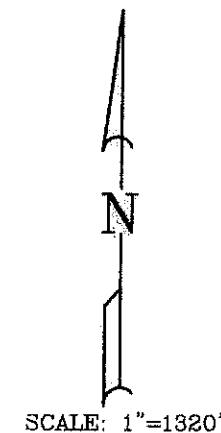

|           |                   |
|-----------|-------------------|
| —————     | SECTION LINE      |
| —————     | 1/4 SECTION LINE  |
| - - - - - | 1/16 SECTION LINE |
| -----     | WATERWAY          |
| —————     | PLACE OF USE      |

PERMIT NO. S-54520

MAR 09 2021

PREPARATION OF THIS MAP IS FOR IDENTIFYING PROPOSED  
WATER RIGHTS ONLY. IT HAS NO INTENT TO PROVIDE  
LOCATIONS OR DIMENSIONS OF PROPERTY BOUNDARIES.

**PERSON ENGINEERING  
SURVEYING, INC.**  
P.O. BOX 28  
KEVIEW, OREGON 97630  
(541) 947-4407  
FAX: 947-2321  
[www.personengineering.com](http://www.personengineering.com)

**AND  
AND  
AS**

FOR:  

CLAIM OF BENEFICIAL USE MAP  
APPLICATION NO. S-86000  
PERMIT NO. S-54520

|          |            |
|----------|------------|
| DATE:    | 2/02/2023  |
| SCALE:   | 1" = 1320' |
| DWG. BY: | R.C.       |
| JOB:     | 2013-00    |
| FILE:    | 2023       |
| SHEET:   | 1 OF 1     |