


TOWNSHIPS 1 & 2 NORTH,
 RANGE 42 EAST, W. APR - 1 1996
 KJP

Scale 1" = 1320'

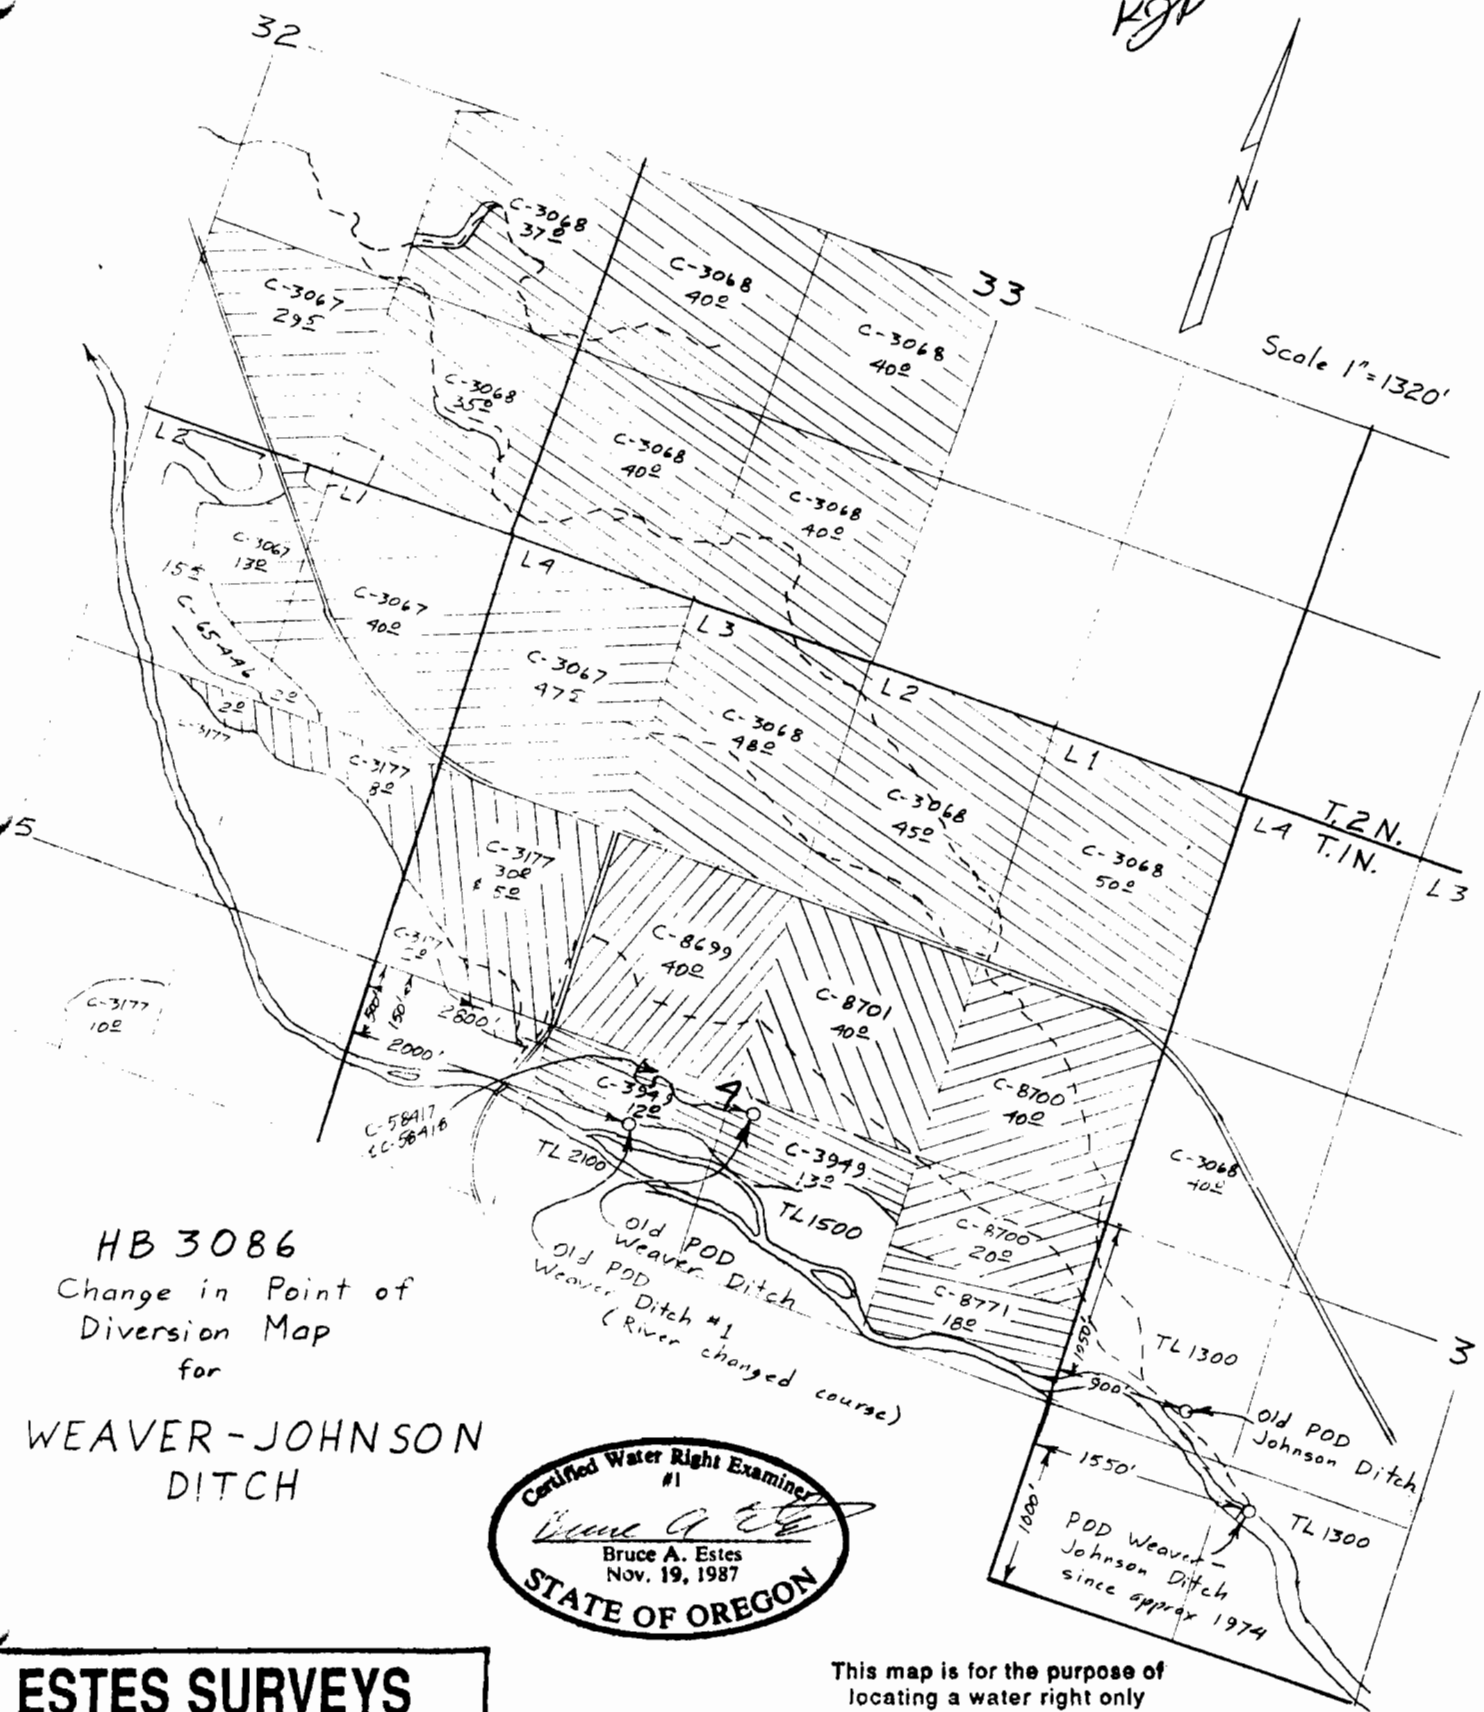


HB 3086
 Change in Point of
 Diversion Map
 for
**WEAVER-JOHNSON
 DITCH**

Certified Water Right Examiner
 #1
Bruce A. Estes
 Bruce A. Estes
 Nov. 19, 1987
STATE OF OREGON

This map is for the purpose of
 locating a water right only
 and has no intent to provide
 legal dimensions or the location
 of property lines.

ESTES SURVEYS
 6293 Sunnyview Rd. NE 60382 Arnold Rd.
 Salem, OR 97305 Bend, OR 97702
 (503) 585-7593 (503) 382-7391

TOWNSHIP 1 NORTH, RANGE 42 EAST, W.M.

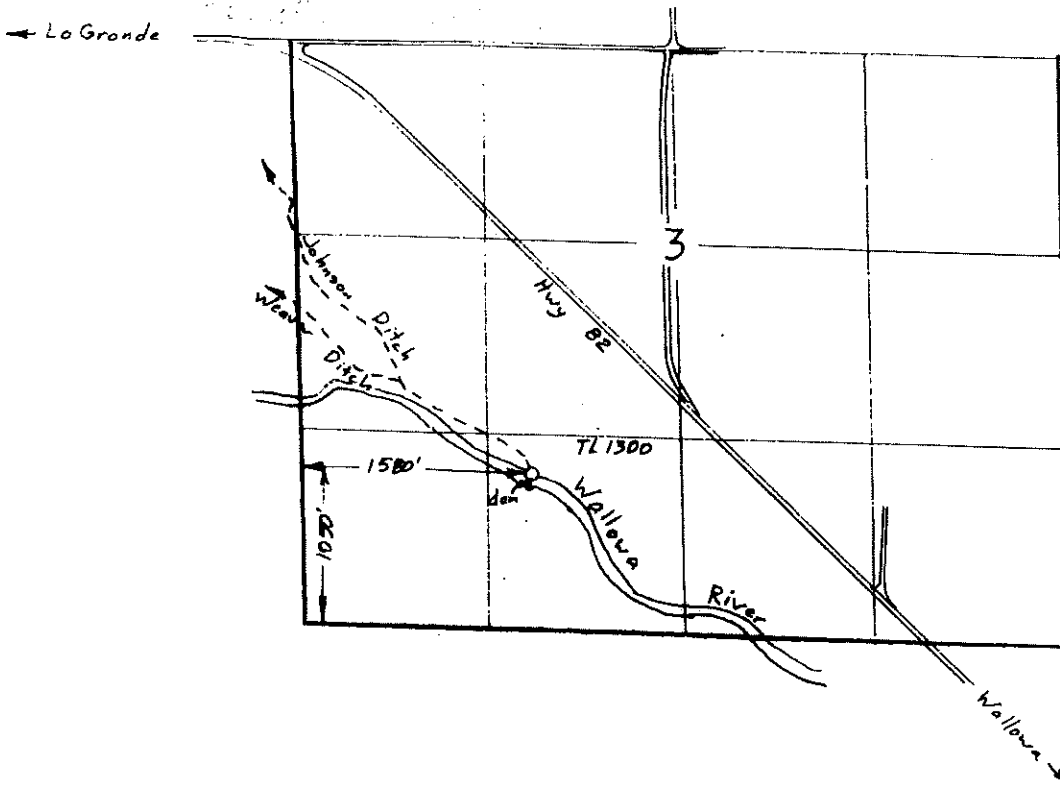


Surveyed Nov. 4, 1997

RECEIVED

FEB 09 1998

WATER RESOURCES DEPT
SALEM OREGON

T-7473
Claim of Beneficial Use Map
for
WEAVER-JOHNSON DITCH
(Lower Valley Water Improvement Dist.)

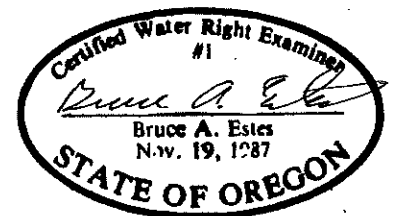

This map is for the purpose of locating a water right only and has no intent to provide legal dimensions or the location of property lines.

ESTES SURVEYS

6293 Sunnyview Rd. NE 60382 Arnold Rd.
Salem, OR 97305 Bend, OR 97702
(503) 585-7593 (503) 382-7391