


CLAIM OF BENEFICIAL USE MAP
TO ADD A POINT OF APPROPRIATION AND CHANGE PLACE OF USE
FOR T-11912
SILVER LAKE IRRIGATION DISTRICT
TOWNSHIP 28 SOUTH, RANGE 14 EAST, SECTIONS 23-27 & 35, W.M.
TAX LOT: 2800

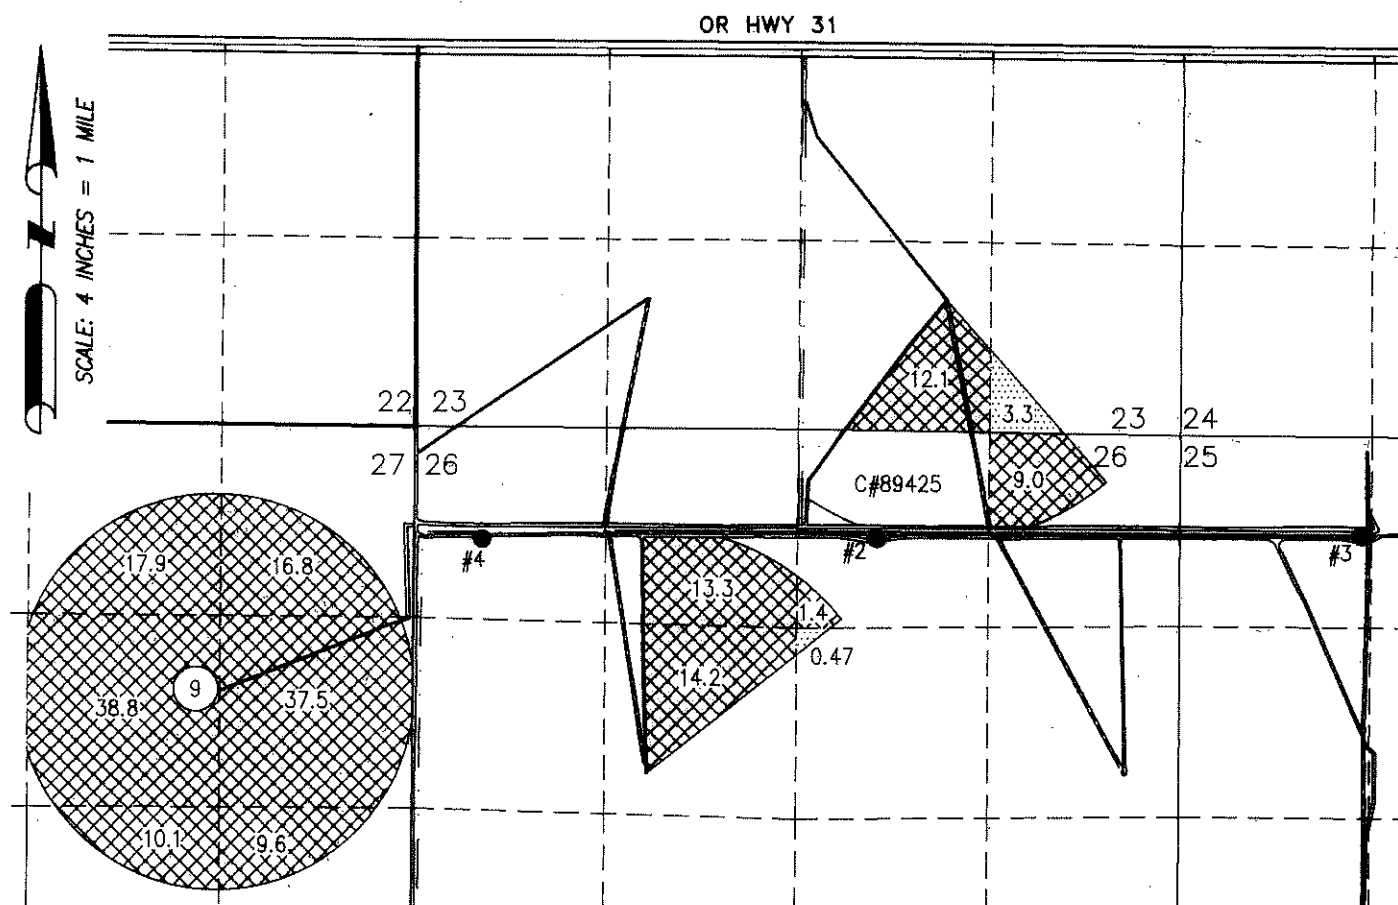


IRRIGATION CANAL

IRRIGATION BURIED PIPING

- WELL #2 (LAKE 4121)
NW 1/4 NE 1/4 SECTION 26, T28S
R14E, W.M.; 728 FEET SOUTH AND
3144 FEET EAST FROM THE NW
CORNER OF SECTION 26.
- WELL #3 (LAKE 1322/1323/1324)
NW 1/4 NW 1/4 SECTION 25, T28S
R14E, W.M.; 688 FEET SOUTH AND
1166 FEET EAST FROM THE NW
CORNER OF SECTION 25.
- WELL #4 (LAKE 52995)
NW 1/4 NW 1/4 SECTION 26, T28S
R14E, W.M.; 760 FEET SOUTH AND
470 FEET EAST FROM THE NW
CORNER OF SECTION 26. FLOW METER
LOCATED 8 FEET NORTH OF POA.

180.7 ACRES SUPPLEMENTAL
IRRIGATION FROM G-6669 (C#B1395)

3.77 ACRES PRIMARY IRRIGATION FROM
G-6669 (C#B1395) CHANGE TO
SUPPLEMENTAL

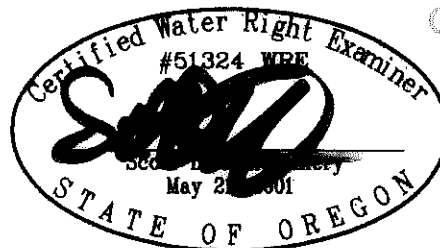

RENEWAL DATE: 12/31/2024

THIS MAP IS FOR THE PURPOSE OF LOCATING
A WATER RIGHT ONLY AND HAS NO INTENT
TO PROVIDE LEGAL DIMENSIONS OR THE
LOCATION OF PROPERTY LINES

PREPARED FOR:
J.R.S. PROPERTIES III, LP
P.O. BOX 27
BOISE, ID 83707

PREPARED BY:



ALL POINTS ENGINEERING AND SURVEYING, INC.
P.O. BOX 767
(541) 548-5833
TERREBONNE, OR 97760
www.APEandS.com