


RECEIVED

MAY 10 2021

OWRD

T.5S. R.2W. W.M.

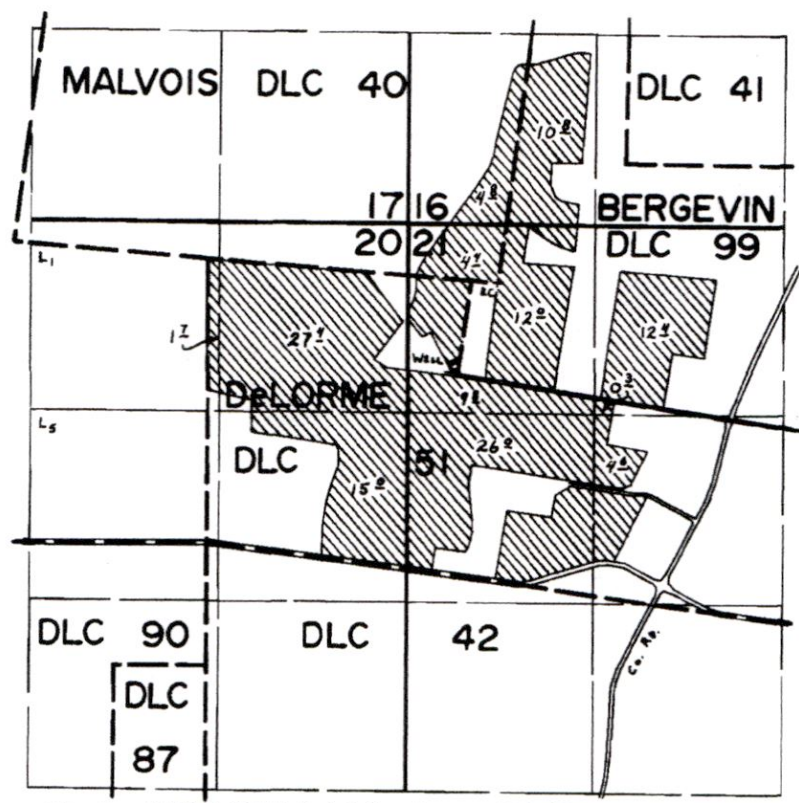

WELL LOC: 570'S. & 300' W. fr. S.E. COR. MALVOIS DLC. 90.

**FINAL PROOF SURVEY**  
UNDER

Application No. G-6779 Permit No. G-6292  
IN NAME OF

**CYRIL & ANITA FERSCHWEILER**

Surveyed July 1, 1980, by C.L. Hughes

13705 -


13705 -

T5S, R2W, WM  
MARION COUNTY

RECEIVED

MAY 10 2021

OWRD

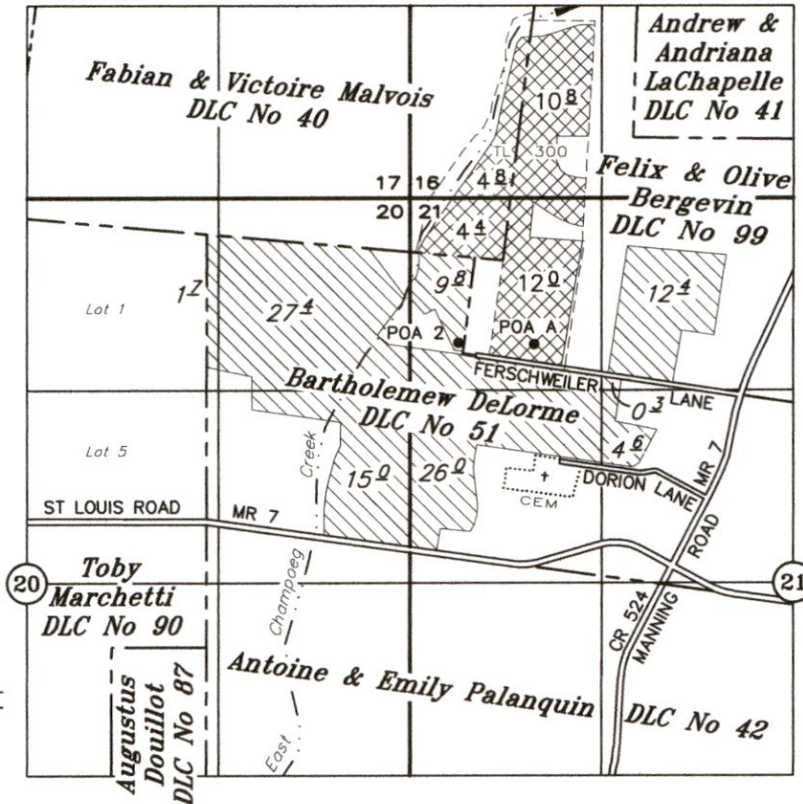

TAX LOT:  
5 2W 21B 300

----- TAX LOT LINE

AUTHORIZED POA WELL #2: 570' SOUTH & 300' WEST, SE COR MALVOIS DLC 40  
PROPOSED ADDITIONAL POA WELL A: 580' SOUTH & 215' EAST, SE COR MALVOIS DLC 40



XX ACRES TO REMAIN IRRIGATED FROM POA WELL #2 (AUTHORIZED)



XX ACRES TO BE IRRIGATED FROM POA WELL A (APOA)

13705 -

APPLICATION TO TRANSFER A WATER RIGHT

ADDITIONAL POINT OF APPROPRIATION

Certificate No. 57771 Transfer No. T-

IN THE NAME OF

**Mark A. McKay &  
Mark McKay Farms, Inc.**

March 29, 2021  
SCALE: 1" = 1320'



NOTE: This map is for the purpose of identifying the location of water rights and has no intent to dimension or locate property ownership lines.

RENEWAL DATE: 12-31-21