Claim of Beneficial Use
Application S-85624, Permit S-54076
Red Hills Farm LLC

Township 4S, Range 3W, W.M.

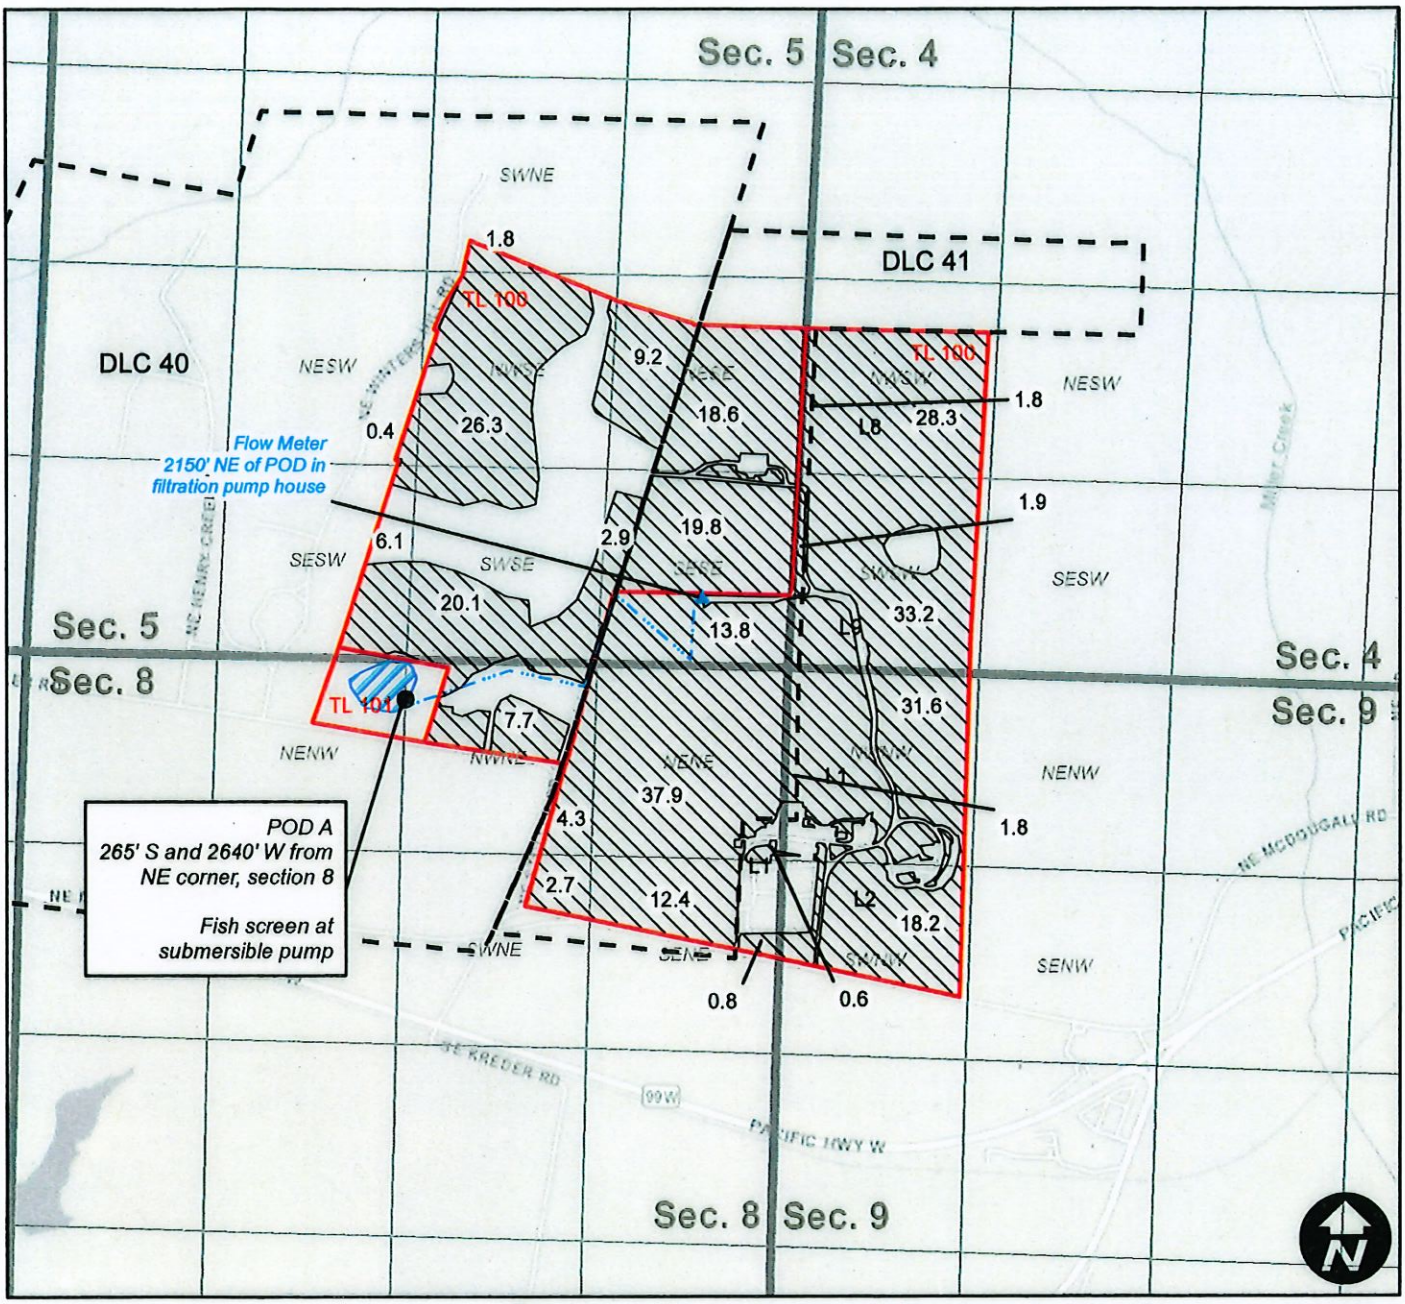

This map is not intended to provide legal dimensions or locations of property ownership lines.

0 660 1,320 2,640 Feet

Legend

- POU (302.2 ac.)
- Stoller Reservoir
- Mainline
- Tax Lot
- DLC

RECEIVED
SEP 30 2022
OWRD

CERTIFIED WATER RIGHT EXAMINER
30680
William E. McGill
WILLIAM E. McGILL
MAY 3, 2011
STATE OF OREGON
EXPIRES: 12-31-2022

WILL MCGILL SURVEYING LLC