


T. 7S., R. 45E., W. M.

RECEIVED

AUG 18 1997

WATER RESOURCES DEPT  
SALEM, OREGON

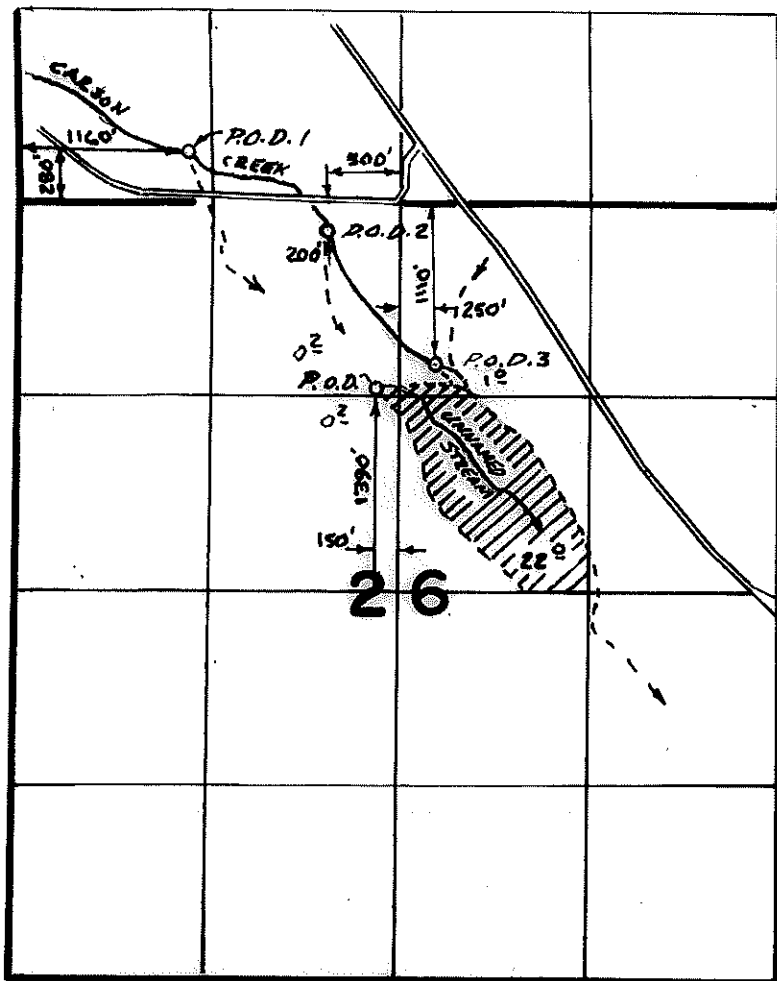

SCALE: 4" = 1 Mile

The purpose of this map is for identifying the location of the water right only and is not intended to provide legal dimensions of property ownership lines.

# FINAL PROOF SURVEY

UNDER

APPL. 70302

PER. 52192

IN NAME OF

EARL V. JR. & DELBERTA M. WALKER

Surveyed April 5, 1997

HANLEY ENGINEERING  
2043 MAIN STREET  
BAKER CITY, OREGON

