

1.4 ACRES
WETLANDS ENHANCEMENT

SE 1/4 OF SE 1/4

RECEIVED

OCT 01 1999

WATER RESOURCES DEPT.
SALEM, OREGON

POND No. 2
Point of Diversion

POND No. 3

TO GOOSE CREEK

POND No. 1
Point of Diversion

BRIGHT ROAD

1236'
S67°37'E

787'
S77°43'E

HOWLETT ROAD (COUNTY ROAD No. 121)


33 34
4 3

This drawing is an exhibit for a Final Proof Survey. It is not a Land Survey. Property lines and/or other lines of occupation shown hereon are not represented by the undersigned to meet accuracy standards of Land Surveys.



SCALE: 1" = 400'

SECTION 33, T.2S., R.4E., W.M.
CLACKAMAS COUNTY, OREGON

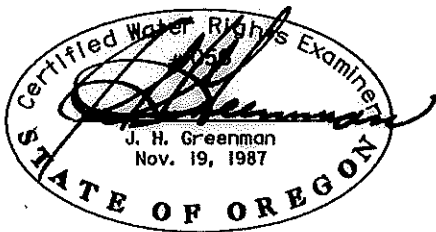

Application No. S-73315

Permit No. 51891

File: d:\ustrn\dgn\674a.prf.dgn edr 09/28/99



**HANER, ROSS &
SPORSEEN, INC.**
15 S.E. 82ND DRIVE
GLADSTONE, OREGON 97027

ALAN & JANICE GAYLORD

FINAL PROOF SURVEY