


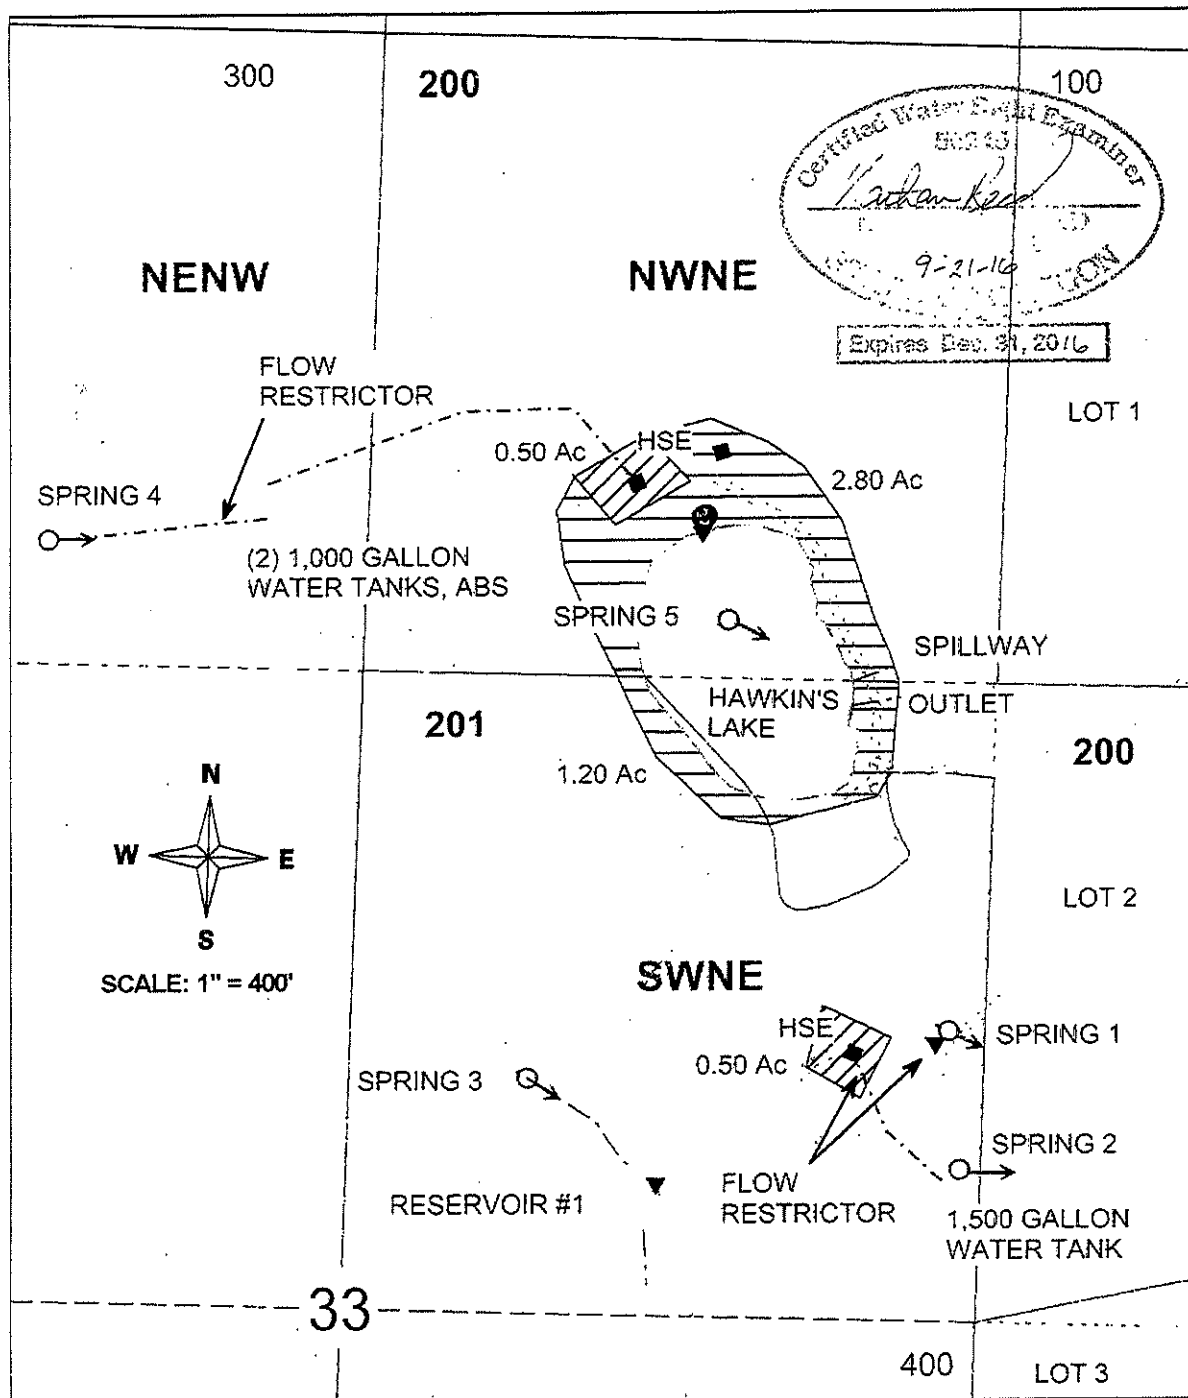

CLAIM OF BENEFICIAL USE

FOR: DONALD & LAURA BAILEY
 BY: NATHAN R. REED, P.E., CWRE
 SECTIONS 33, T26S, R7W, W.M. DOUGLAS COUNTY
 APPLICATION NO. R-80207 & S-71068
 PERMIT NO. R-12036 & S-54804

DATE SURVEYED: SEPTEMBER 5, 2016

POINTS OF DIVERSION
 (ALL PODS ARE TIED TO THE N1/4
 CORNER OF SECTION 33, T26S, R7W)

SPRINGS:

1. 1900 FT SOUTH & 1090 FT EAST OF.
2. 2440 FT SOUTH & 1120 FT EAST OF.
3. 2120 FT SOUTH & 270 FT EAST OF.
4. 1110 FT SOUTH & 660 FT WEST OF.
5. 1230 FT SOUTH & 710 FT EAST OF.

RESERVOIRS:

HAWKIN'S LAKE, 1030 FT SOUTH
 & 720 FT EAST OF.
 RESERVOIR #1, 2420 FT SOUTH
 & 770 FT EAST OF.

Legend

○	Springs	---	Line
→	Flow arrow	■	Structure
○	Water Tank	...	Gov Lot
▼	POD	□	Section
---	Pipeline	---	Quarter
---	Roads	---	Sixteenth
---	Pond	□	Parcels

RECEIVED

MAR 03 2022

OWRD

MAP PREPARED BY:
 NATHAN R. REED, P.E., CWRE
 1113 SE CASS AV
 ROSEBURG, OR 97470

MAP PREPARED FOR:
 DONALD & LAURA BAILEY
 1455 BECKER ROAD
 ROSEBURG, OR 97471

THE PURPOSE OF THIS MAP IS TO IDENTIFY THE LOCATION OF THE
 WATER RIGHT. IT IS NOT INTENDED TO PROVIDE INFORMATION RELATIVE
 TO THE LOCATION OF PROPERTY OWNERSHIP BOUNDARY LINES.