


CLAIM OF BENEFICIAL USE MAP


TO CHANGE PLACE OF USE AND
POINTS OF APPROPRIATION
FOR T-8375
SAM DINSDALE

TOWNSHIP 26 SOUTH, RANGE 15 EAST, SECTION 32, W.M.
TAX LOT: 5400

RECEIVED
MAY 21 2001
OWB
SALES, OREGON

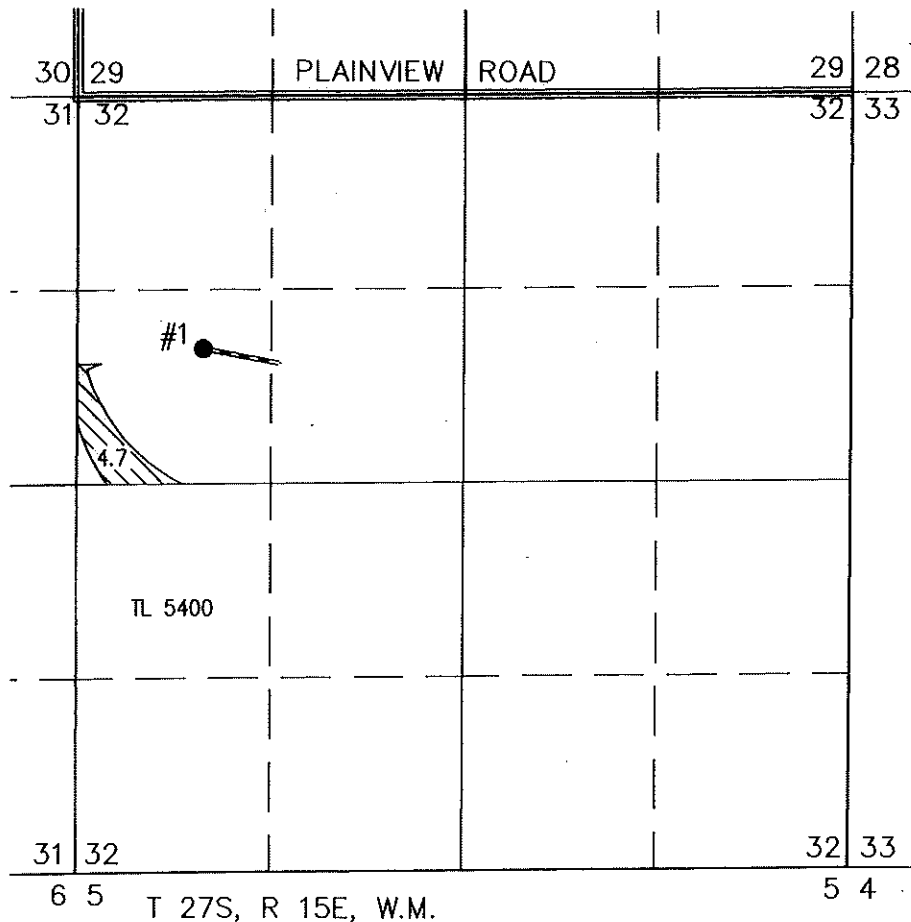

4.7 ACRES WATER RIGHTS
FROM CERTIFICATE #27329
(G-1136), AS SHOWN.

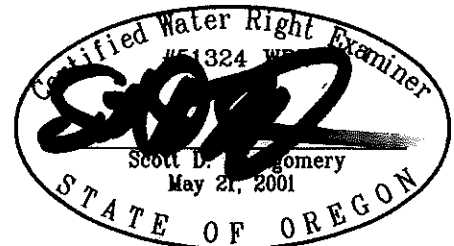


● #1 (LAKE 476)

EXISTING WELL IN THE SW 1/4 NW 1/4 SECTION 32,
T26S R15E, W.M. LOCATED 920 FEET NORTH AND 860
FEET EAST FROM THE W 1/4 CORNER OF SECTION 32.

METER IS LOCATED APPROXIMATELY 10 FEET WEST
ALONG DELIVERY PIPE FROM CENTER PIVOT.

THIS MAP IS FOR THE PURPOSE OF LOCATING A
WATER RIGHT ONLY AND HAS NO INTENT TO
PROVIDE LEGAL DIMENSIONS OR THE LOCATION OF
PROPERTY LINES

PREPARED FOR:

SAM DINSDALE
57673 FORT ROCK ROAD
SILVER LAKE, OR 97638

PREPARED BY:



ALL POINTS ENGINEERING AND SURVEYING, INC.
P.O. BOX 767 TERREBONNE, OR 97760
(541) 548-5833 www.APEandS.com