
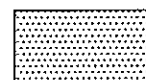


CLAIM OF BENEFICIAL USE MAP


TO CHANGE PLACE OF USE AND
POINTS OF APPROPRIATION
FOR T-8375
SAM DINSDALE

TOWNSHIP 26 SOUTH, RANGE 15 EAST, SECTION 31, W.M.
TAX LOT: 5200 & 5400

RECEIVED
AUG 18 2003

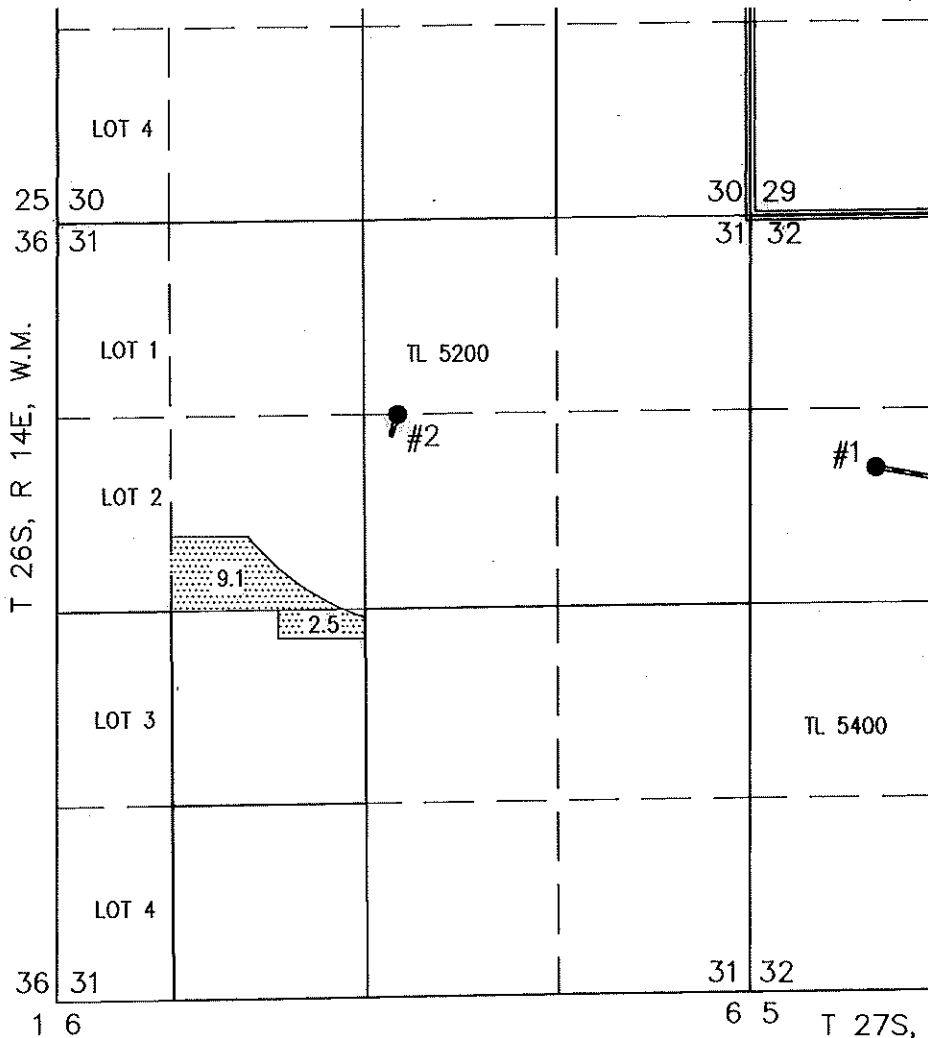

11.6 ACRES WATER RIGHTS
FROM CERTIFICATE #28682
(U-513), AS SHOWN.

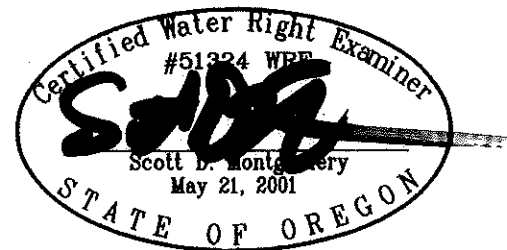

● #2 (LAKE 464)

EXISTING WELL IN THE NW 1/4 NE 1/4 SECTION 31, T26S
R15E, W.M. LOCATED 1320 FEET SOUTH AND 2410 FEET
WEST FROM THE NE CORNER OF SECTION 31.

METER IS LOCATED APPROXIMATELY 6.0 FEET NE
ALONG DELIVERY PIPE FROM CENTER PIVOT.


THIS MAP IS FOR THE PURPOSE OF LOCATING A WATER RIGHT ONLY AND HAS NO
INTENT TO PROVIDE LEGAL DIMENSIONS OR THE LOCATION OF PROPERTY LINES

PREPARED FOR:

SAM DINSDALE
57673 FORT ROCK ROAD
SILVER LAKE, OR 97638

PREPARED BY:



ALL POINTS ENGINEERING AND SURVEYING, INC.
P.O. BOX 767 TERREBONNE, OR 97760
(541) 548-5833 www.APEandS.com