


CLAIM OF BENEFICIAL USE MAP


TO CHANGE PLACE OF USE AND
POINTS OF APPROPRIATION
FOR T-8375
SAM DINSDALE

TOWNSHIP 26 SOUTH, RANGE 15 EAST, SECTIONS 20 & 29, W.M.
TAX LOT: 2500

RECEIVED
MAY 12 2003
DAVID
SALEM, OREGON

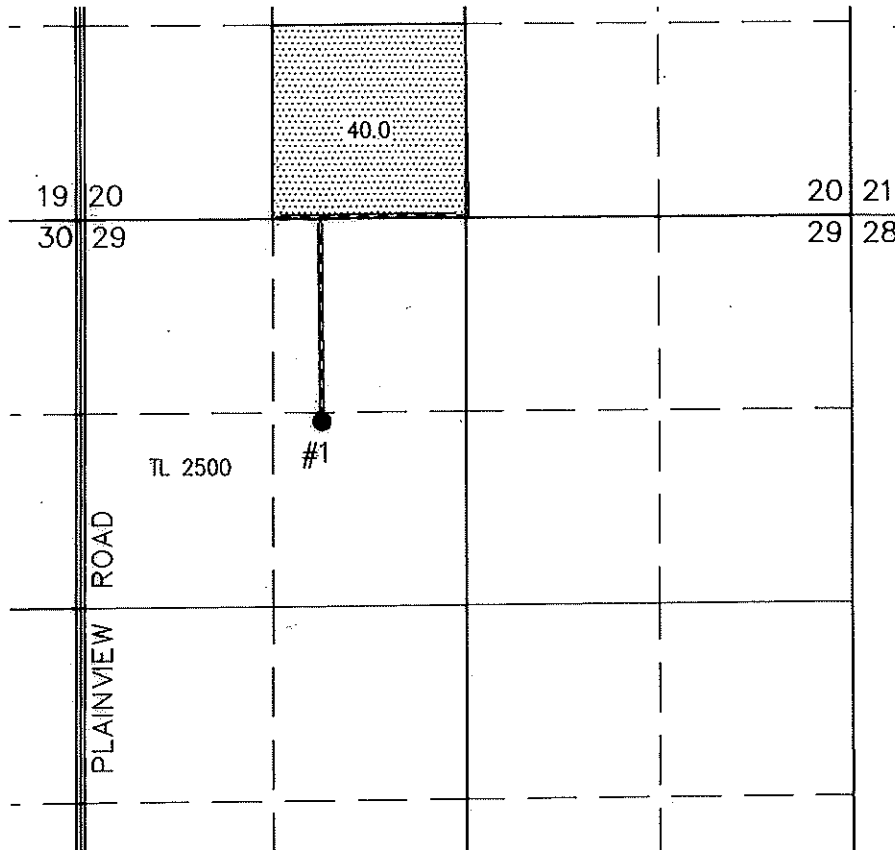

40.0 ACRES WATER RIGHTS
FROM CERTIFICATE #55516
(G-370), AS SHOWN.

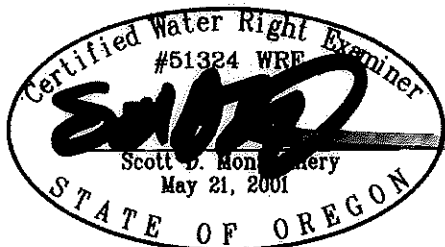

RENEWAL DATE: 12/31/2024

THIS MAP IS FOR THE PURPOSE OF LOCATING A
WATER RIGHT ONLY AND HAS NO INTENT TO
PROVIDE LEGAL DIMENSIONS OR THE LOCATION OF
PROPERTY LINES

● #1 (LAKE 4105)

EXISTING WELL IN THE SE 1/4 NW 1/4 SECTION 29,
T26S R15E, W.M. LOCATED 1380 FEET SOUTH AND 1650
FEET EAST FROM THE NW CORNER OF SECTION 29.

METER IS LOCATED APPROXIMATELY 300 FEET WEST
ALONG DELIVERY PIPE FROM WELL.

PREPARED FOR:

SAM DINSDALE
57673 FORT ROCK ROAD
SILVER LAKE, OR 97638

PREPARED BY:



ALL POINTS ENGINEERING AND SURVEYING, INC.
P.O. BOX 767 TERREBONNE, OR 97760
(541) 548-5833 www.APEandS.com