


T4S R1W, WM

MARION COUNTY

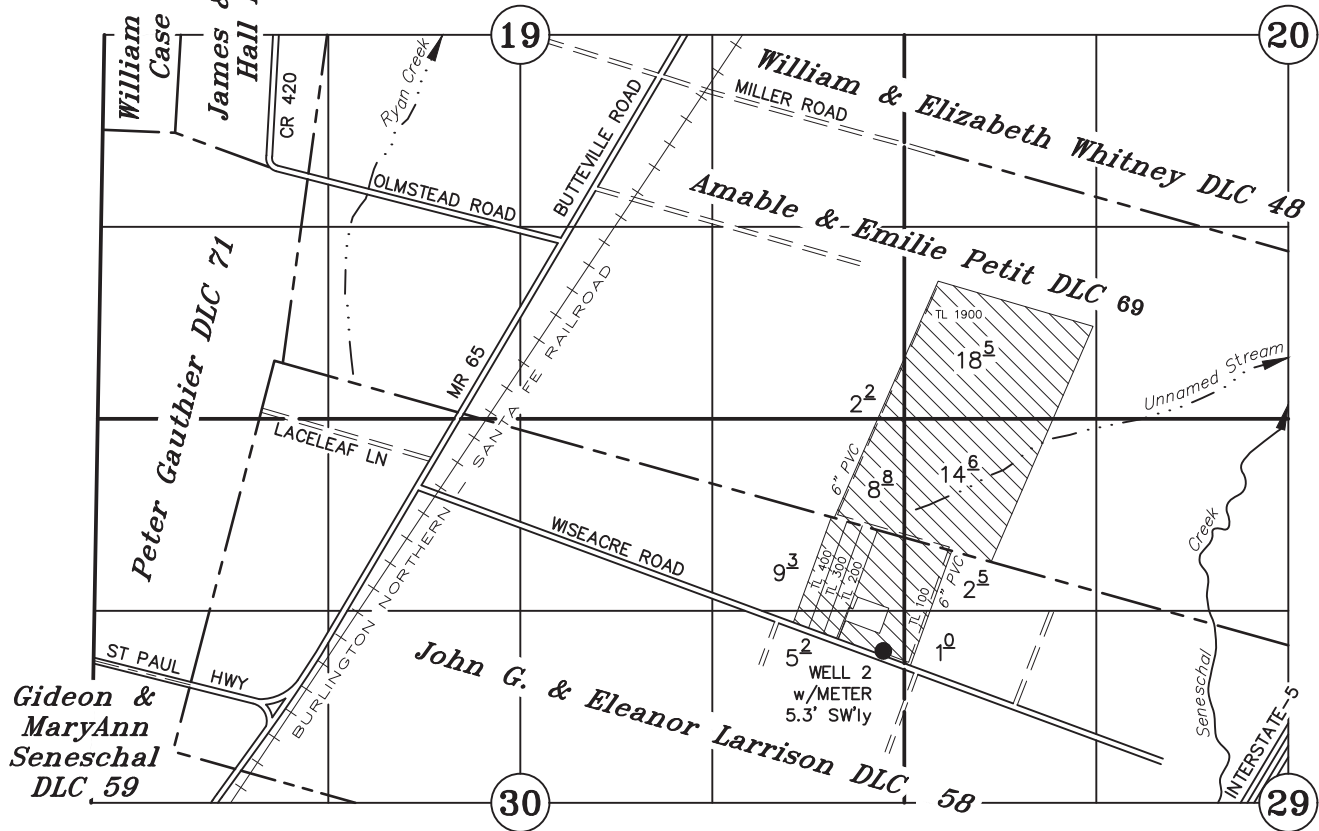

TAX LOTS:
 4 1W 30A 100 POA
 200
 300
 400
 4 1W 20 1900

WELL 2: 965' N AND 144' W OF THE E 1/4 COR SEC 30
 WELL NO 2 FLOW METER: 960' N AND 145' W OF THE E 1/4 COR SEC 30

CLAIM OF BENEFICIAL USE

POA CHANGE


Permit No. G-13413 Transfer No. T-11422

Crosby Land Company, LLC

September 25, 2018
 rev. July 18, 2024
 Acres Text Corrected

SCALE: 1" = 1320'

NOTE: This map is for the purpose of identifying the location of water rights and has no intent to dimension or locate property ownership lines.

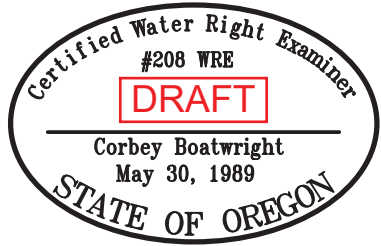

Renewal Date: December 31, 2025