


# T. 29 S., R. 8 AND 9 W. W.M.

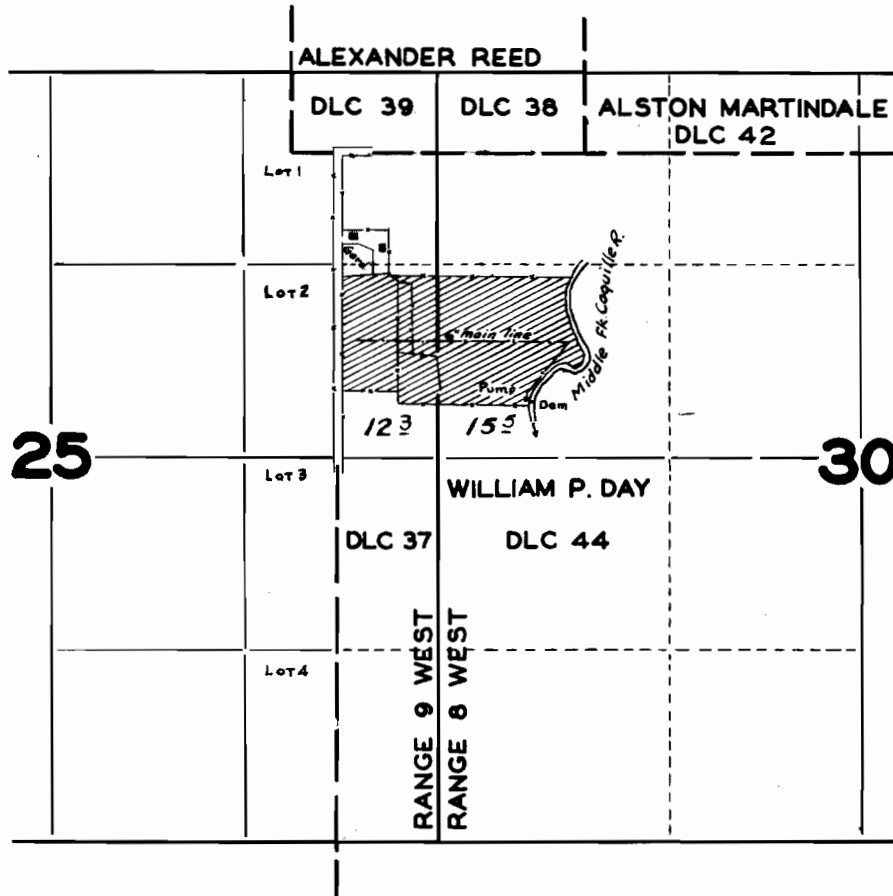

## FINAL PROOF SURVEY UNDER

Application No. 18367 Permit No. 13989

IN NAME OF

Louise G. Richter

Surveyed Sept. 4 1943, by Geo. D. Adelman