



E-RECEIVED
8/6/2024
OWRD

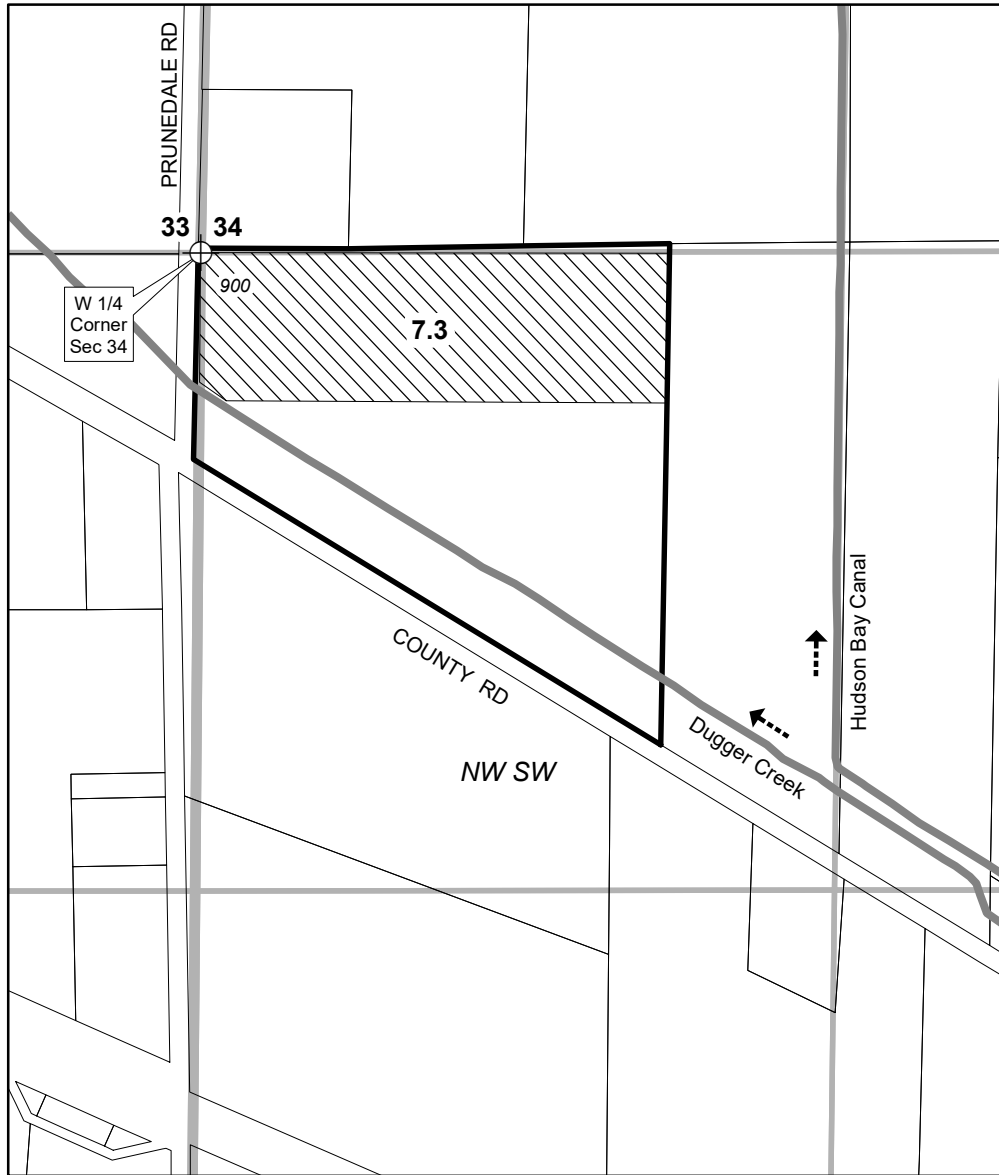

POD 1. LITTLE WALLA WALLA RIVER
 SW NE, Section 12, T5N, R35E, WM
 1030 ft N and 900 ft E from Center of Sec 12

TRANSFER DID NOT CHANGE THE
 AUTHORIZED POINT OF DIVERSION

DISCLAIMER
 This map is not intended to provide legal dimensions or locations of property ownership lines.

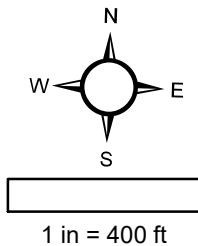

CLAIM OF BENEFICIAL USE MAP
Transfer 14387
Certificate 92511
Change Place of Use

WALLA WALLA RIVER
 IRRIGATION DISTRICT

Revised 2024-04-22