


E-RECEIVED
 8/6/2024
 OWRD

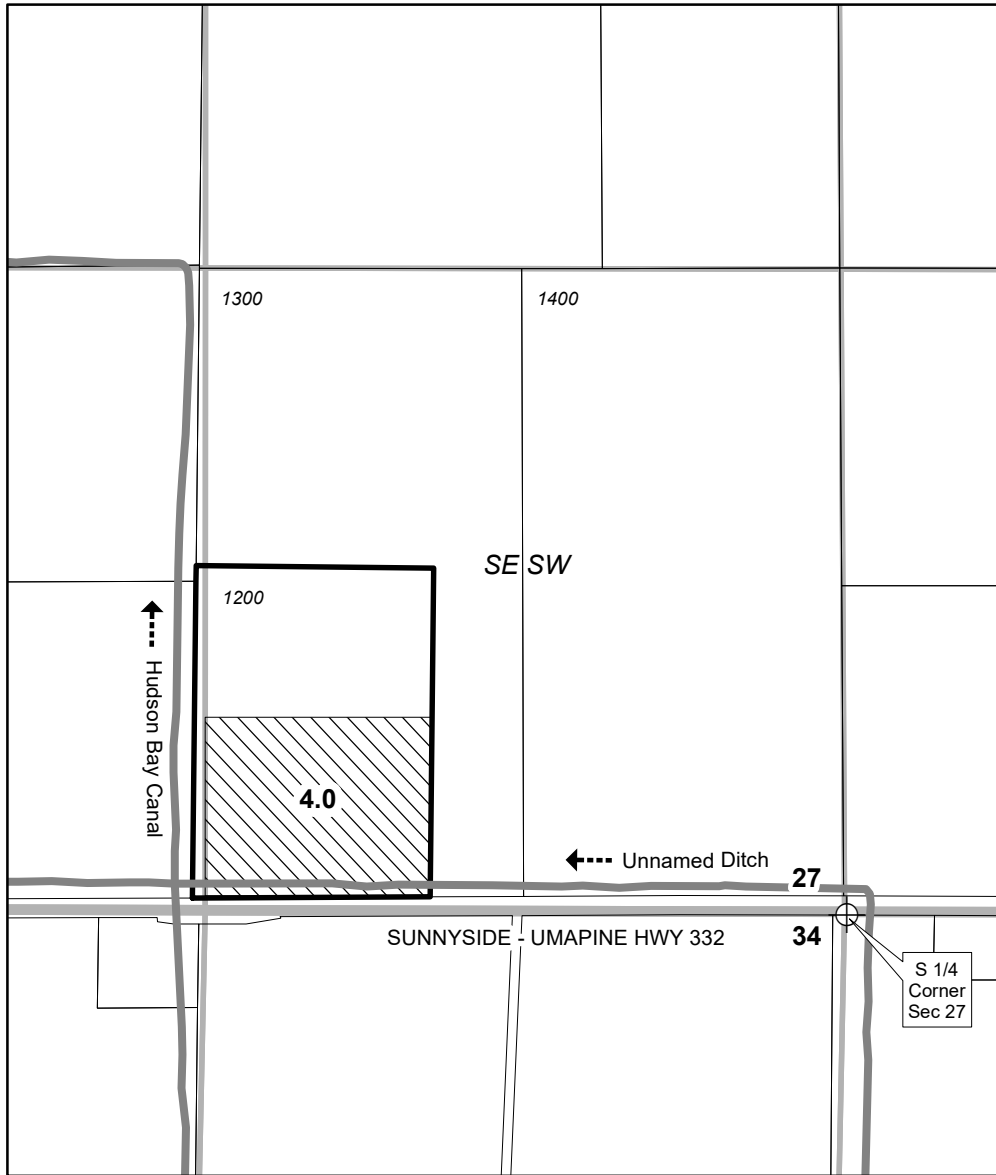

POD 1. WALLA WALLA RIVER
 SW NE, Section 12, T5N, R35E, WM
 1030 ft N and 900 ft E from Center of Sec 12

POD 2. WALLA WALLA RIVER
 NE NE, Section 2, T5N, R35E, WM
 650 ft S and 450 ft W from NE Corner Sec 2

TRANSFER DID NOT CHANGE THE
 AUTHORIZED POINT OF DIVERSION

DISCLAIMER
 This map is not intended to provide legal dimensions or locations of property ownership lines.

1 in = 400 ft

Certified Water Right Examiner
 358
 John S. Warinner
 May 18, 1993
 STATE OF OREGON

CLAIM OF BENEFICIAL USE MAP
Transfer 14387
Certificate 91617
Change Place of Use
 WALLA WALLA RIVER
 IRRIGATION DISTRICT
 Revised 2024-04-22