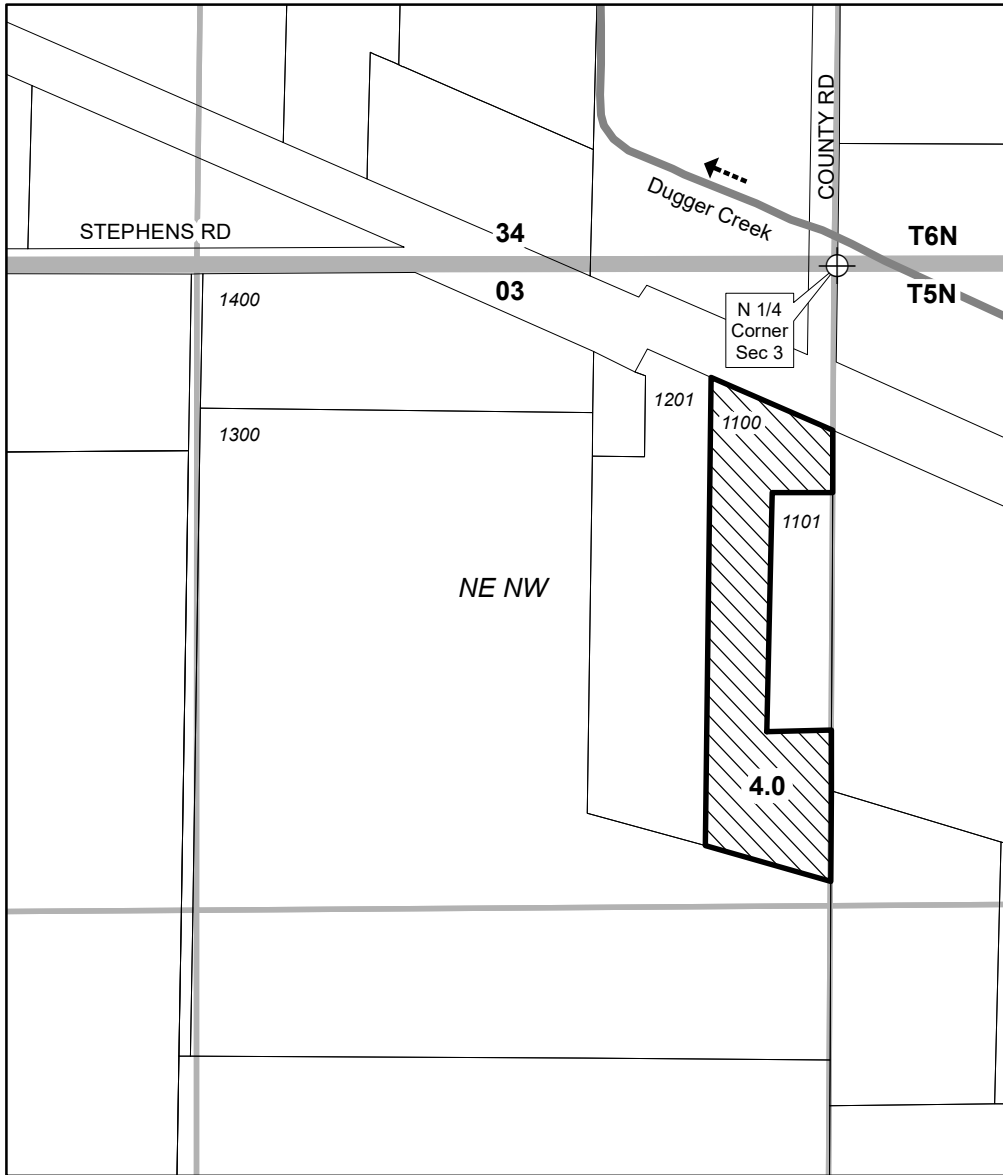


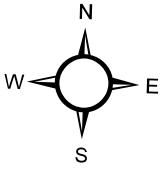
 
E-RECEIVED
8/6/2024
OWRD



POD 1. LITTLE WALLA WALLA RIVER
 SW NE, Section 12, T5N, R35E, WM
 1030 ft N and 900 ft E from Center of Sec 12

TRANSFER DID NOT CHANGE THE
 AUTHORIZED POINT OF DIVERSION

DISCLAIMER
 This map is not intended to provide legal dimensions or locations of property ownership lines.

1 in = 400 ft



CLAIM OF BENEFICIAL USE MAP
Transfer 14387
Certificate 92592
Change Place of Use

WALLA WALLA RIVER IRRIGATION DISTRICT
 Revised 2024-04-22