


Township 21 South, Range 5 West, W.M.

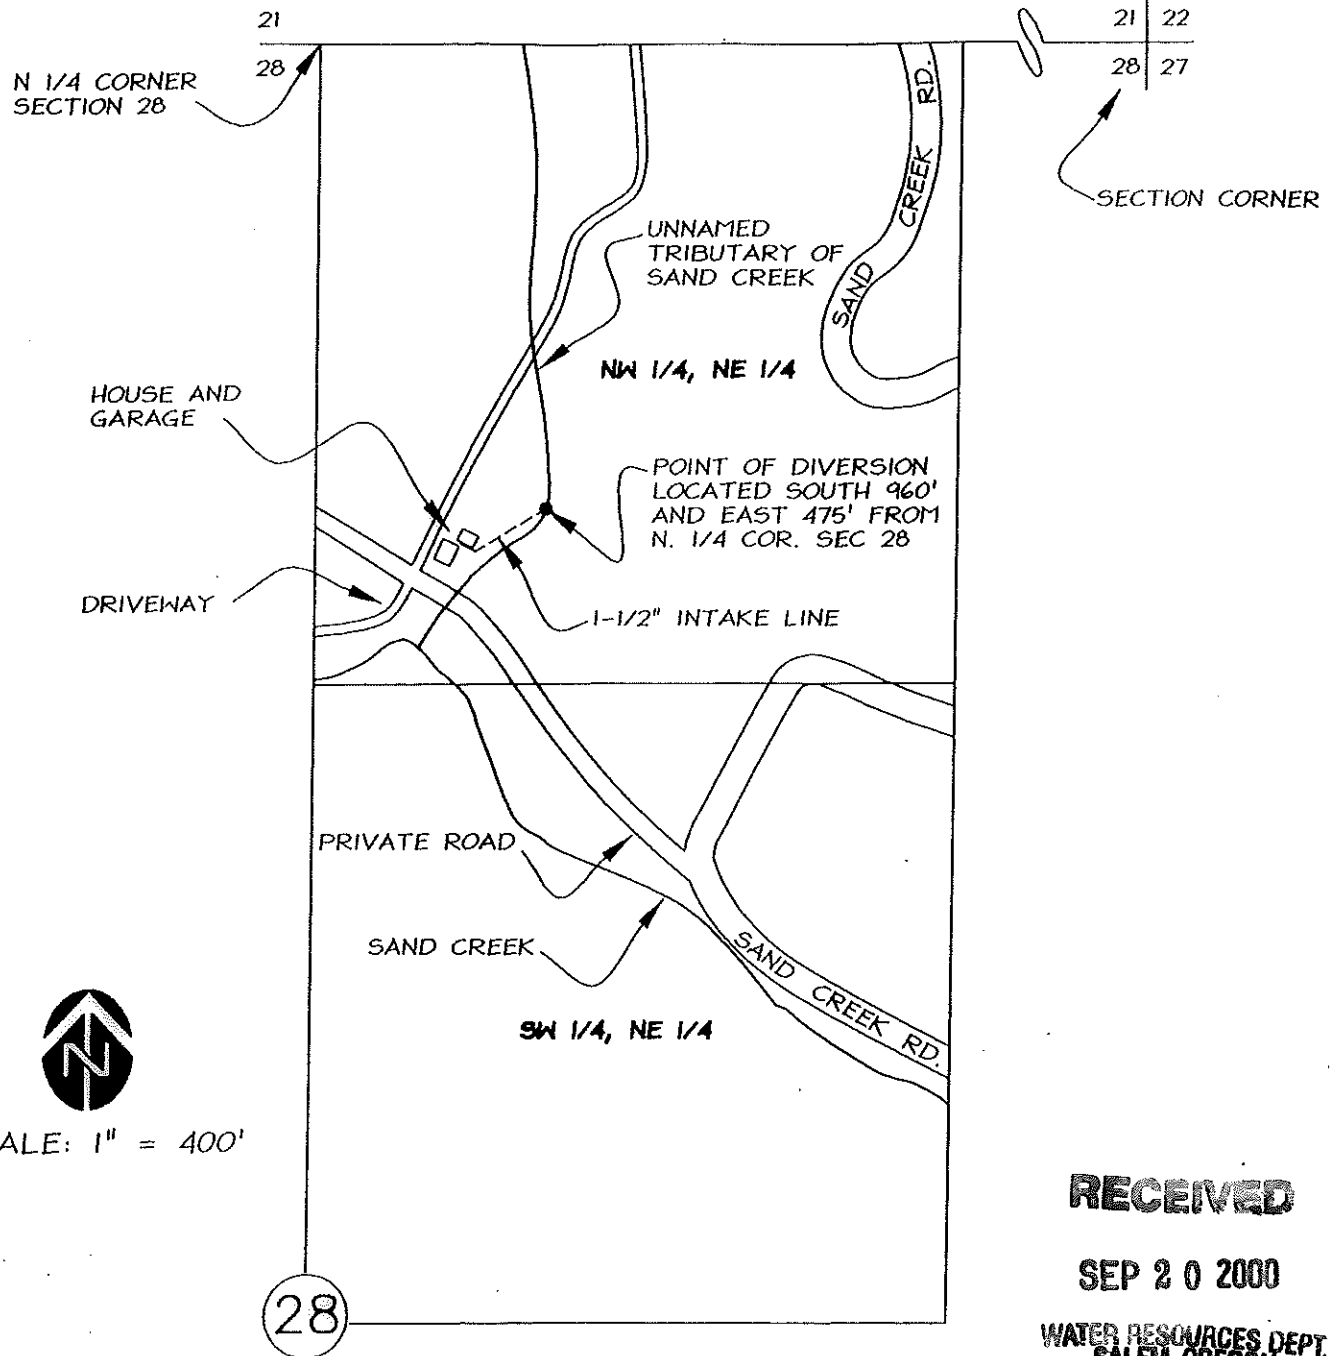


SCALE: 1" = 400'

RECEIVED

SEP 20 2000

**WATER RESOURCES DEPT.
SALEM, OREGON**

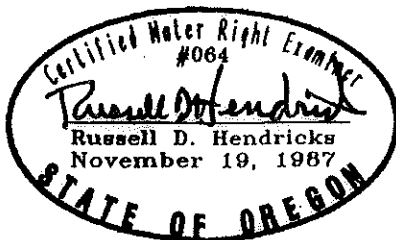

FINAL PROOF SURVEY
under
Appl. No. S-80144, Per. No. 52157
September 12, 2000

THIS MAP WAS PREPARED FOR THE PURPOSE OF
IDENTIFYING THE LOCATION OF A WATER RIGHT
ONLY AND IS NOT INTENDED TO PROVIDE LEGAL
DIMENSIONS OR LOCATION OF PROPERTY
OWNERSHIP LINES.