


Claim of Beneficial Use
Application G-13477, Permit G-12637

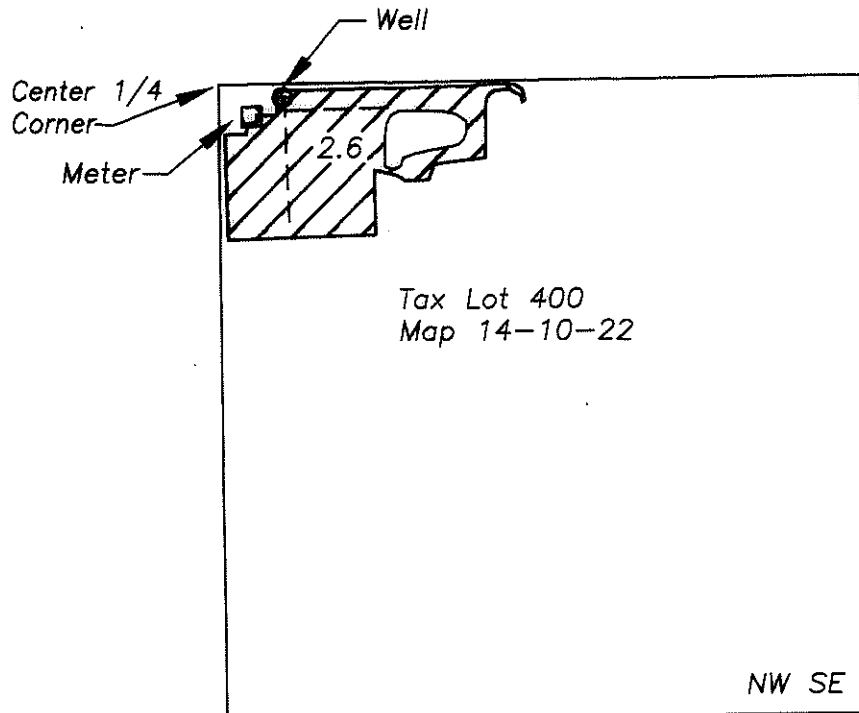


Section 22
T14S R10E WM
Deschutes Co. OR

400 0 400 800 1200



graphic scale 1"=400'

This map is for the purpose of identifying the location of the water right. It is not intended to provide legal dimensions or locations of property ownership lines.

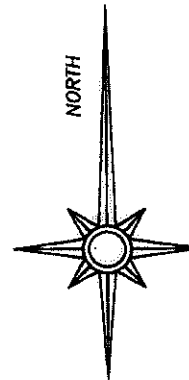


Renewal date: 6/30/2022

Point of Appropriation

80' South and 130' East from Center 1/4
Corner of Section 22



Water beneficially used under Permit
G-12637. (Priority date 7/29/1993)

 

Buried mainline



Well



Meter



1/16 Section lines

RECEIVED

SEP 29 2021

OWRD