

Claim of Beneficial Use


Application G-14379

Permit G-13145

Barbara and Darrell Pieper

Deschutes County, Oregon

964

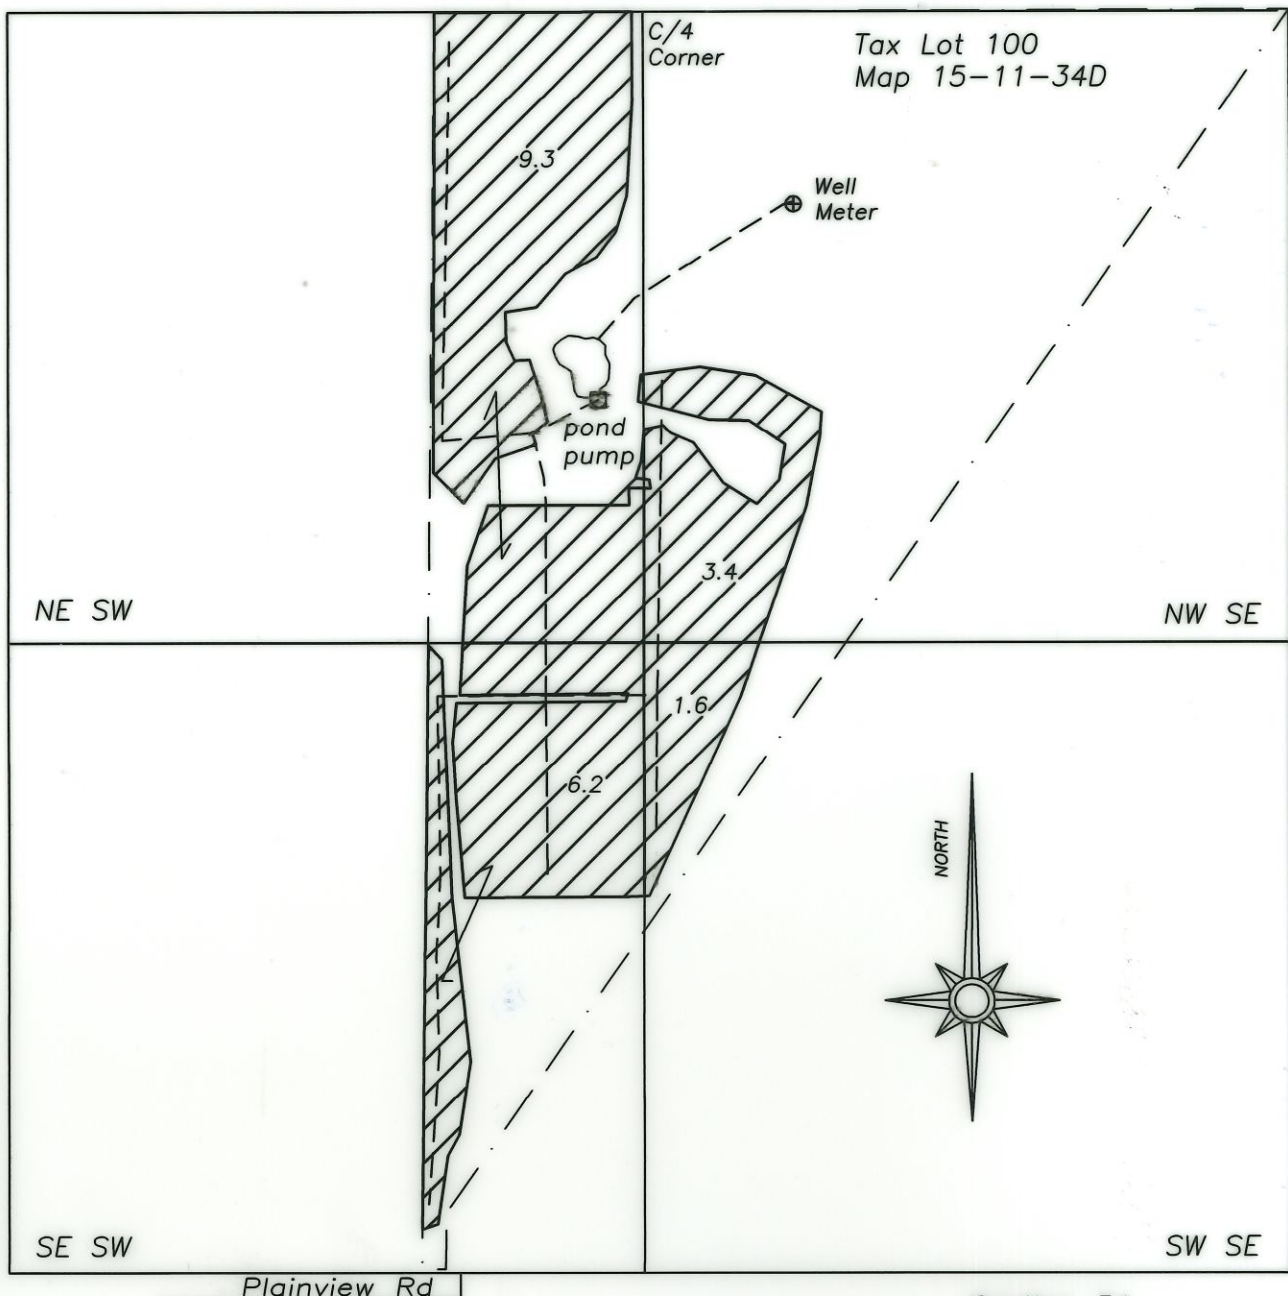

Water beneficially applied under Permit G-13145, priority date 9/23/1996



Tax lot boundary



Buried mainline




Well and meter



1/16 Section lines

Section 34
T15S, R11E, W.M.
Deschutes County, OR

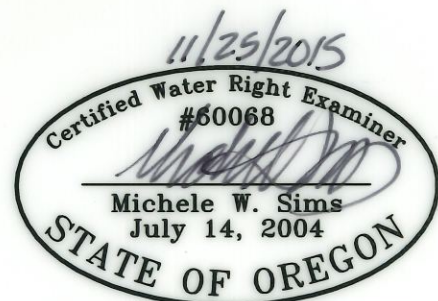

Renewal date: 6/30/2016



GRAPHIC SCALE - FEET

THIS MAP IS FOR THE PURPOSE OF IDENTIFYING THE LOCATION OF THE WATER RIGHT. IT IS NOT INTENDED TO PROVIDE LEGAL DIMENSIONS OR LOCATIONS OF PROPERTY OWNERSHIP LINES.

Michele W. Sims, Consultant, LLC, Sisters, OR 97759 541-408-4777

964