


SECTION

TOWNSHIP 4S, RANGE 3E, W. M.

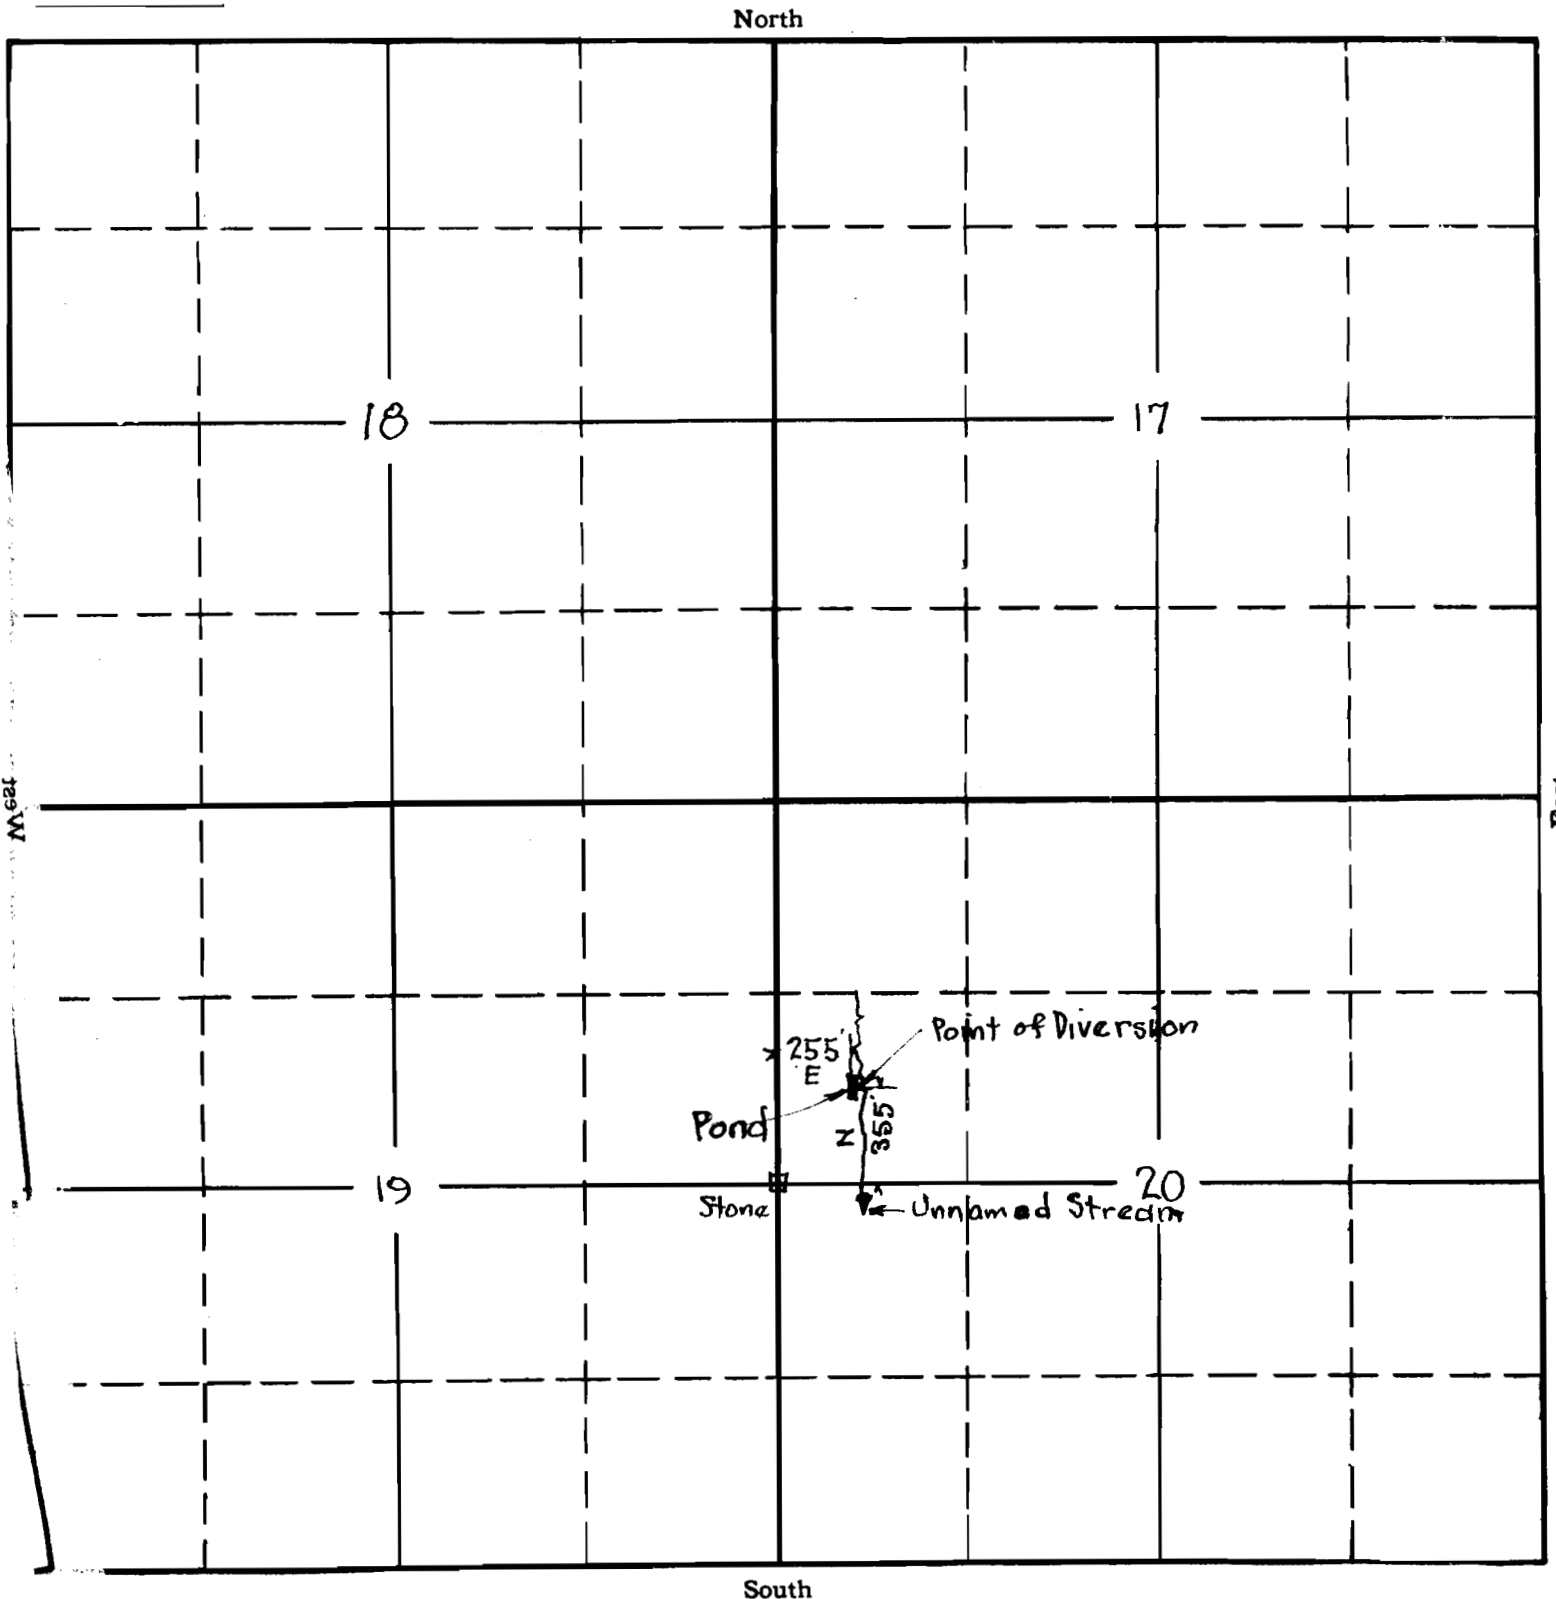

SALEM, OREGON

APPLICATION No. 13951

PERMIT No. 10037

FEB 11 1911

RECEIVED

SALEM, OREGON