

ELLEN WARD
2580 UPPER SMITH RIVER F
DRAIN, OR 97435

APPLICATION NO. S-86087

PERMIT NO. S-54174


SITUATED IN
SECTION 30, TOWNSHIP 21
RANGE 5 W, W.M.
DOUGLAS COUNTY OREGON

LEGEND

● UNNAMED SPRING
250' NORTH and 1370' WE
OF SOUTHEAST CORNER
SECTION 30, T21S R5W

○ PLACE OF USE

— -- PIPELINE

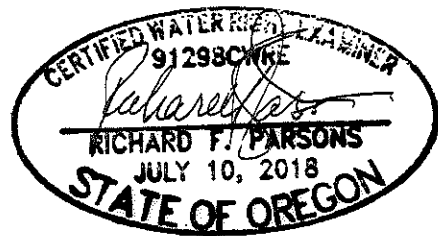

FITCH CREEK

30

29

TL 1200

METER AND
STORAGE TANK

31

SE CORNER
SECTION 30

32

RECEIVED
JUL 28 2022
OWNED

RECEIVED
AUG 12 2022
OWNED



0 300 600 ft

This map is not intended to provide
legal dimensions or locations of
property ownership lines

ParsonsWater Consulting LLC
rick.parsons@parsonwater.com
541.499.0257 303.667.5067