


Claim of Beneficial Use - Grewal

Transfer T-10515

Township 2S, Range 3E, W.M.

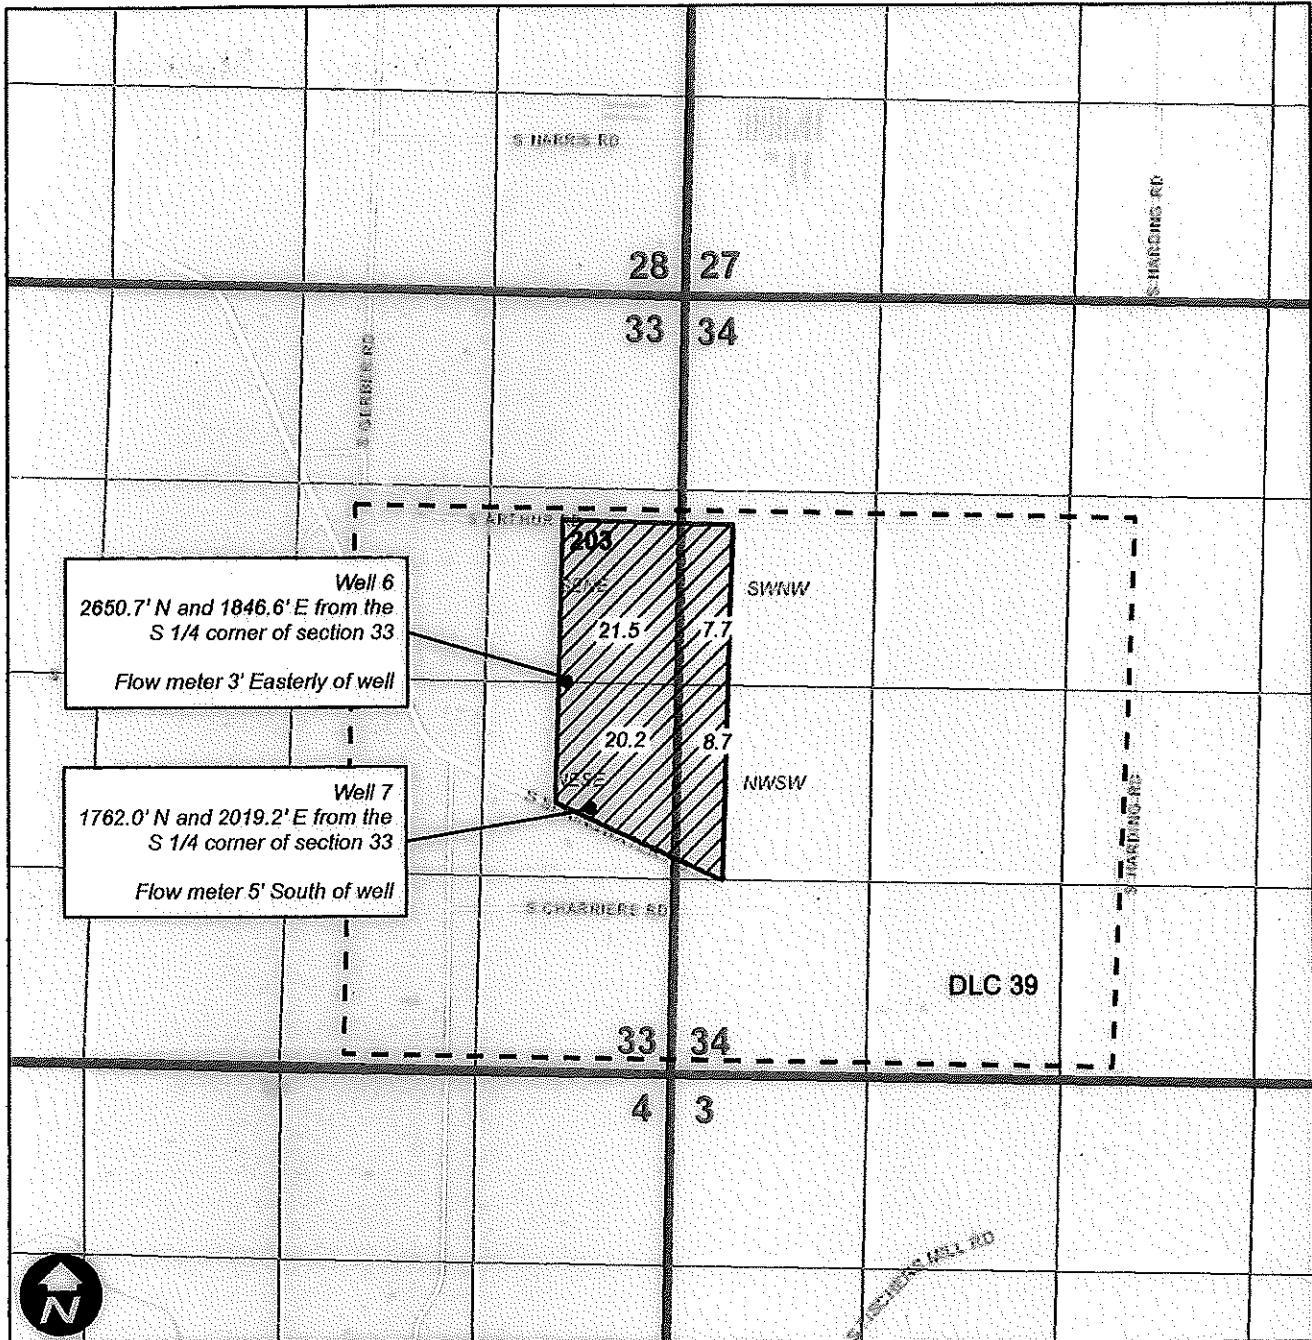

This map is not intended to provide legal dimensions or locations of property ownership lines.

0 660 1,320 2,640 Feet

Legend

POU Tax Lot DLC



EXPIRES: 12-31-2024