


**Pan-American Berry Growers  
APOA Transfer T-11434  
T6S, R2W, Sections 32-33**

Certified Water Rights Examiner  
#71101  
*REL*  
Robert E. Long Jr.  
May 15, 2002  
STATE OF OREGON

EXPIRATION DATE: **12.31.24**

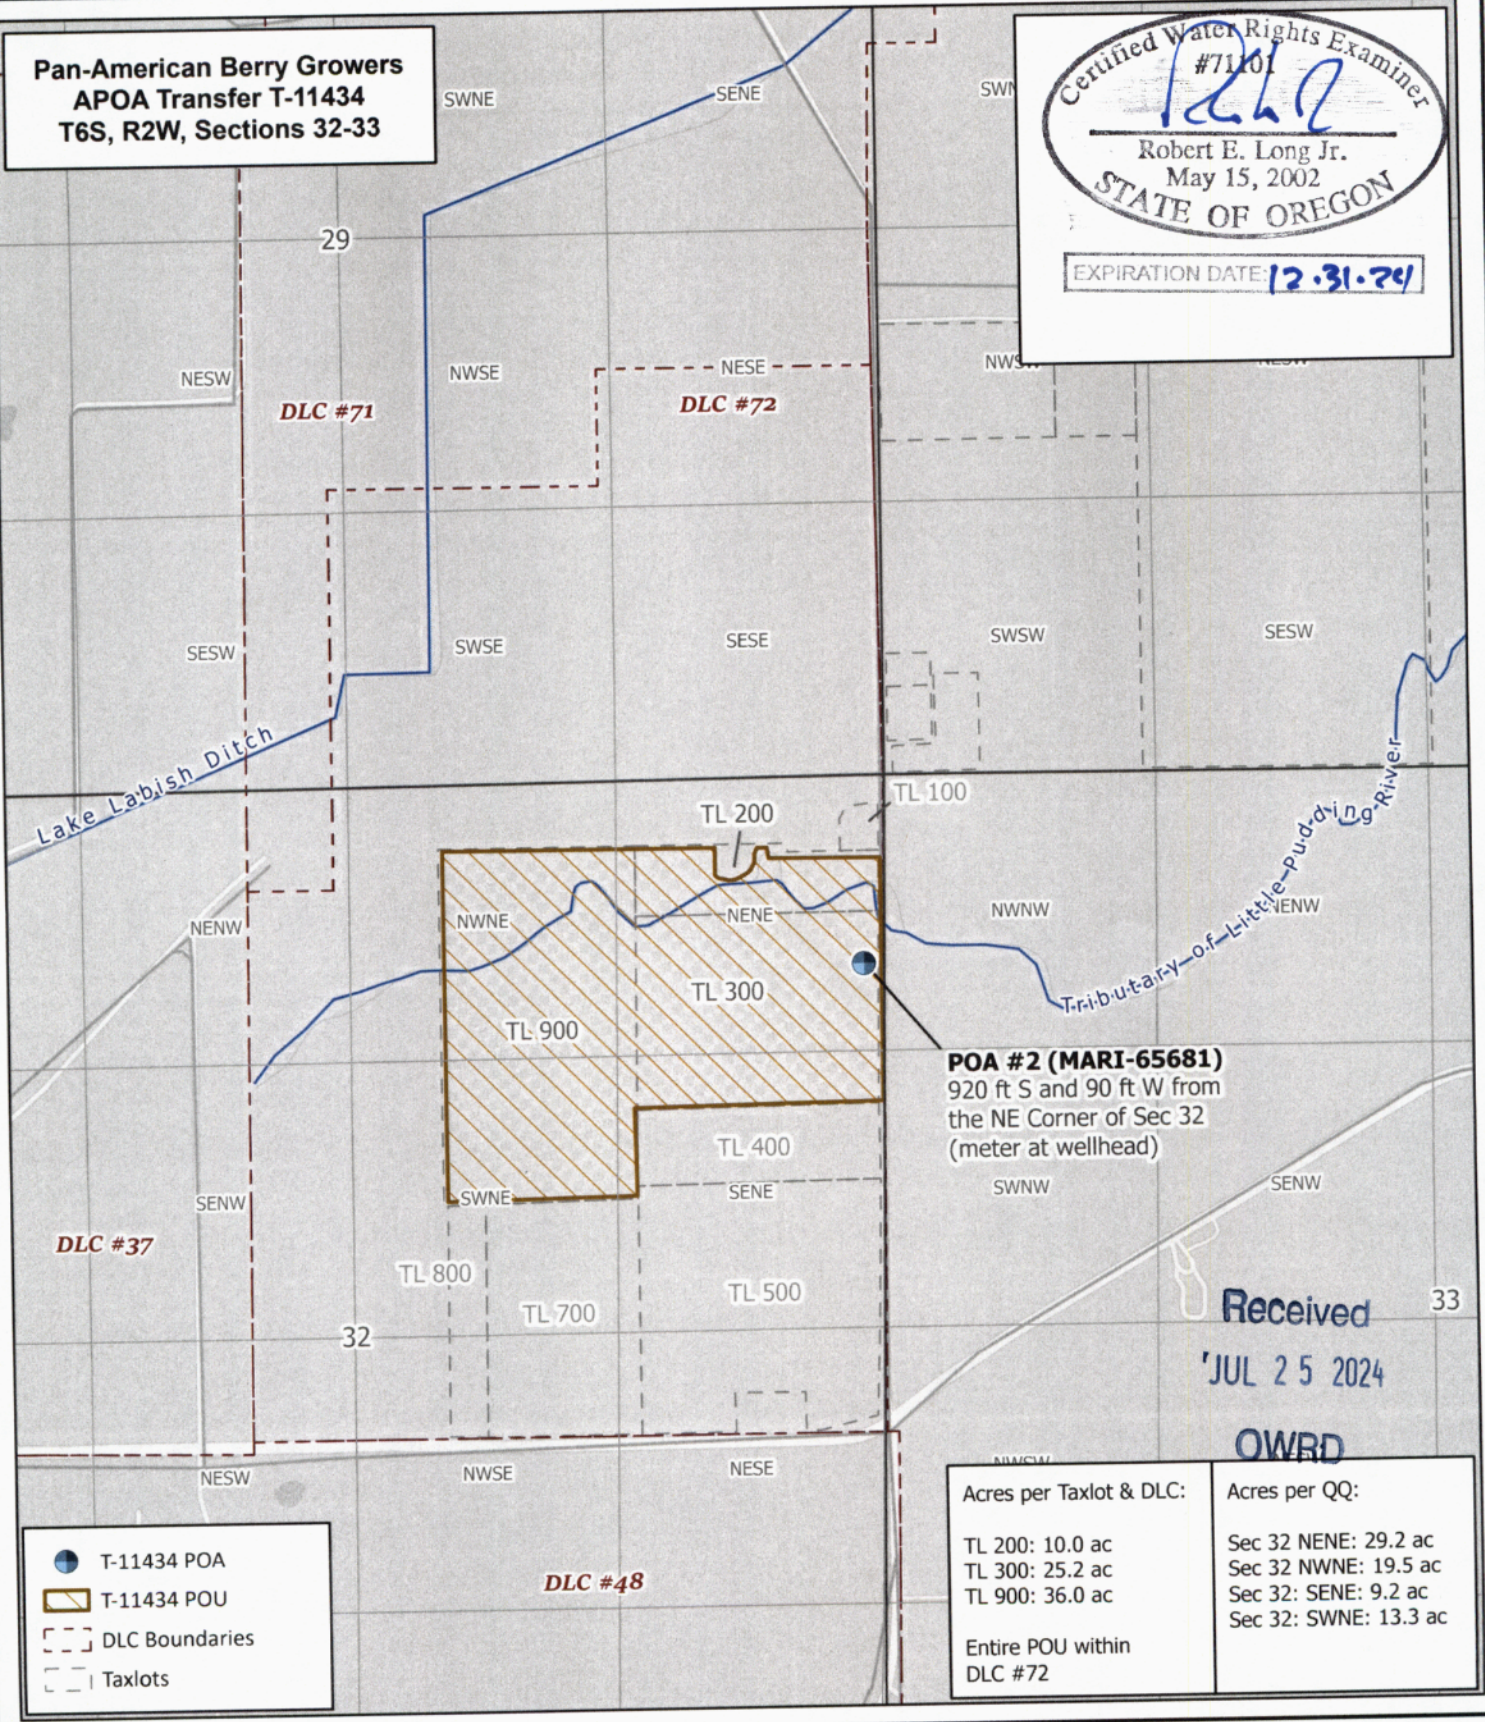

**POA #2 (MARI-65681)**  
920 ft S and 90 ft W from  
the NE Corner of Sec 32  
(meter at wellhead)

Received  
'JUL 25 2024

OWRD


Acres per Taxlot & DLC:	Acres per QQ:
TL 200: 10.0 ac	Sec 32 NENE: 29.2 ac
TL 300: 25.2 ac	Sec 32 NWNE: 19.5 ac
TL 900: 36.0 ac	Sec 32 SENE: 9.2 ac
Entire POU within DLC #72	Sec 32 SWNE: 13.3 ac

- T-11434 POA
- T-11434 POU
- DLC Boundaries
- Taxlots



311 B Avenue, Suite P  
Lake Oswego, OR 97034  
(503) 954-1326

This map is not intended to provide  
legal dimensions or locations  
of property ownership lines.

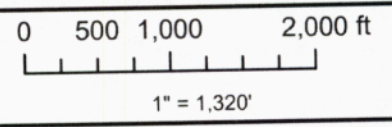

1	DATE	AUTH	DRAFT
No.	Date	By	Revisions

Proj#: 2311001  
Pan-America  
Pan-American Berry Growers  
6826 55th Avenue NE  
Salem, OR 97035

