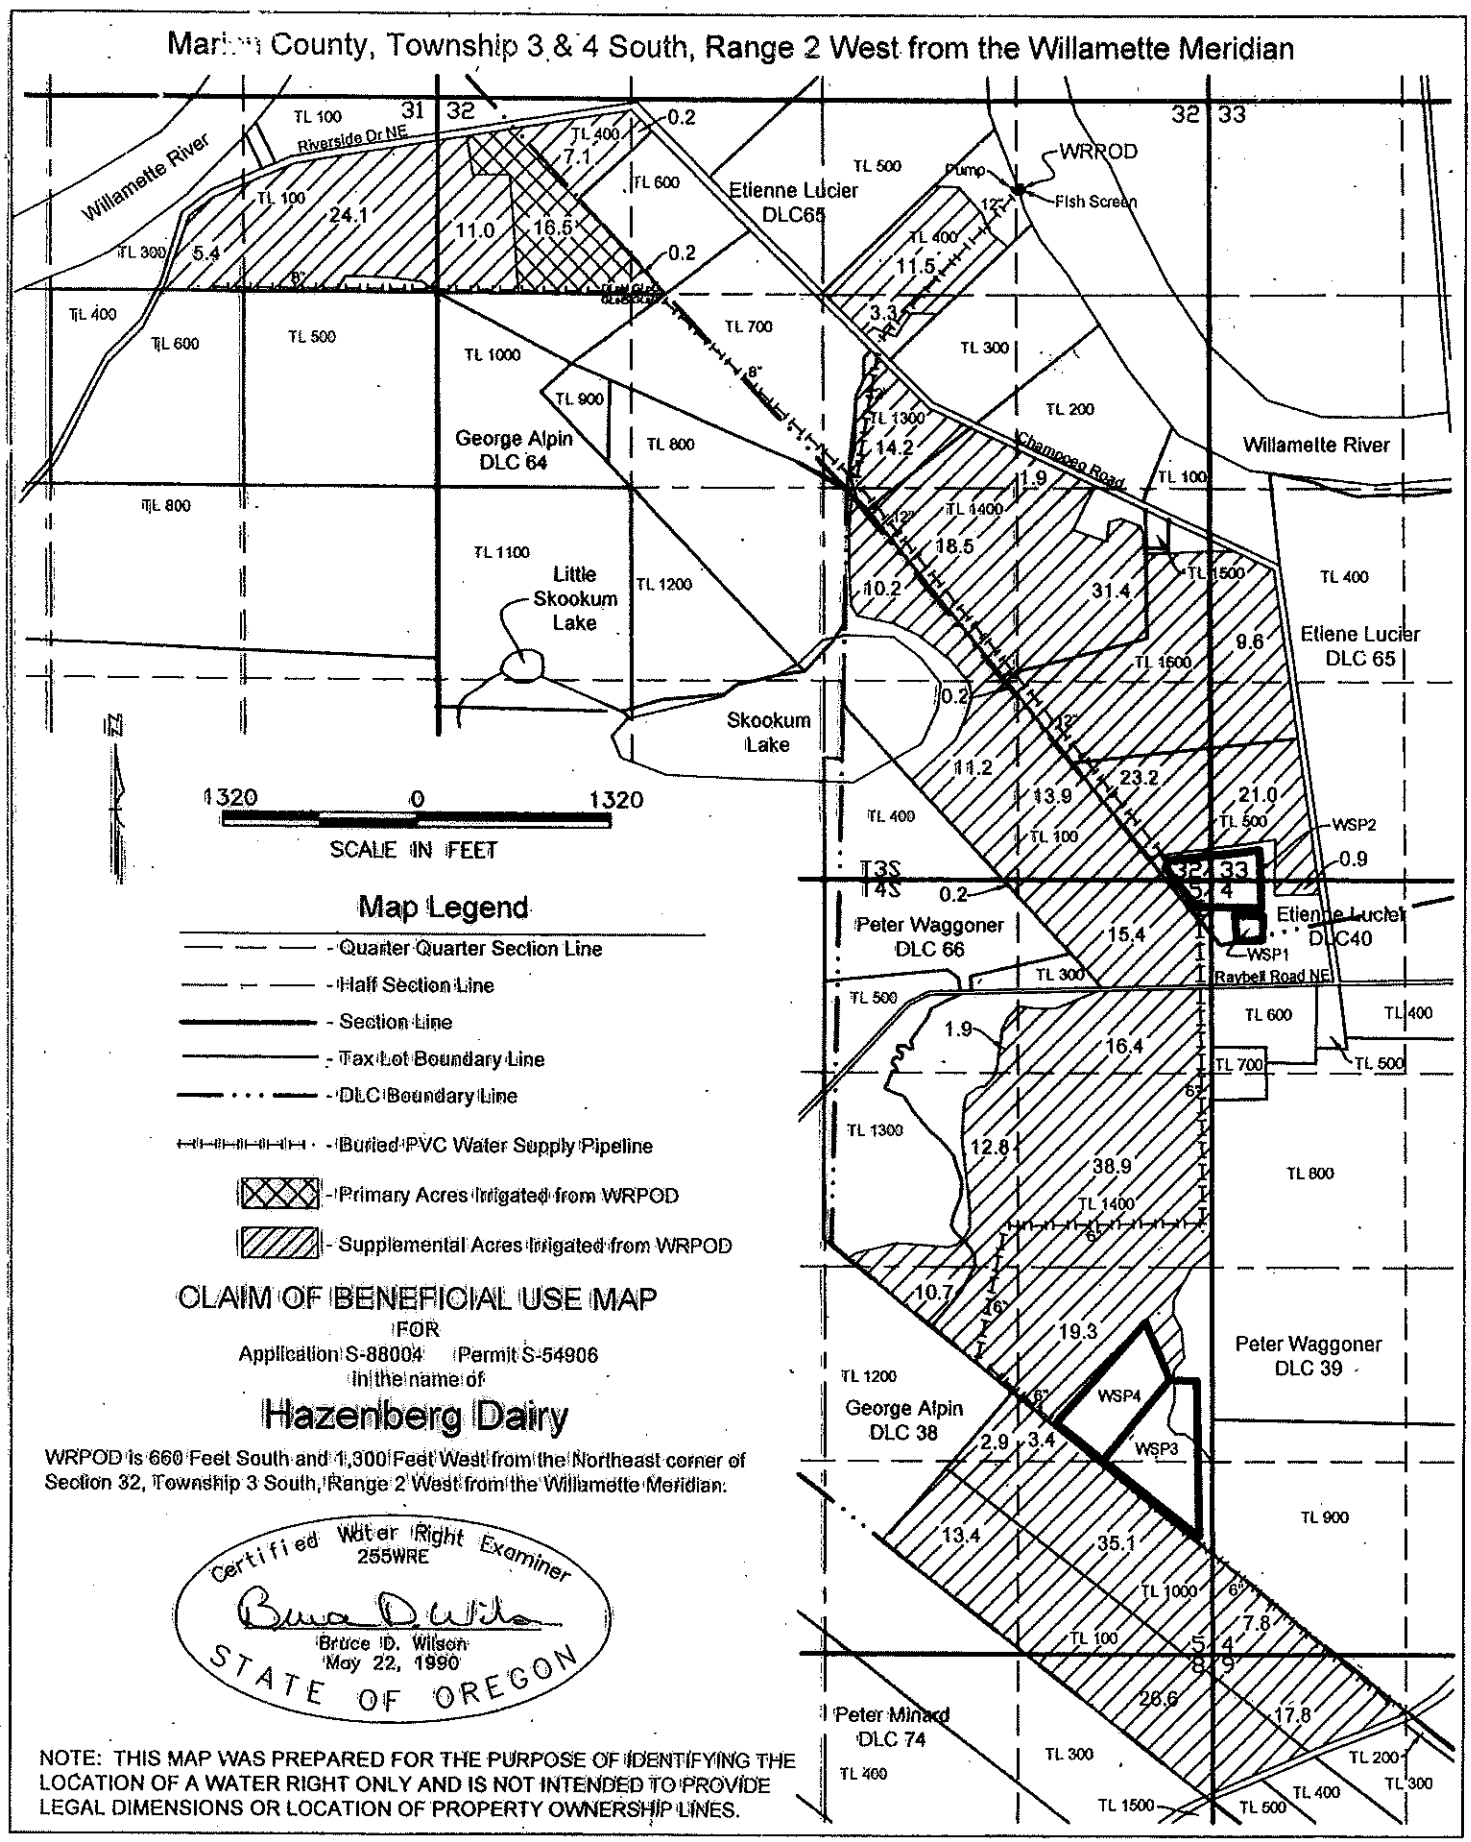

CLAIM OF BENEFICIAL USE MAP

FOR

Application S-88004 Permit S-54906

In the name of

Hazenberg Dairy

WRPOD is 660 Feet South and 1,300 Feet West from the Northeast corner of Section 32, Township 3 South, Range 2 West from the Willamette Meridian.

Certified Water Right Examiner
255WRE
Bruce D. Wilson
May 22, 1990
STATE OF OREGON

NOTE: THIS MAP WAS PREPARED FOR THE PURPOSE OF IDENTIFYING THE LOCATION OF A WATER RIGHT ONLY AND IS NOT INTENDED TO PROVIDE LEGAL DIMENSIONS OR LOCATION OF PROPERTY OWNERSHIP LINES.