

CLAIM OF BENEFICIAL USE MAP

LOCATED IN: TOWNSHIP 1 NORTH RANGE 3 WEST SECTION 7 TAX LOT 1200 AND
SECTION 18 TAX LOT 100, W.M. WASHINGTON COUNTY, OREGON.
SITE ADDRESS: 41200 NW REILING ROAD, FOREST GROVE, OR, 97116

IN THE NAME OF
GREEN RIVER HOLDINGS, LLC
INSPECTED ON 11/23/21
by WILLIAM L. FLATZ, CWRE

Application No. S-64671
Permit No. S-53611

LEGEND

- AREA OF NURSERY USE, 43.9 ACRES
- D.L.C. LINES
- PROPERTY LINES
- CREEK
- SECTION LINES
- SECTION 1/4-1/4 LINES
- BUILDINGS
- GOVERNMENT CORNER


NOTES

- A. RESERVOIR, CERTIFICATE 26477, PRIORITY DATE DEC. 8, 1954
- B. POND 1, 40 HP PUMP WITH ACTIVE FISH SCREEN AND DEDICATED ELECTRICAL METER, LOCATED 220' N AND 915' E FROM THE NW CORNER OF DLC 43.
- C. RECOVERY POND, COLLECTS RUNOFF FROM NORTH NURSERY.
- D. PUMP HOUSE AT RECOVERY POND, 30 HP PUMP TO BE USED TO COLLECT RUNOFF FROM NORTH NURSERY.

NURSERY USE ACRES SUMMARY PERMITS S-53611

T	R	M	SEC	CO	Lot	DLC	Use	Acres
1N	3W	W.M.	7	NW/SE	N/A		Nursery	7.3
1N	2W	W.M.	7	SW/SE	N/A		Nursery	19.7
1N	3W	W.M.	18	NW/NE		43	Nursery	16.7
1N	3W	W.M.	18	NE/NE		43	Nursery	0.2

Total Acres = 43.9

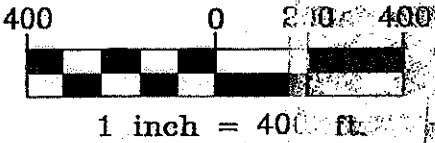

EXAMINER'S DISCLAIMER STATEMENT
The preparation of this map was for the purpose of identifying the location of the Water Right only and has no intent to provide dimensions or location of property ownership lines.

Stuntzner
Engineering & Forestry, LLC

MAP BASED ON
TAX MAPS 1N-3W-7-18
AERPHOTO: 2006 GOOGLE
SEE JOB# 112-061
REVISED: 12-17-21
DRAWING NAME:
RIO VERDE CORN MAP

